
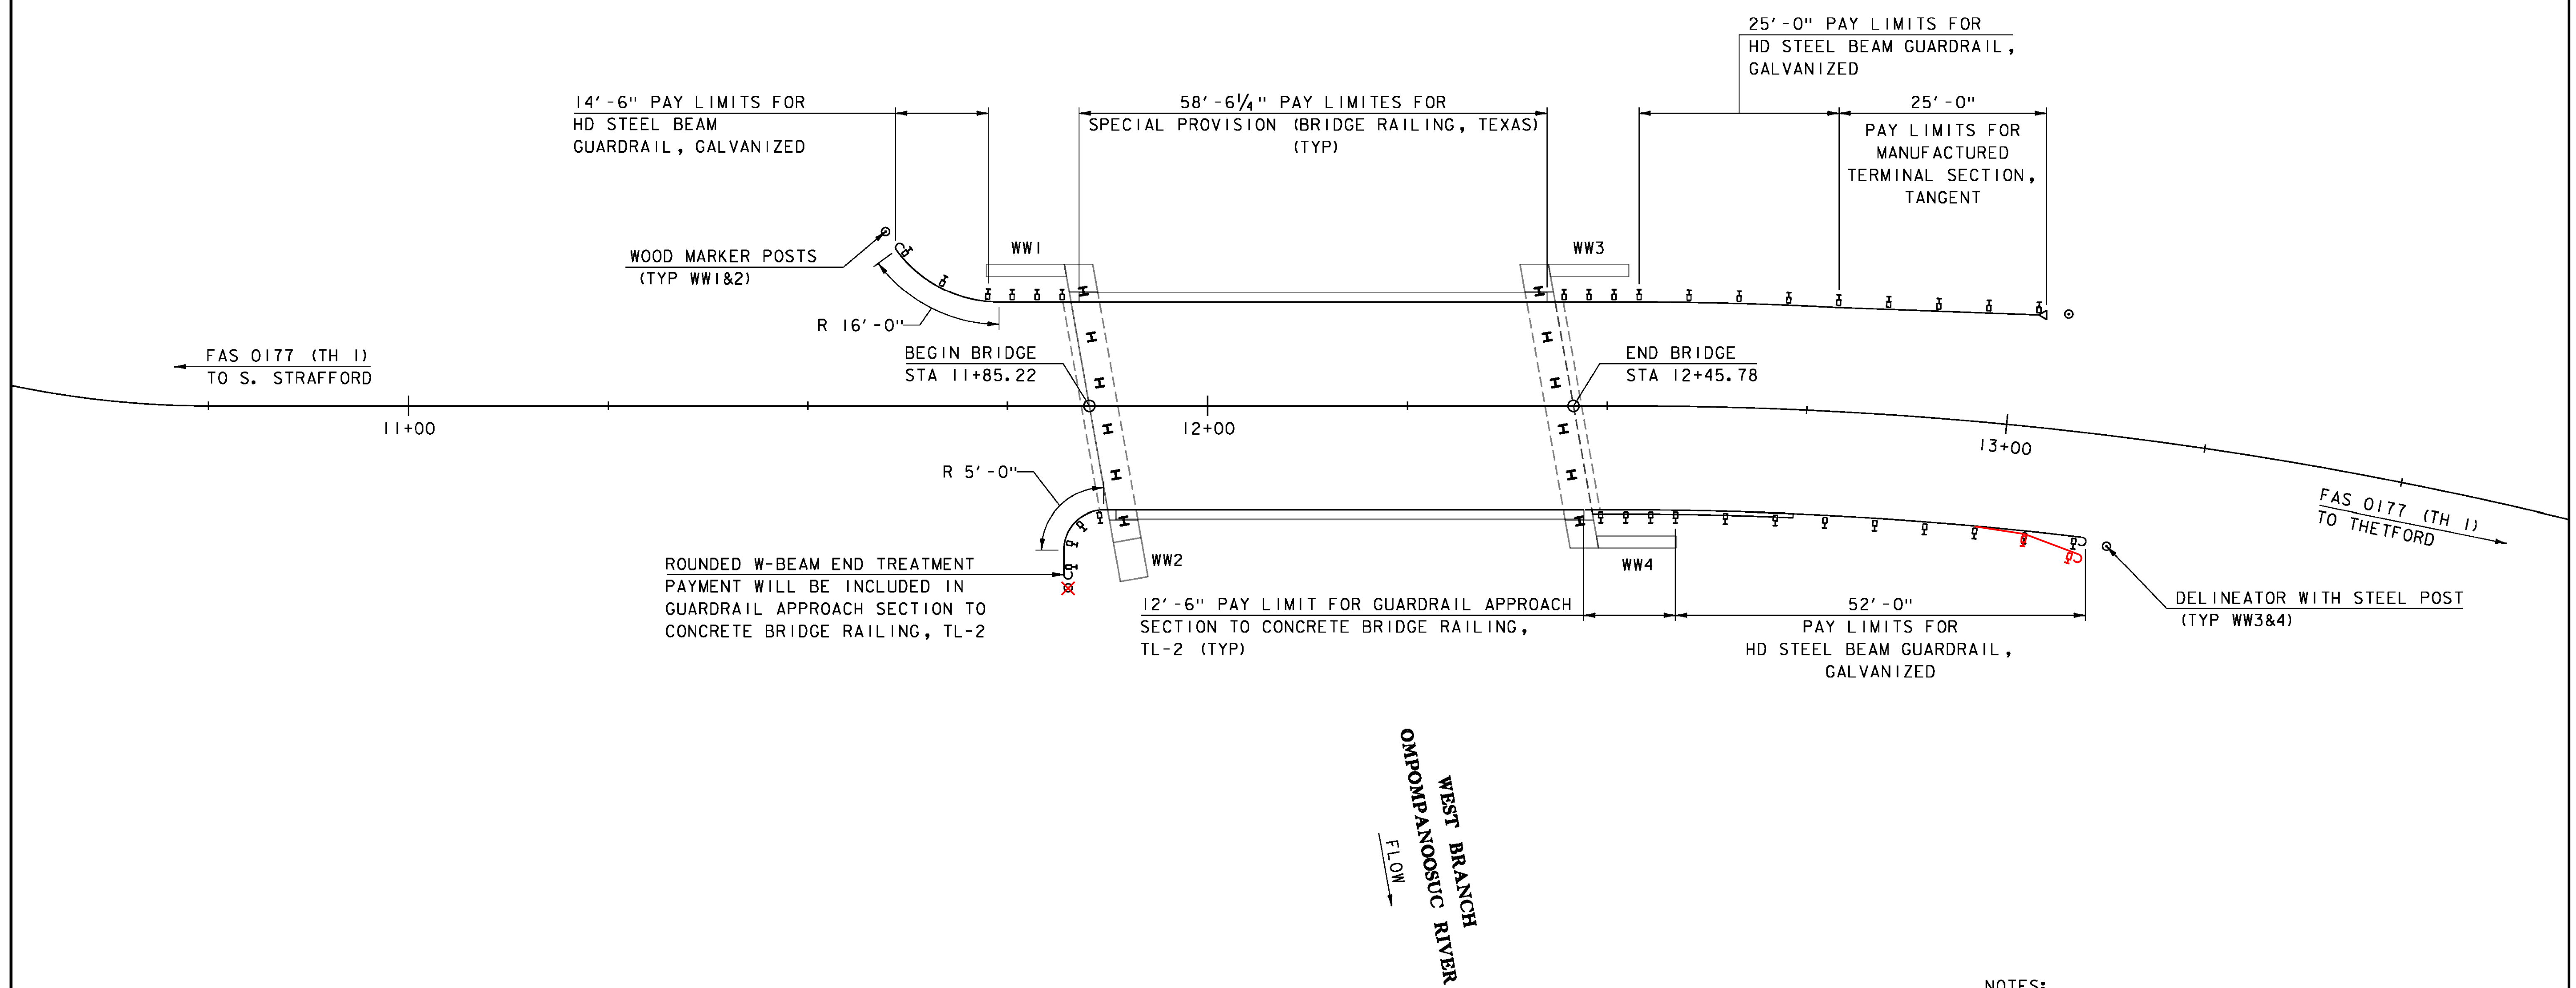


WOOD MARKER POSTS
 STA 11+59 LT
~~STA 11+82 RT~~


DELINEATOR WITH STEEL POST
 STA 13+20 LT (BLUE)
 STA 13+35 RT (GREEN)

ANCHOR FOR STEEL BEAM GUARDRAIL
 STA 12+97 RT

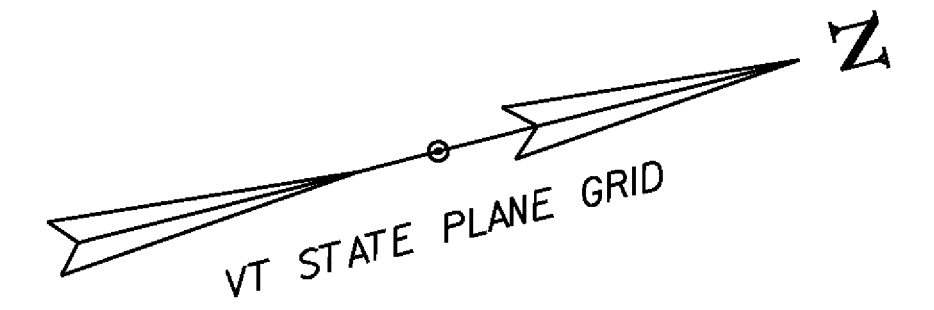

NOTES:
 1) SEE STANDARDS G-1, G-1D, G-4, G-19, T-40, T-45, AND SHEETS 22-23 FOR ADDITIONAL DETAILS.

RAIL LAYOUT SHEET

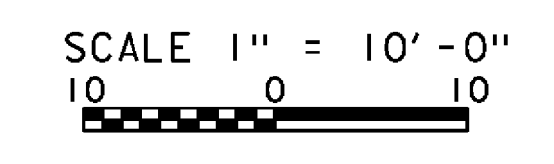

PROJECT NAME:	STRAFFORD
PROJECT NUMBER:	BF 0177(10)
FILE NAME:	s13J088rail.dgn
PROJECT LEADER:	K. HIGGINS
DESIGNED BY:	J. GRIGAS
RAIL LAYOUT SHEET	
PLOT DATE:	03-OCT-2016
DRAWN BY:	S. COLEY
CHECKED BY:	J. GRIGAS
SHEET	21 OF 52