


L	58' - 0"
W1	9' - 4 3/4"
W2	8' - 7 3/4"
W3	9' - 5 5/8"
W4	9' - 1 1/8"
S1	5' - 0"
S2	4' - 4 3/4"
D1	14' - 8"
D2	6' - 6"

SKEW	A1	80°
	A2	80°

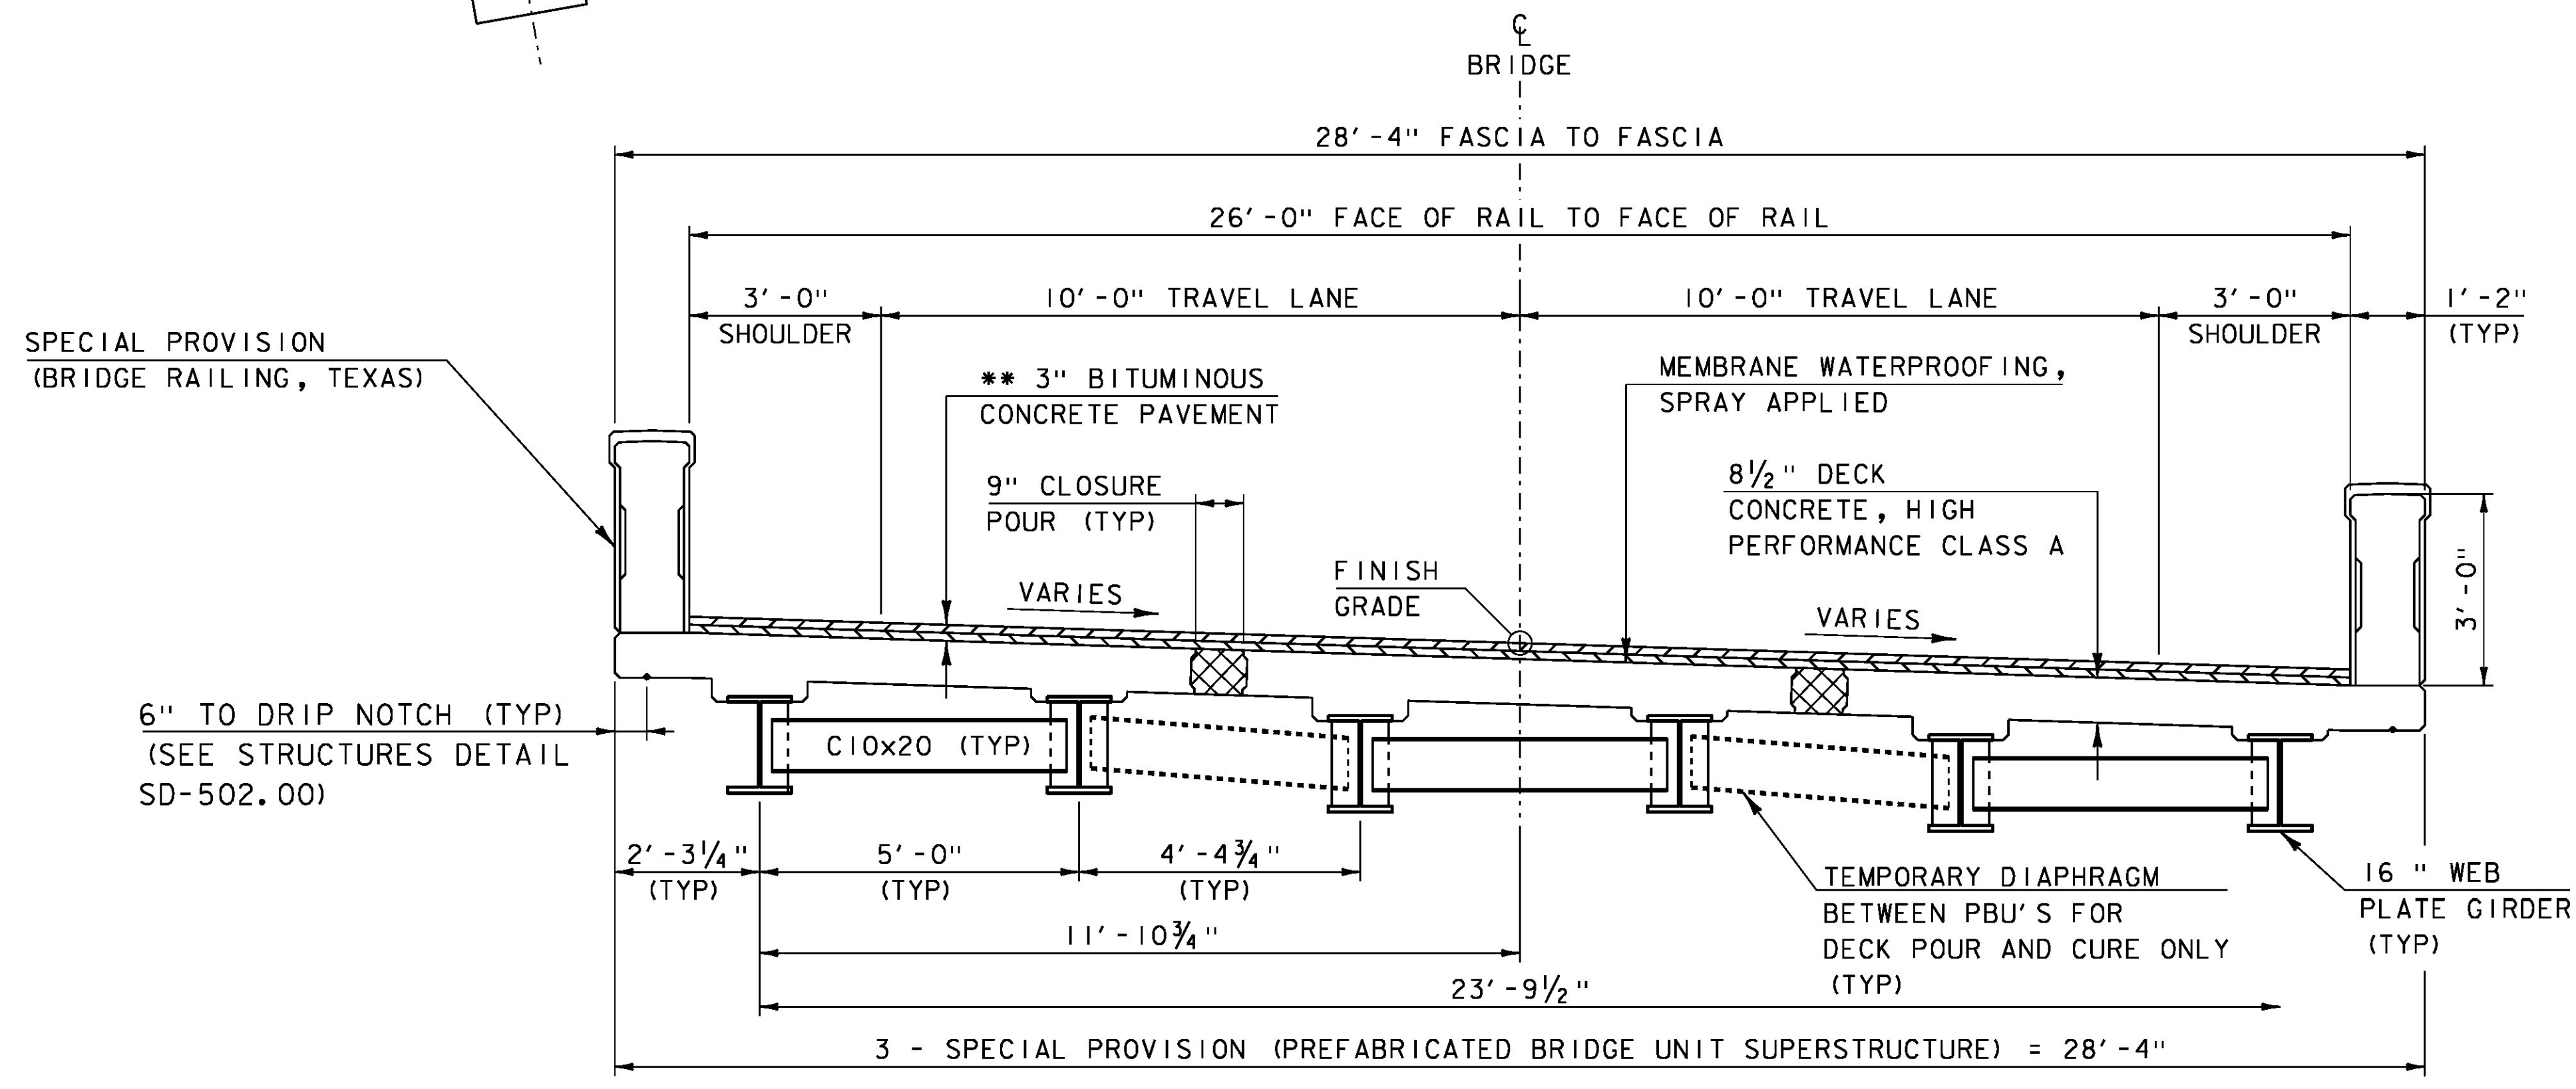

- SPECIAL PROVISION (HIGH PERFORMANCE CONCRETE, RAPID SET)
- SPECIAL PROVISION (BITUMINOUS CONCRETE PAVEMENT, TYPE 1VB) *

NOTE:
*BITUMINOUS CONCRETE PAVEMENT IN DECK PLAN VIEW IS OMITTED FOR CLARITY

PROJECT NAME:	STRAFFORD
PROJECT NUMBER:	BF 0177(10)
FILE NAME:	sl3j088sup.dgn
PROJECT LEADER:	K. HIGGINS
DESIGNED BY:	T. MATTHEWS
FRAMING PLAN SHEET	
PLOT DATE:	31-AUG-2016
DRAWN BY:	T. MATTHEWS
CHECKED BY:	J. GRIGAS
SHEET	24 OF 52

** 1/2" SPECIAL PROVISION (BITUMINOUS CONCRETE PAVEMENT TYPE 1VB), OVER
1/2" SPECIAL PROVISION (BITUMINOUS CONCRETE PAVEMENT TYPE 1VB)