


ABUTMENT ELEVATIONS

	AB I
ANGLE "A1"	80°
ELEV "A"	889.25
ELEV "B"	888.50
ELEV "C"	886.25
ELEV "D"	885.61
ELEV "E"	885.33
ELEV "F"	885.05
ELEV "G"	876.25

ABUTMENT I PLAN (PCU I)
SCALE 1/2" = 1'-0"

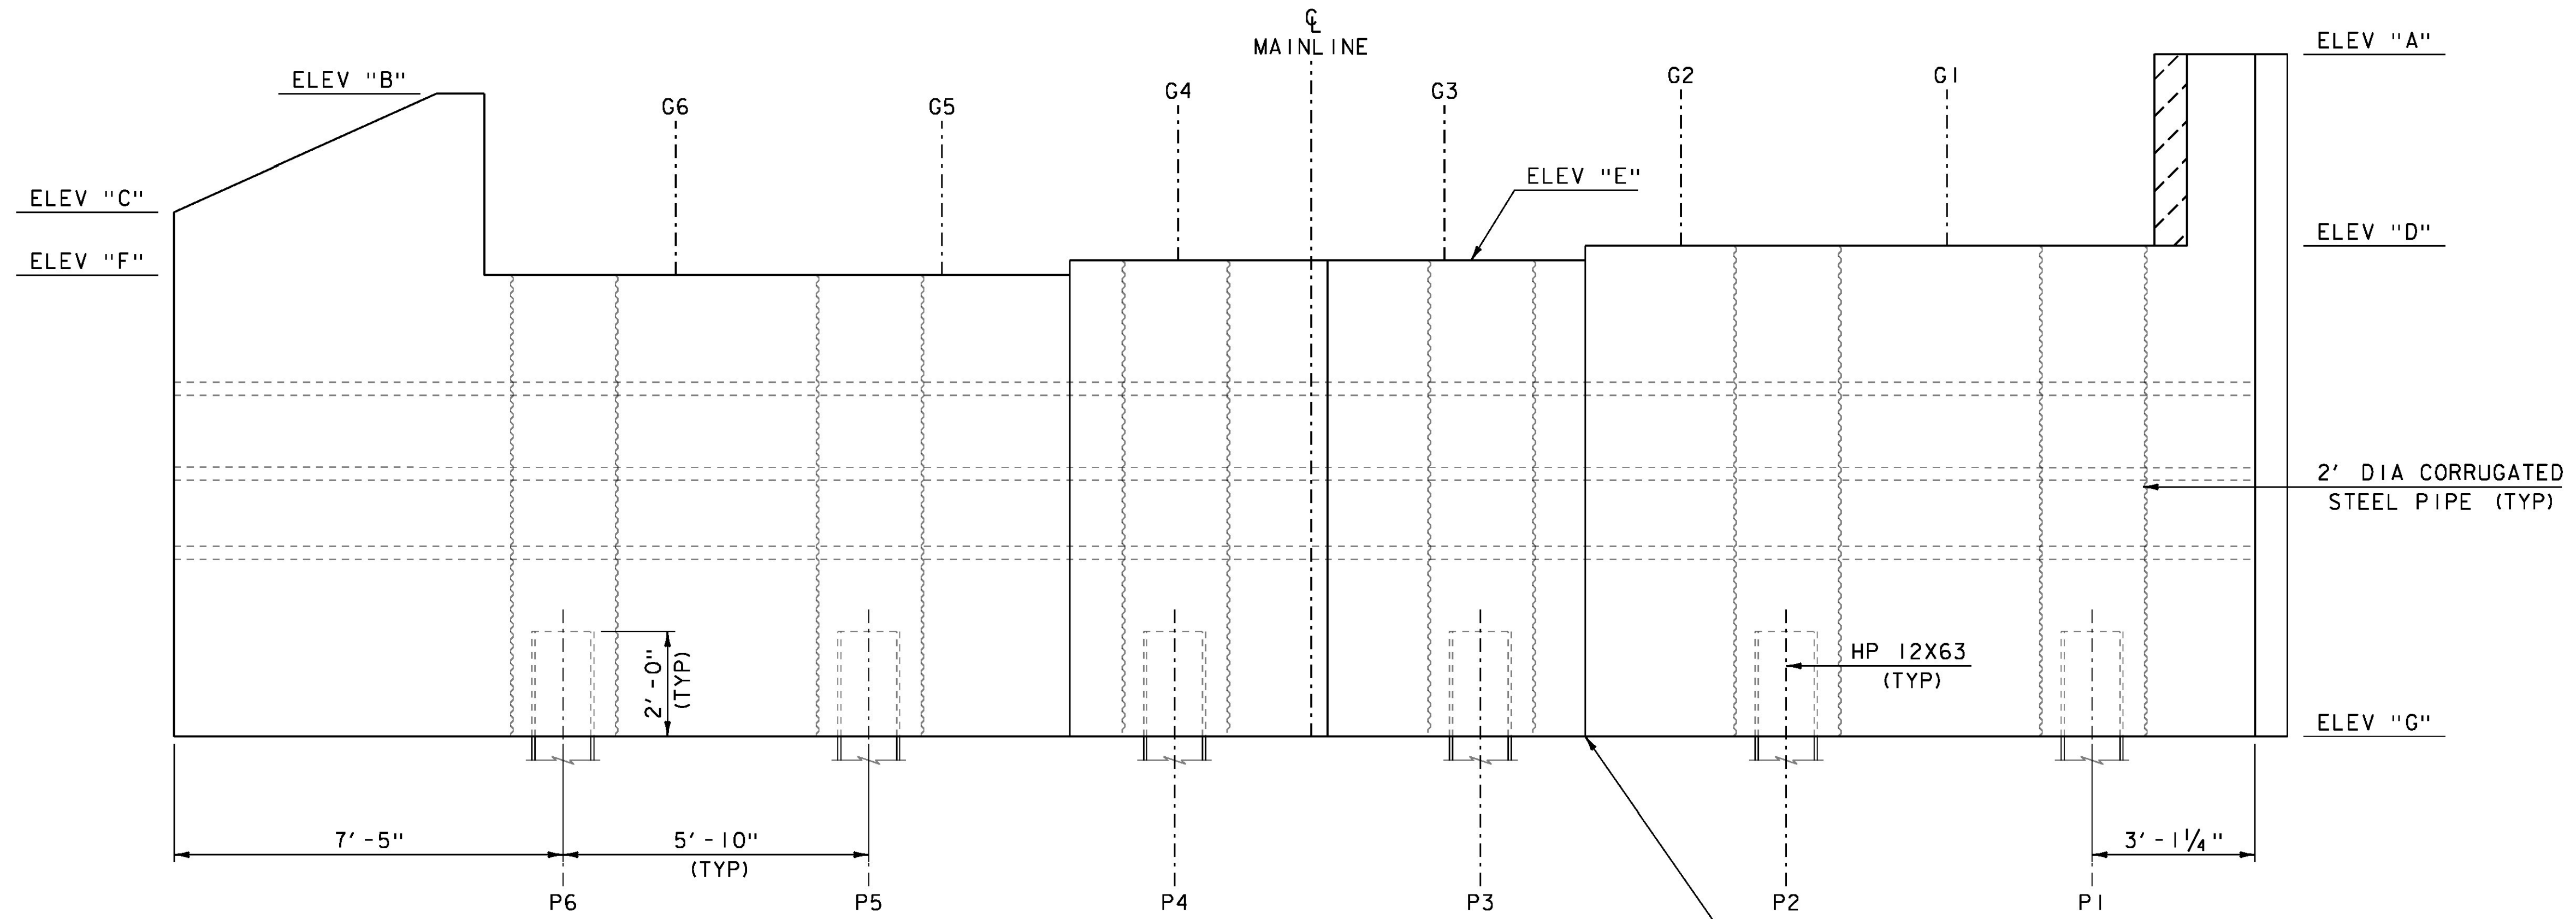

ABUTMENT I ELEVATION (PCU I)
SCALE 1/2" = 1'-0"

PROJECT NAME:	STRAFFORD
PROJECT NUMBER:	BF 0177(10)
FILE NAME:	sl3j088subl.dgn
PROJECT LEADER:	K. HIGGINS
DESIGNED BY:	J. GRIGAS
ABUTMENT I PLAN SHEET	
PLOT DATE:	31-AUG-2016
DRAWN BY:	J. GRIGAS
CHECKED BY:	G. LAROCHE
SHEET	29 OF 52