


ABUTMENT 2 REINFORCING PLAN (PCU 1)

SCALE 1/2" = 1'-0

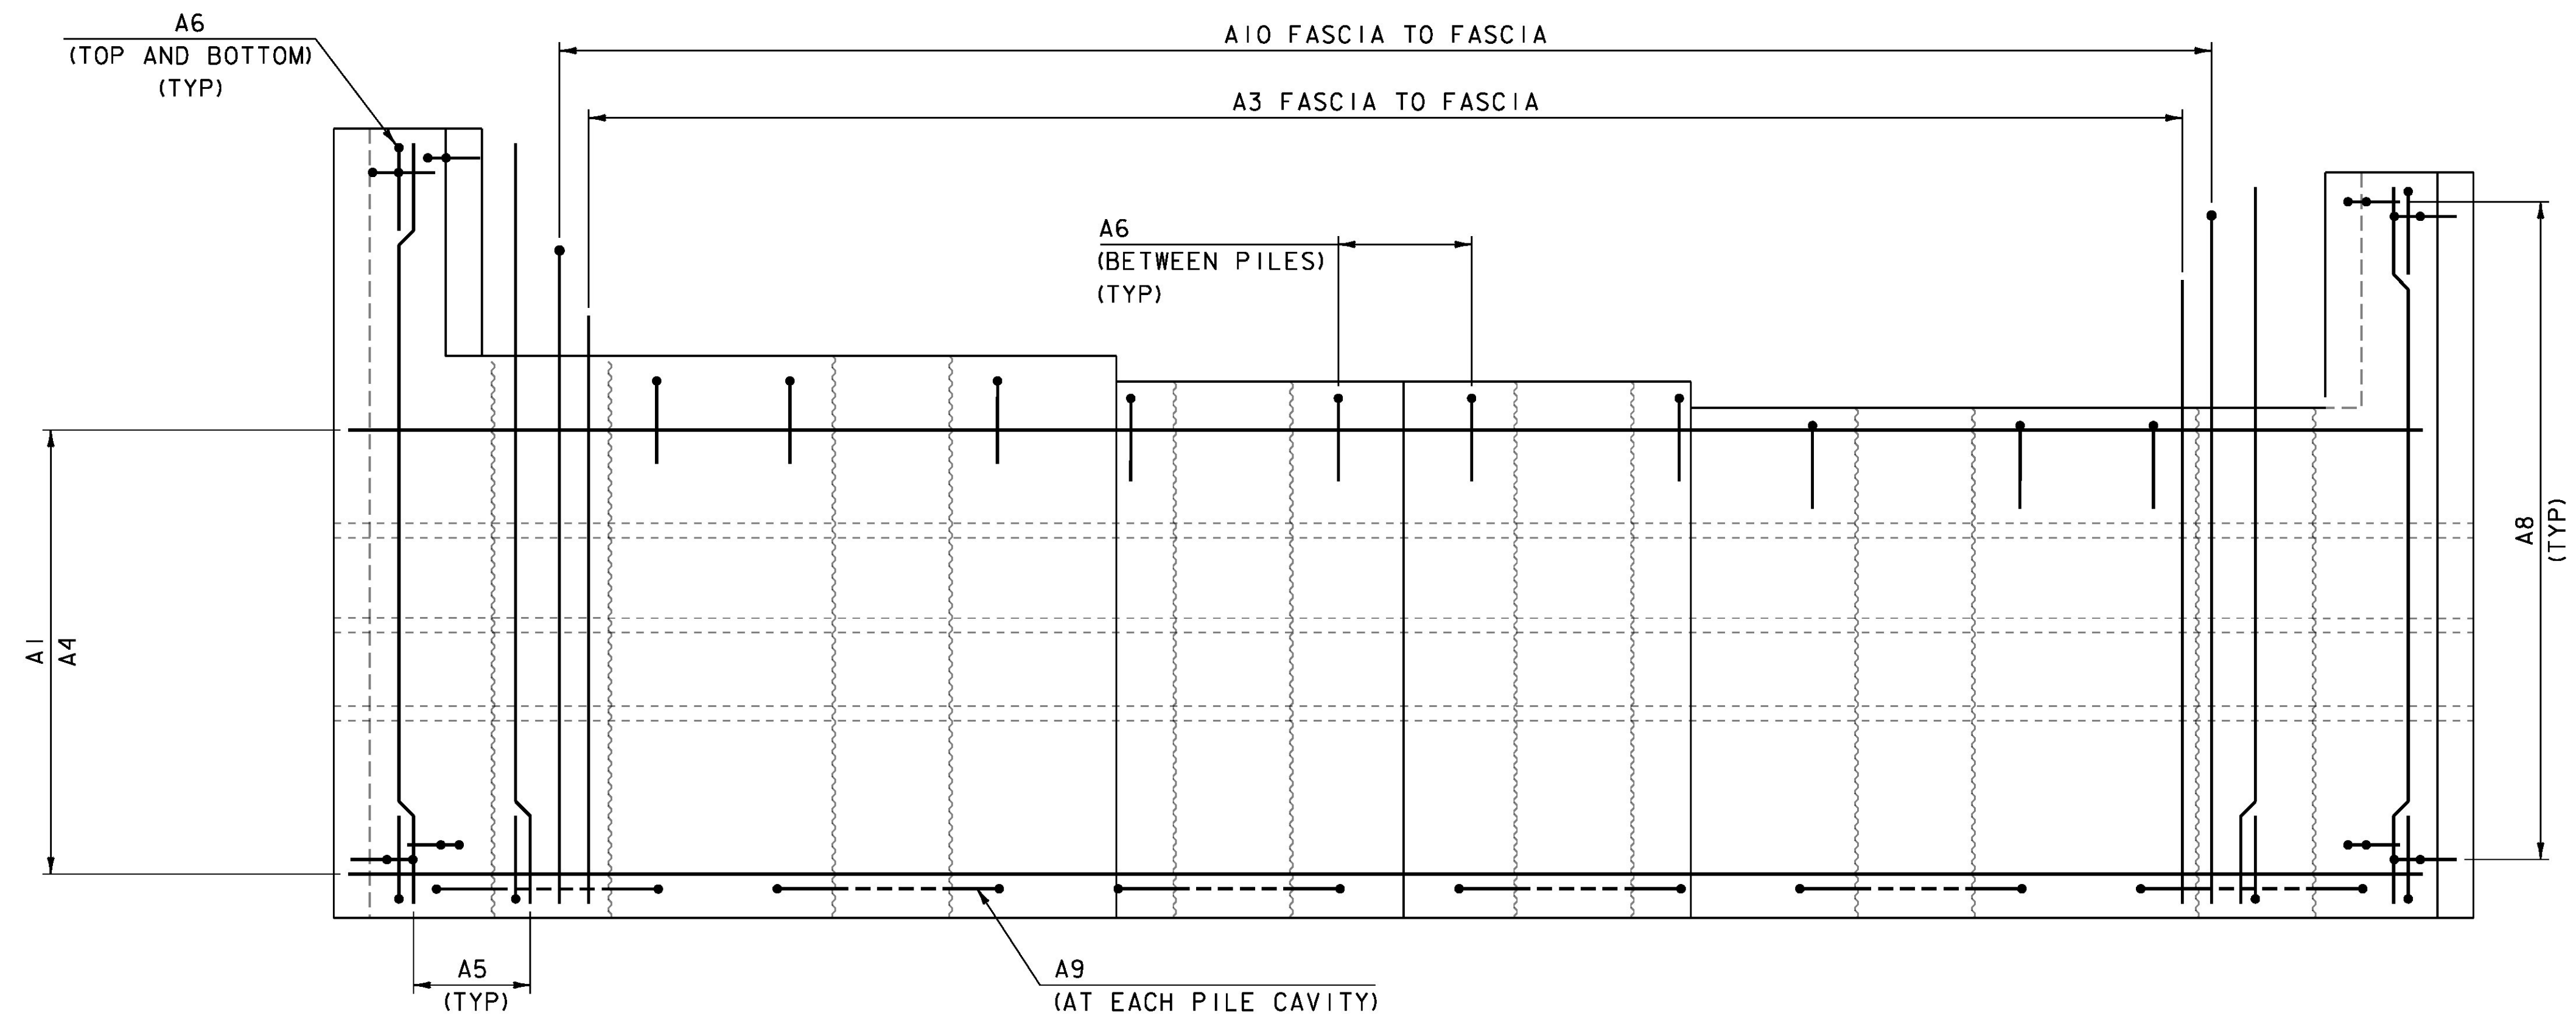

ABUTMENT 2 REINFORCING ELEVATION (PCU 2)

SCALE 1/2" = 1'-0

PROJECT NAME: STRAFFORD	PLOT DATE: 31-AUG-2016
PROJECT NUMBER: BF 0177(10)	DRAWN BY: J. GRIGAS
FILE NAME: s13j088sub2.dgn	CHECKED BY: G. LAROCHE
PROJECT LEADER: K. HIGGINS	SHEET 32 OF 52
DESIGNED BY: J. GRIGAS	
ABUTMENT 2 REINFORCING SHEET	