




10+25
BEGIN APPROACH

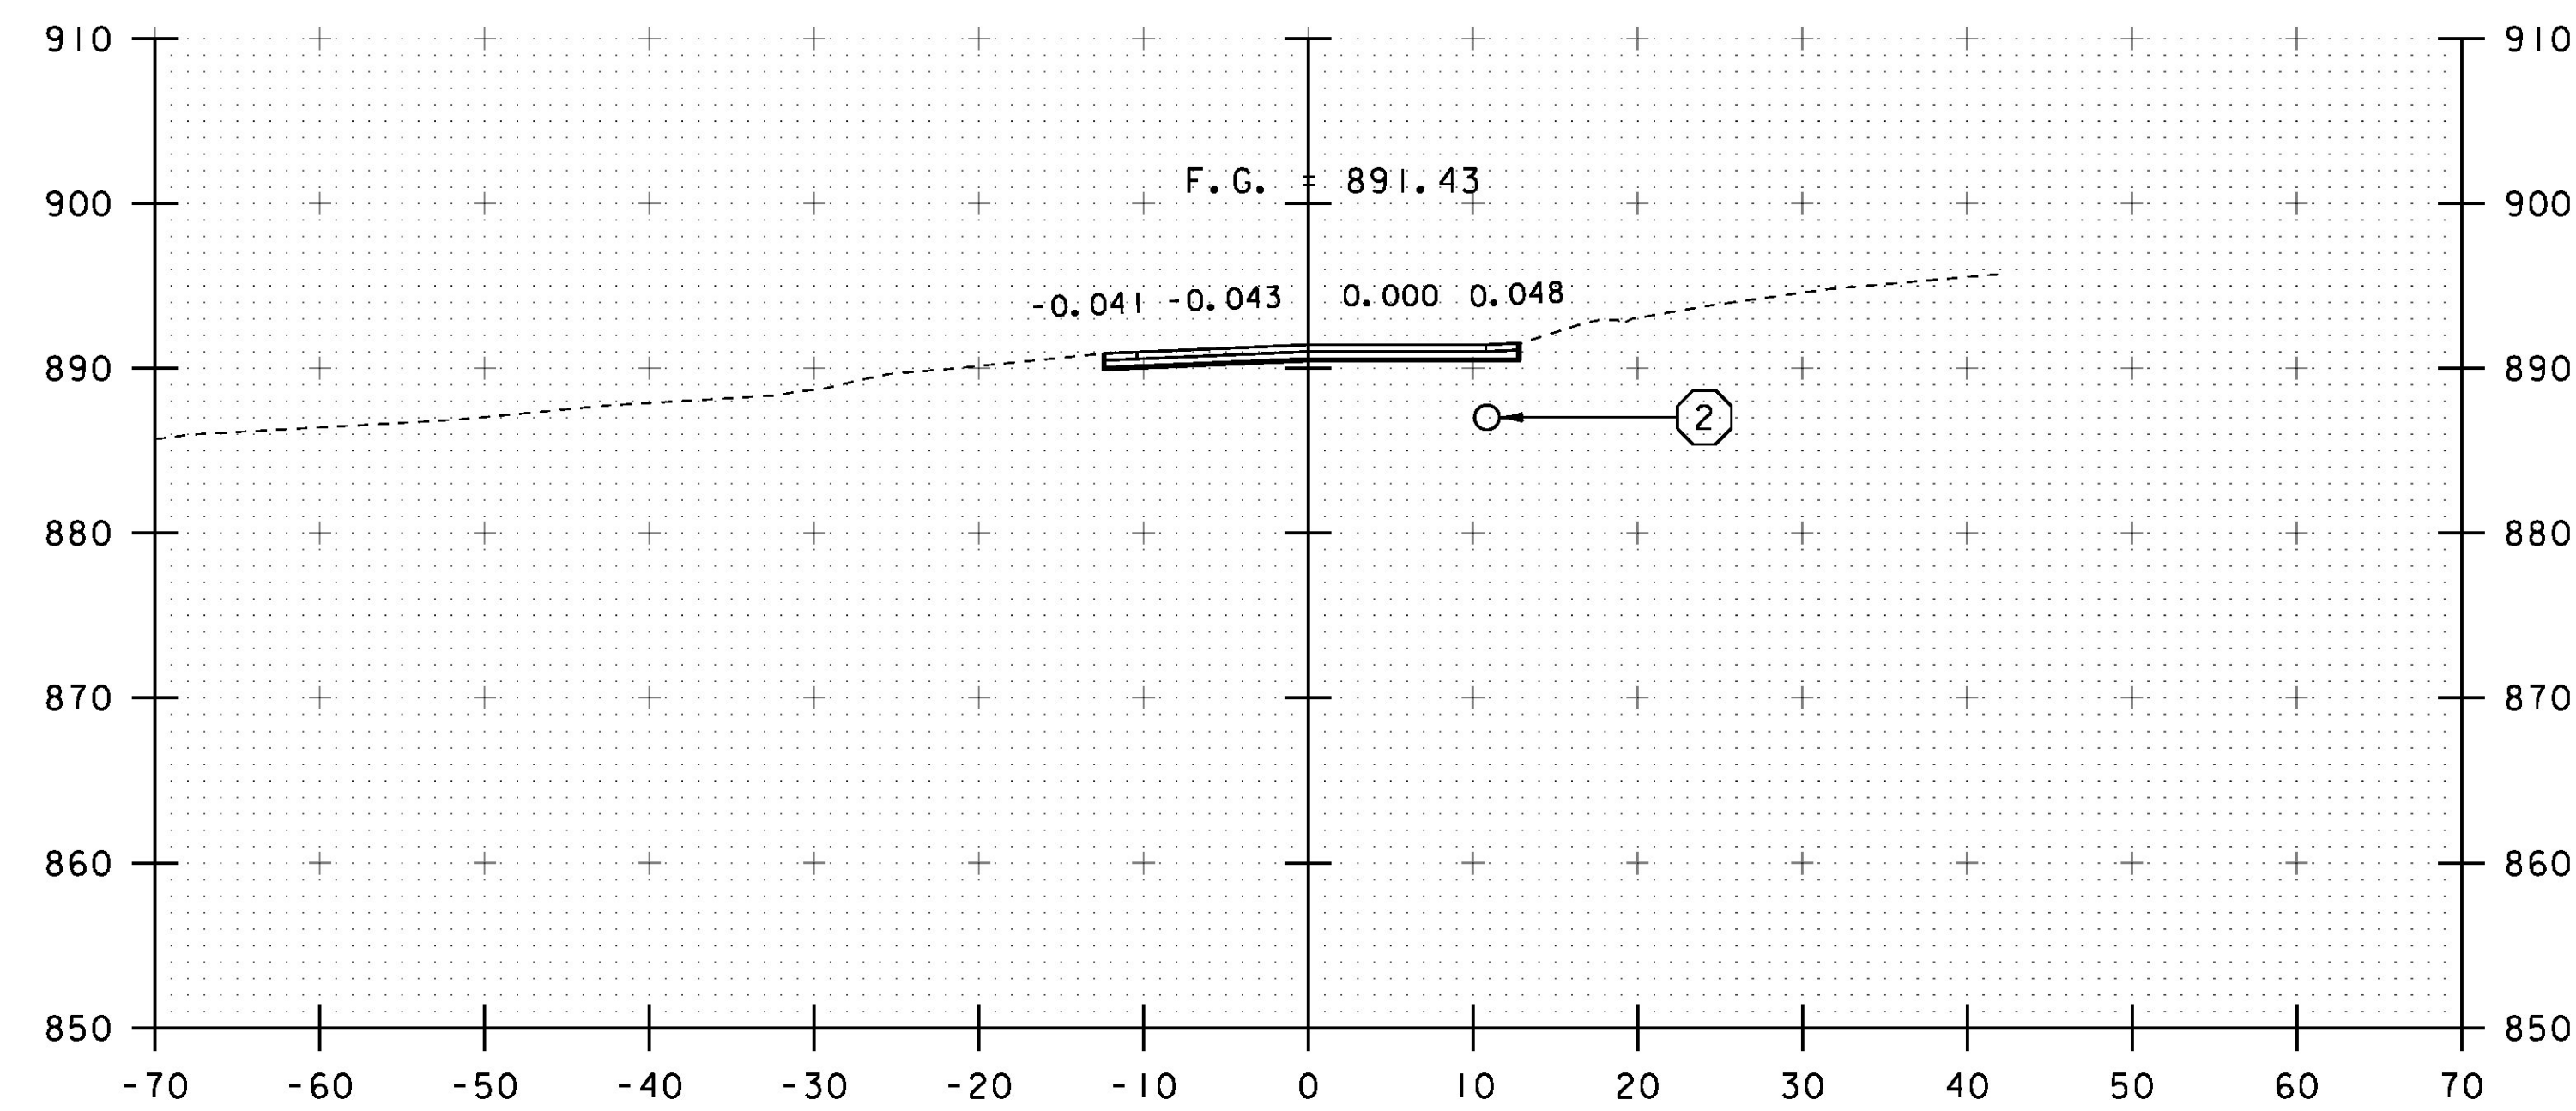

10+75

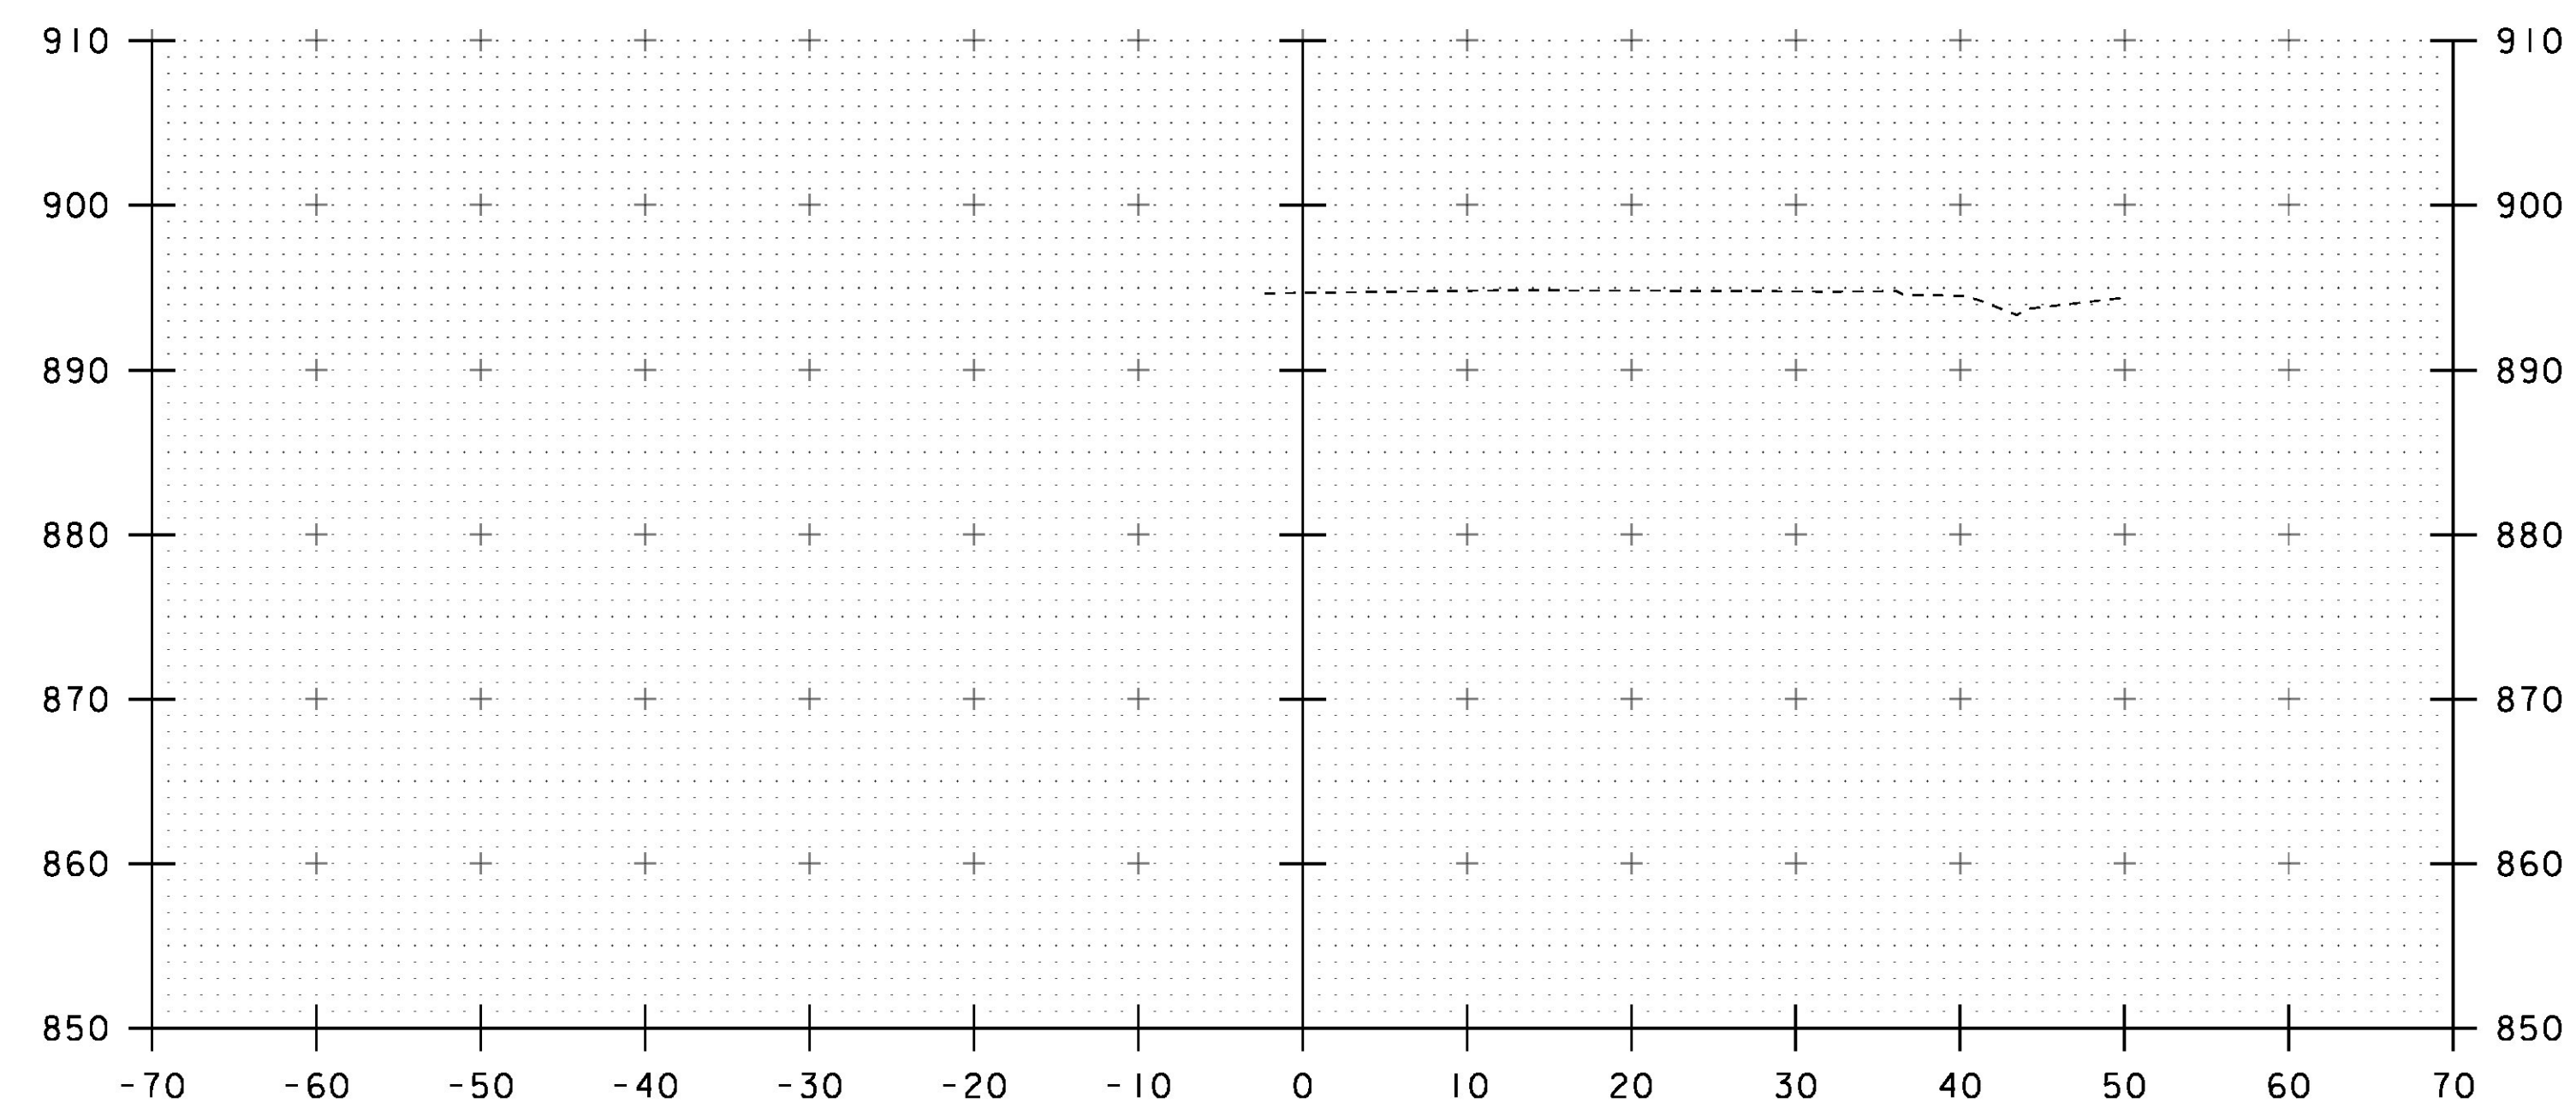

10+00

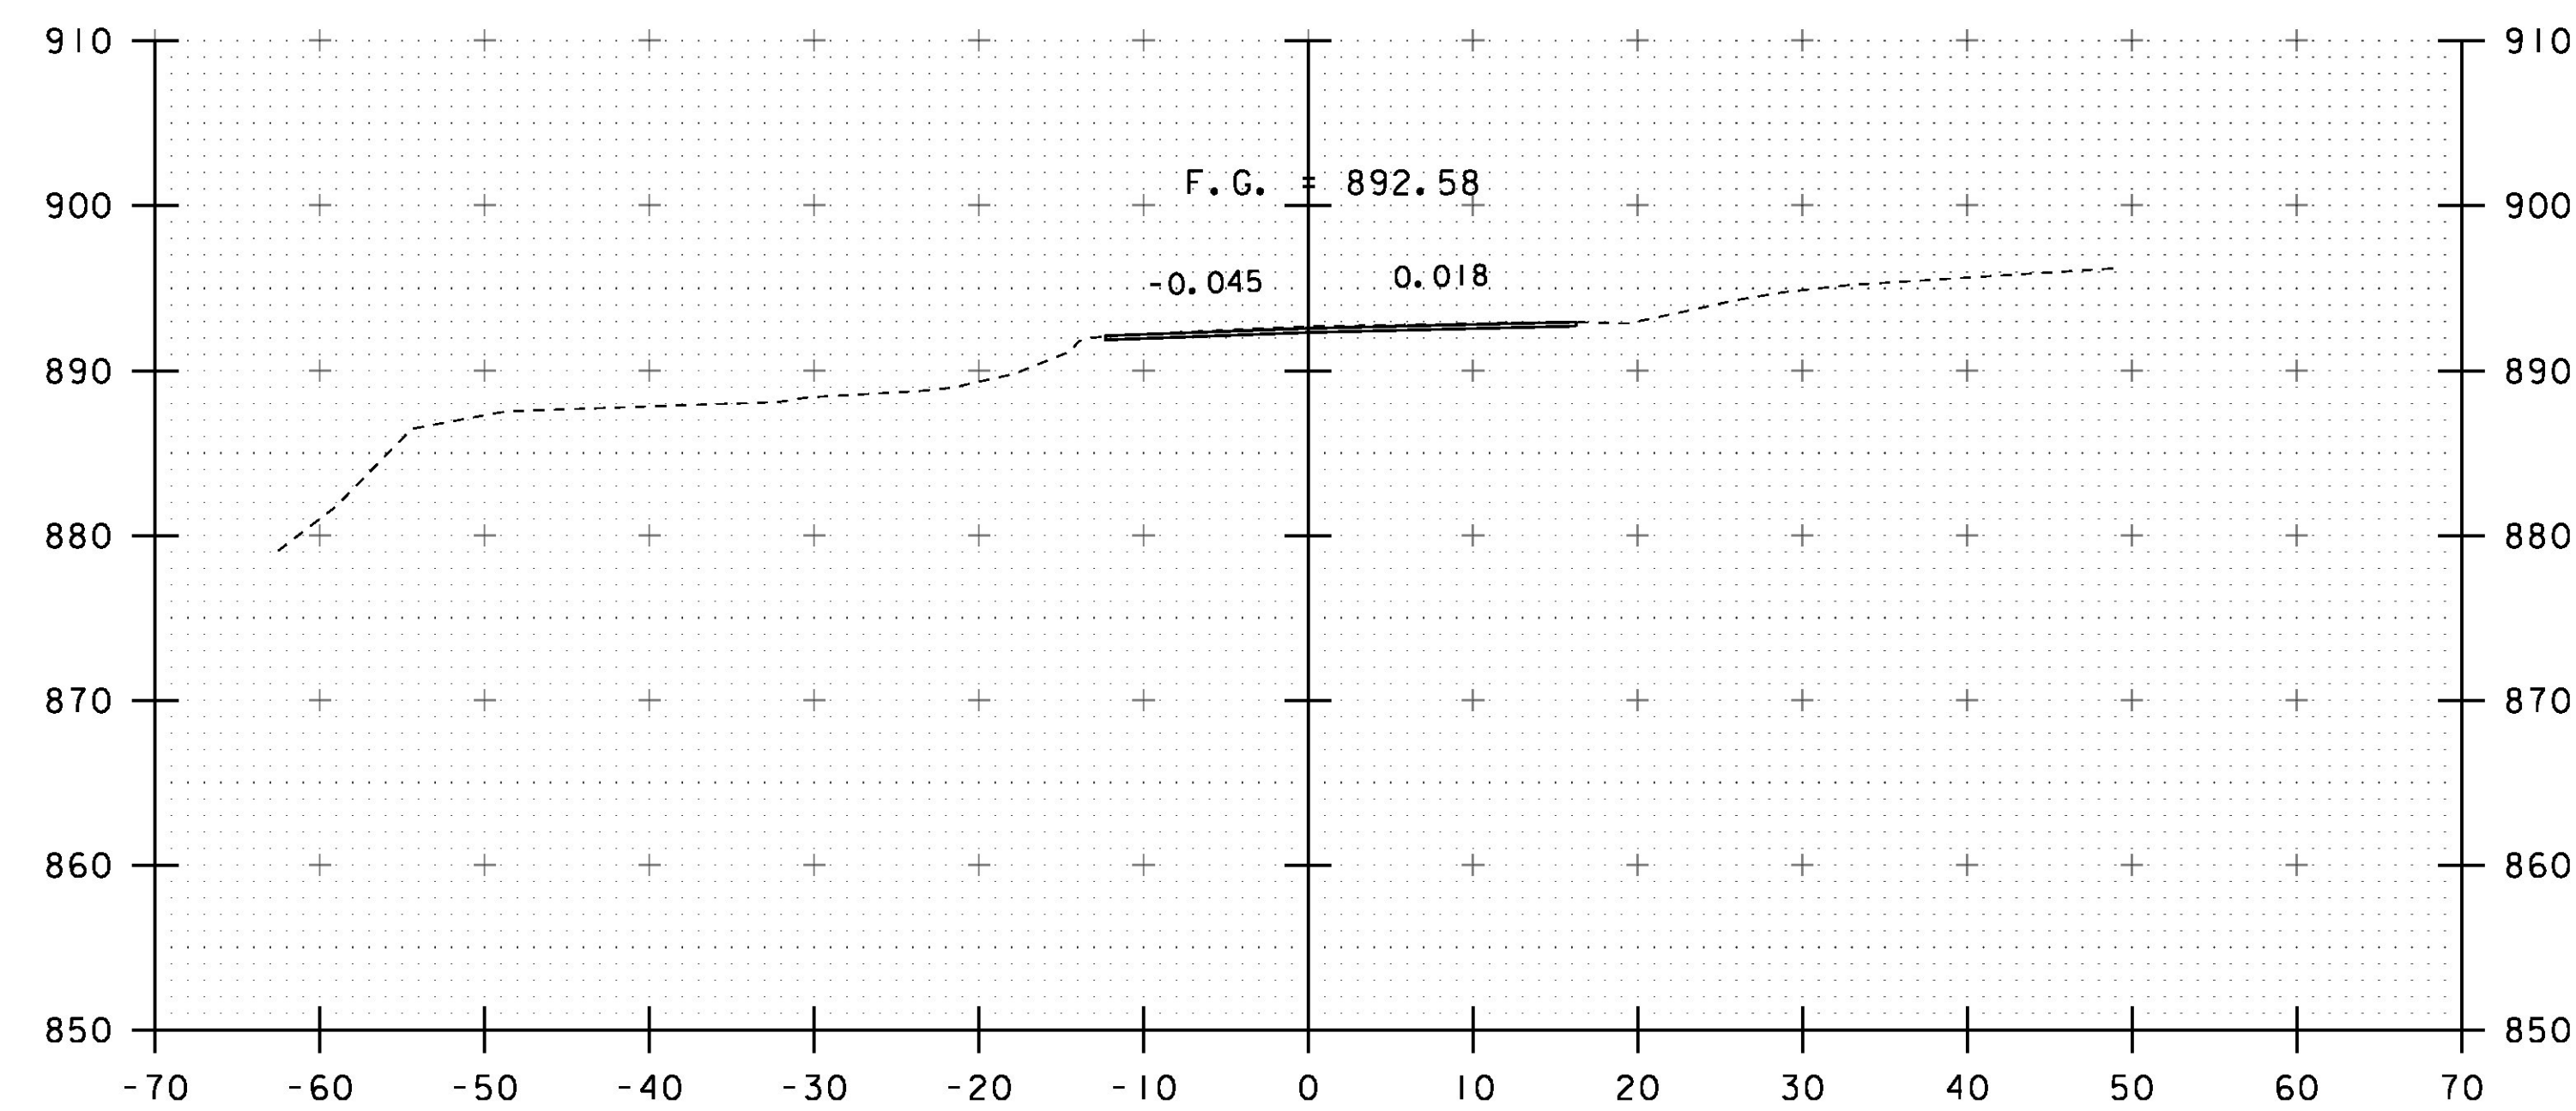

10+50

STA. 10+00 TO STA. 10+75

PROJECT NAME:	STRAFFORD	PLOT DATE:	31-AUG-2016
PROJECT NUMBER:	BF 0177(10)	DRAWN BY:	J. GRIGAS
FILE NAME:	sl3j088xsl.dgn	CHECKED BY:	T. MATTHEWS
PROJECT LEADER:	K. HIGGINS	DESIGNED BY:	J. GRIGAS
DESIGNED BY:	J. GRIGAS	MAINLINE SECTIONS I	SHEET 36 OF 52