



13+25


STA 13+25 RT
 END STONE FILL, TYPE I
 GEOTEXTILE UNDER STONE FILL

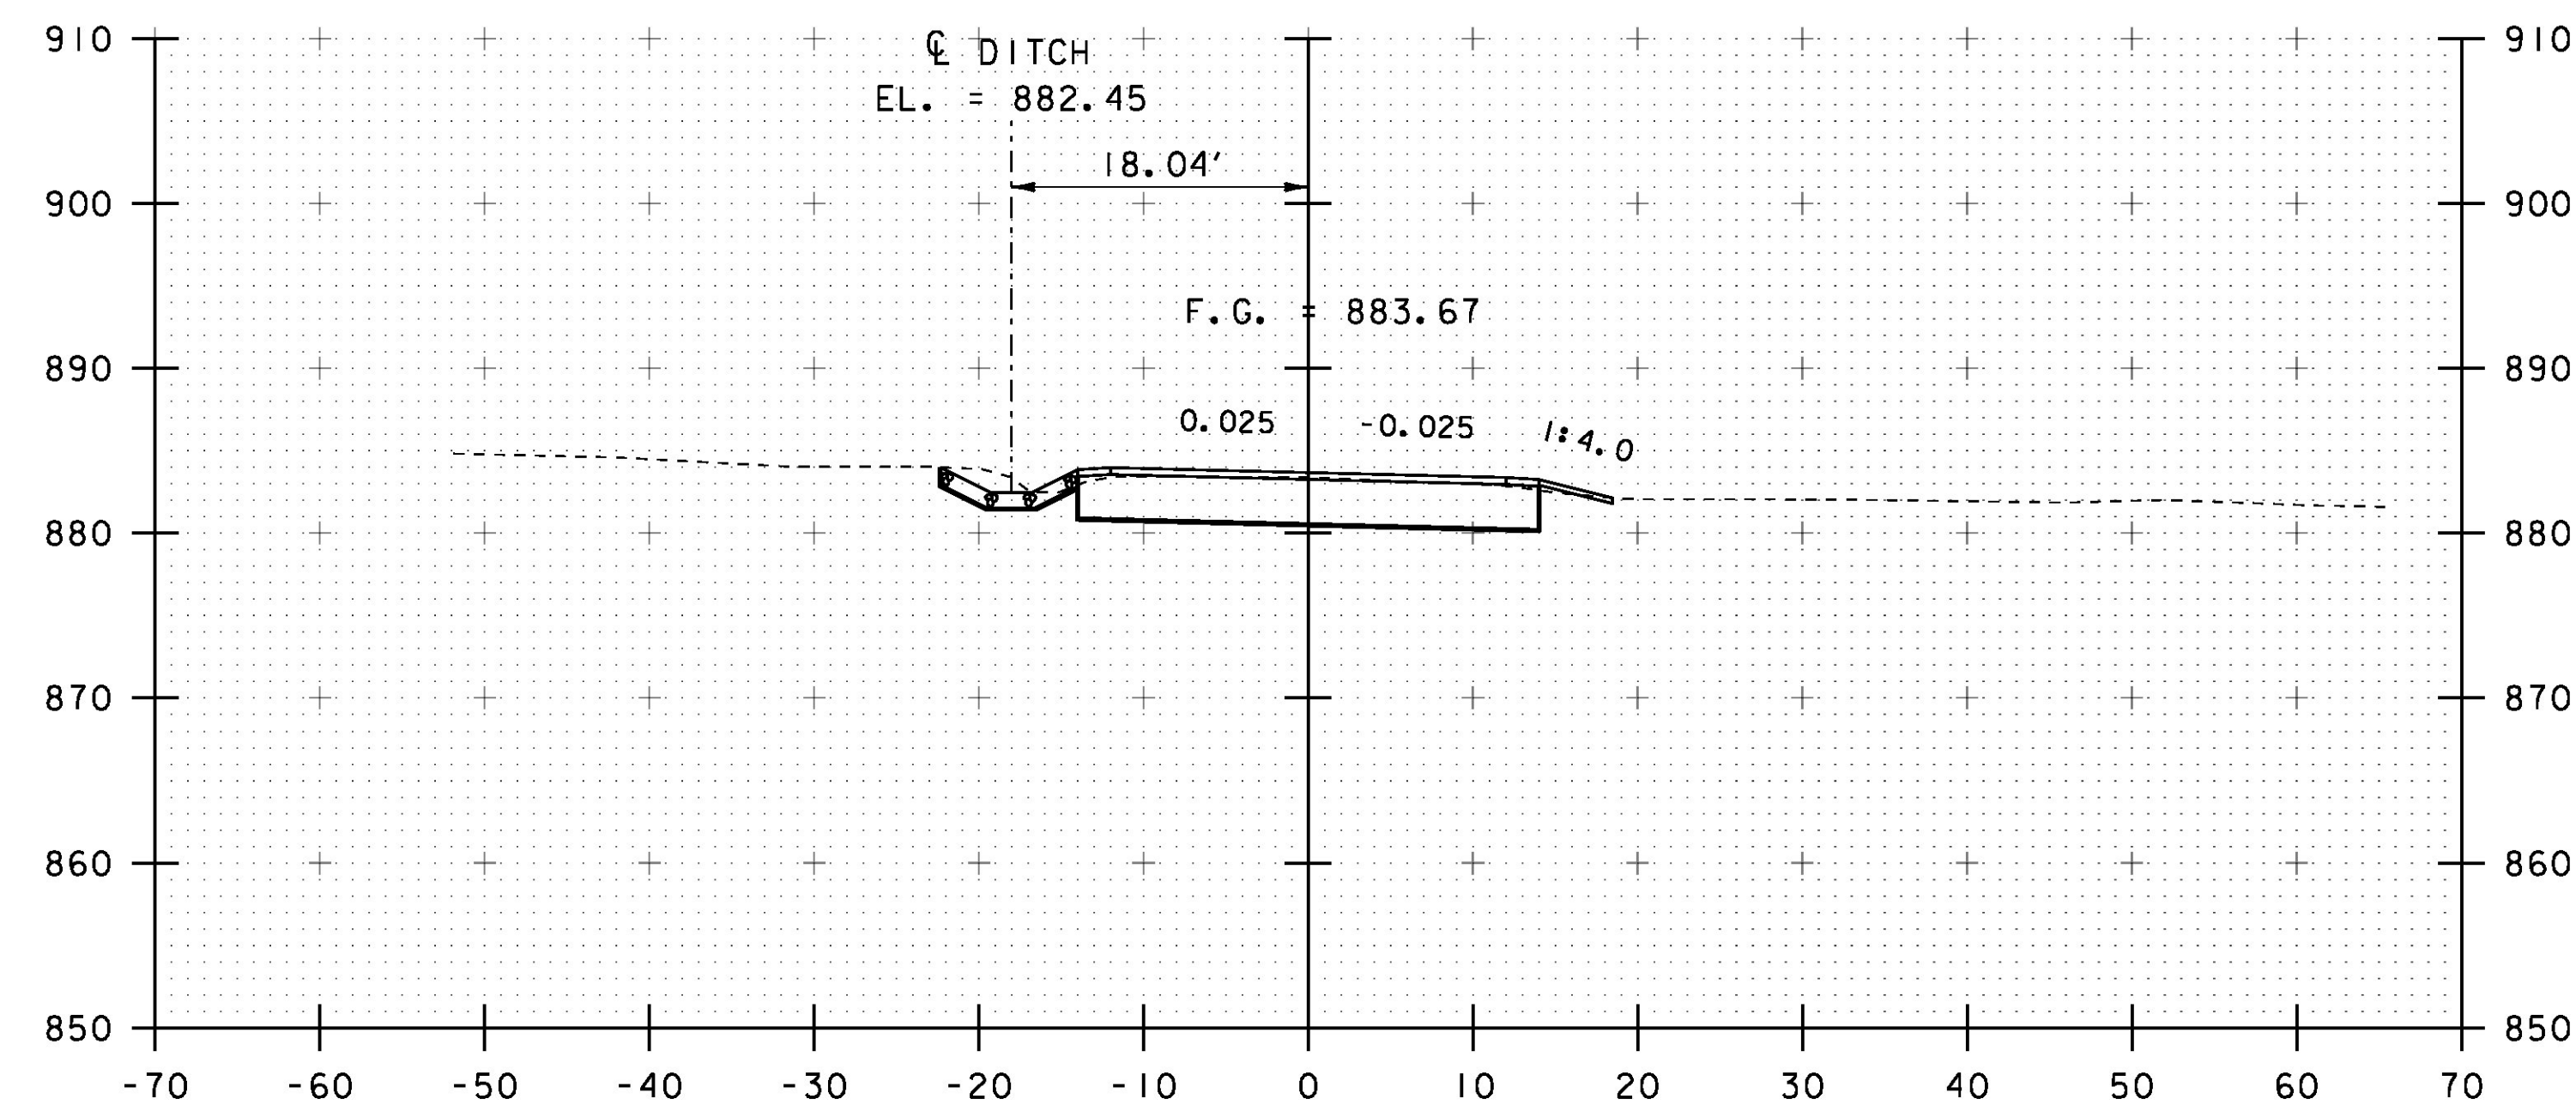

13+75

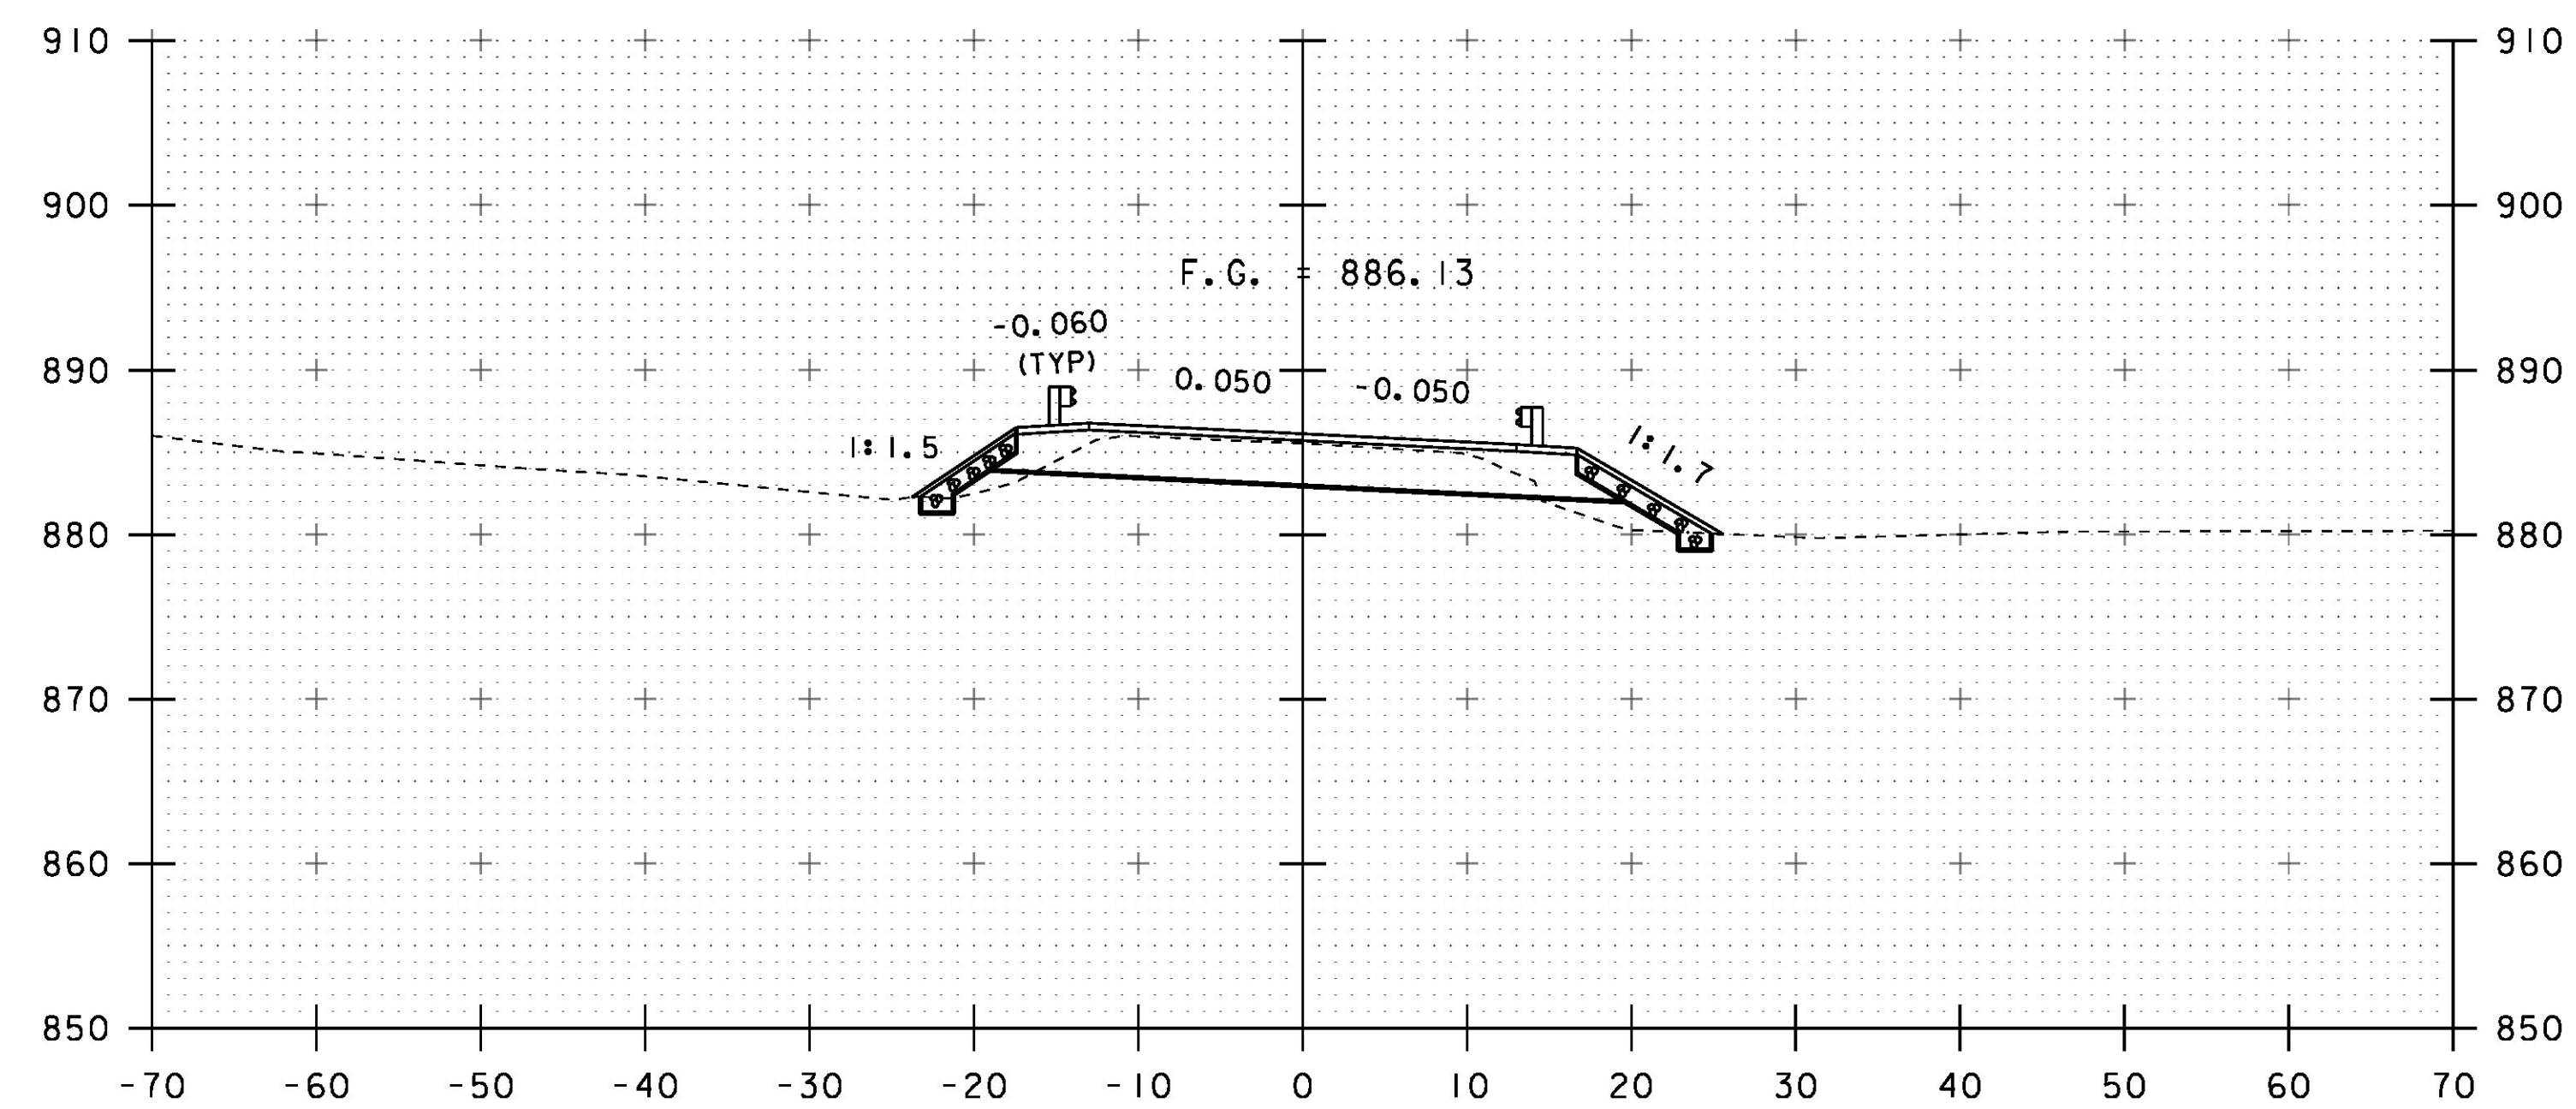

13+00

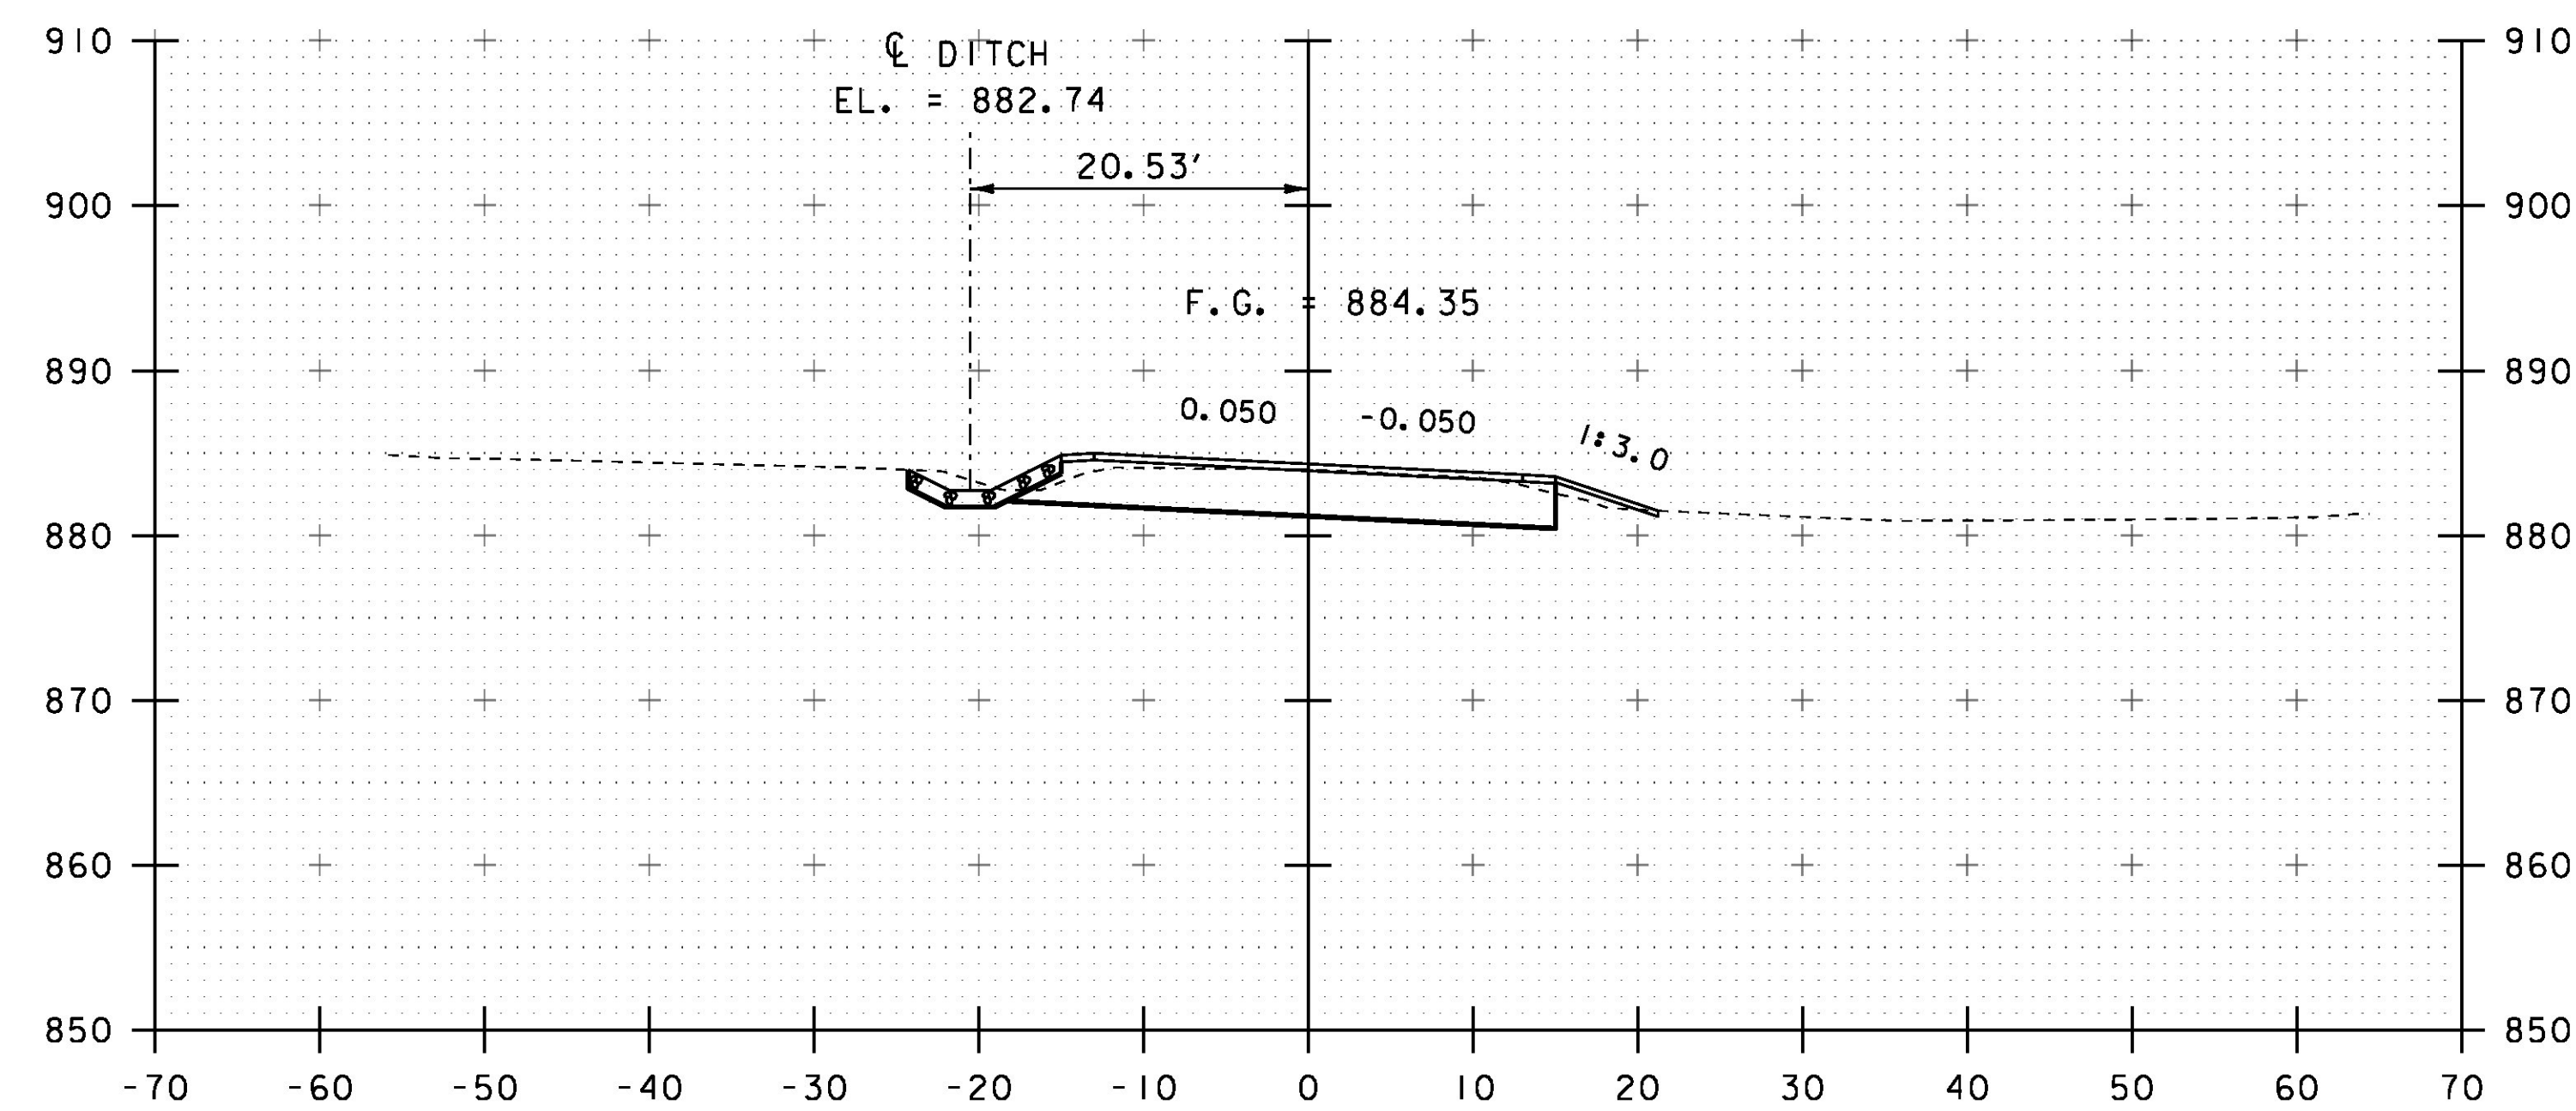

13+50

PROJECT NAME:	STRAFFORD
PROJECT NUMBER:	BF 0177(10)
FILE NAME:	sl3j088xsl.dgn
PROJECT LEADER:	K. HIGGINS
DESIGNED BY:	J. GRIGAS
MAINLINE SECTIONS	4
PLOT DATE:	31-AUG-2016
DRAWN BY:	J. GRIGAS
CHECKED BY:	T. MATTHEWS
SHEET	39 OF 52

STA. 13+00 TO STA. 13+75