



14+25

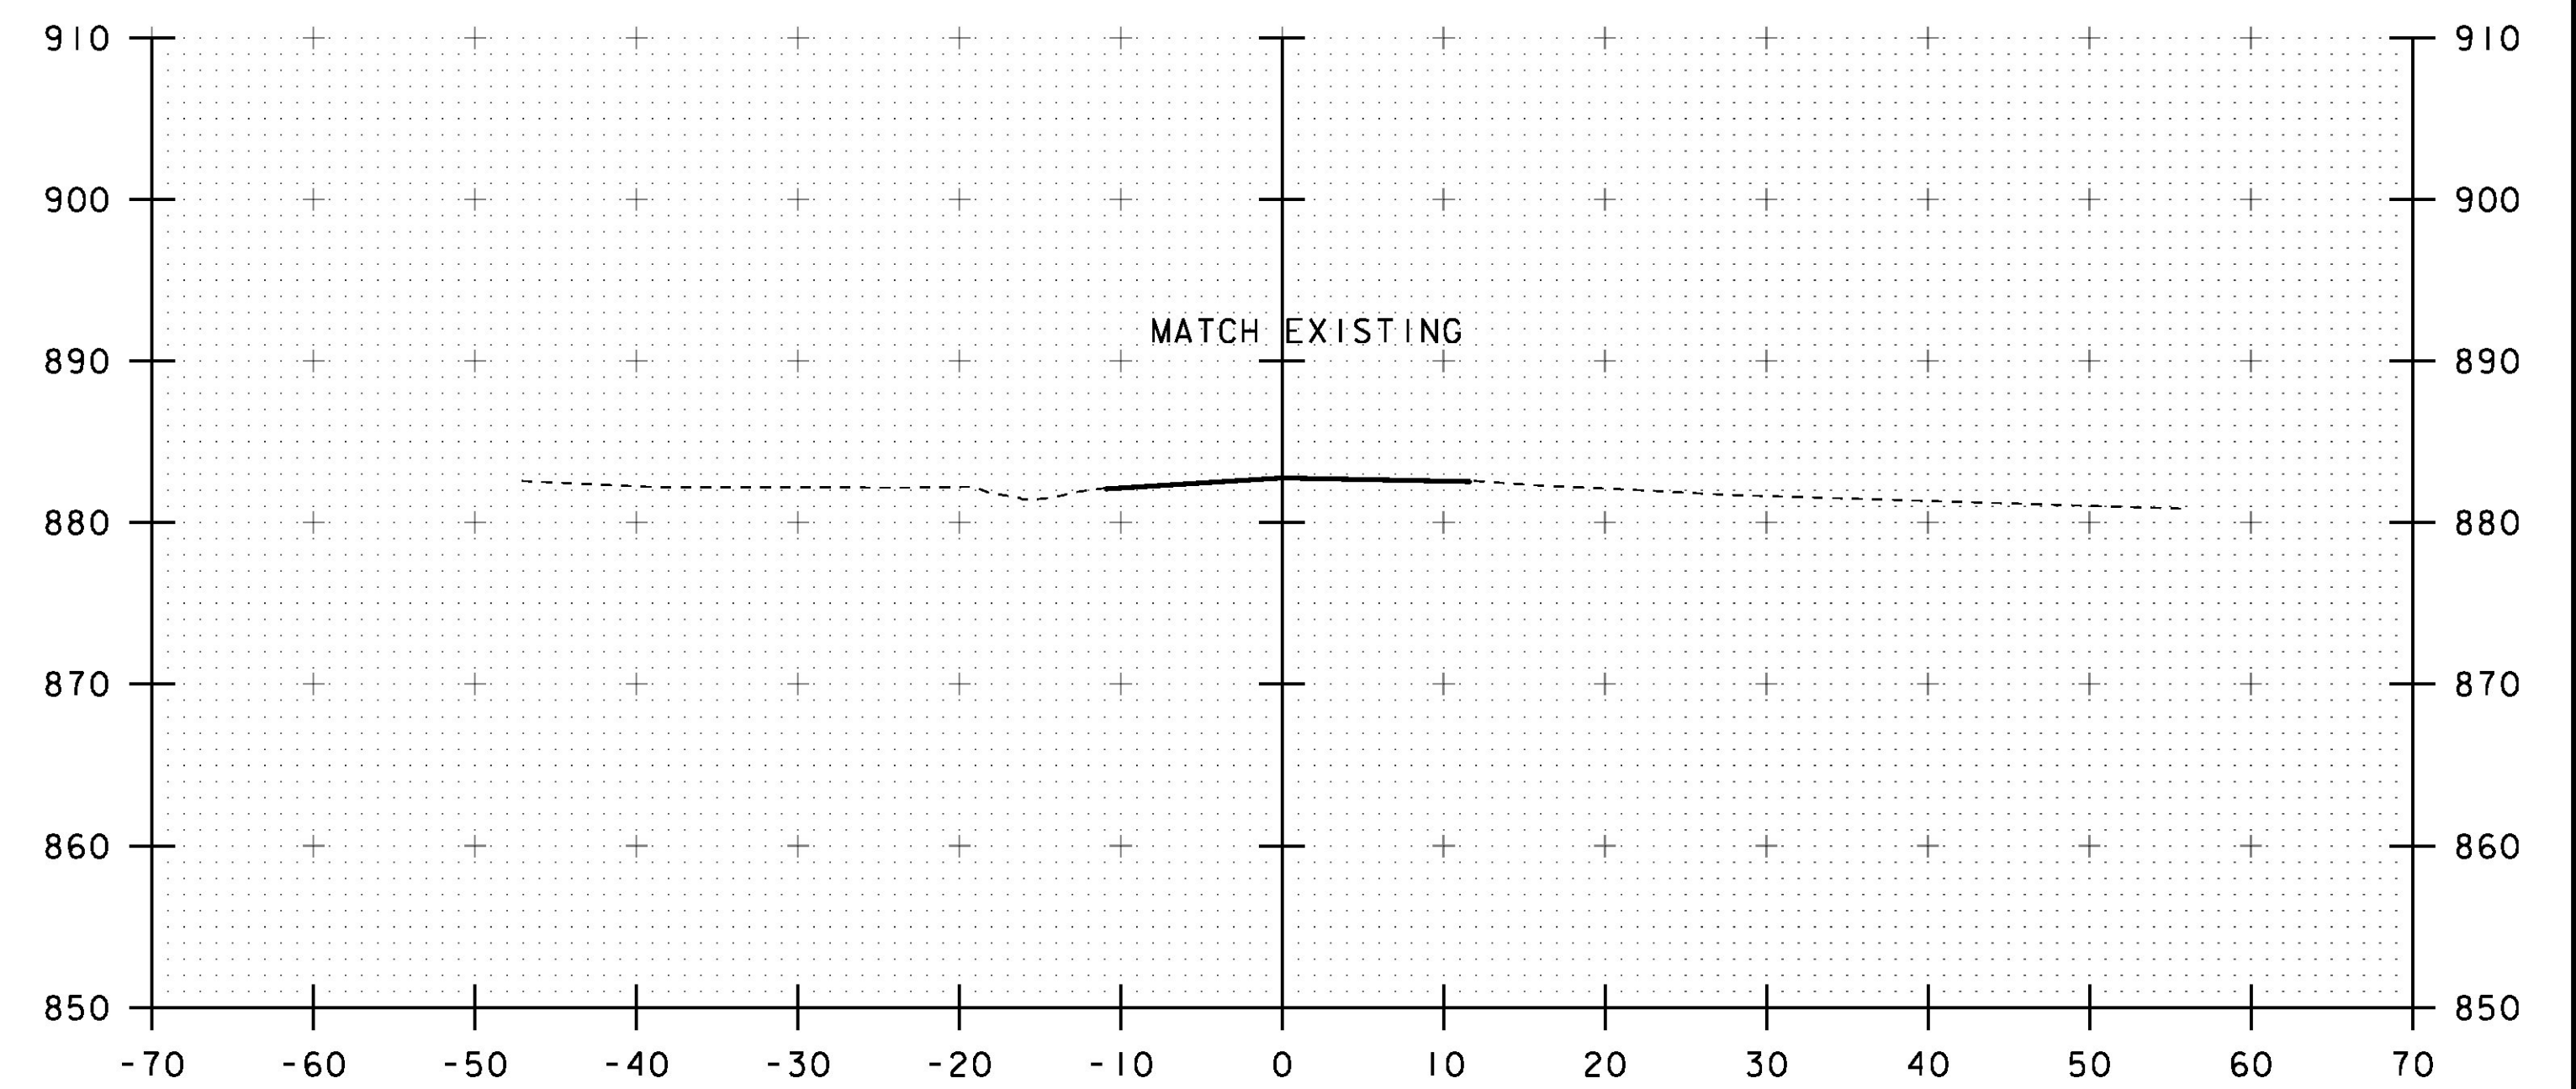


14+75  
END APPROACH

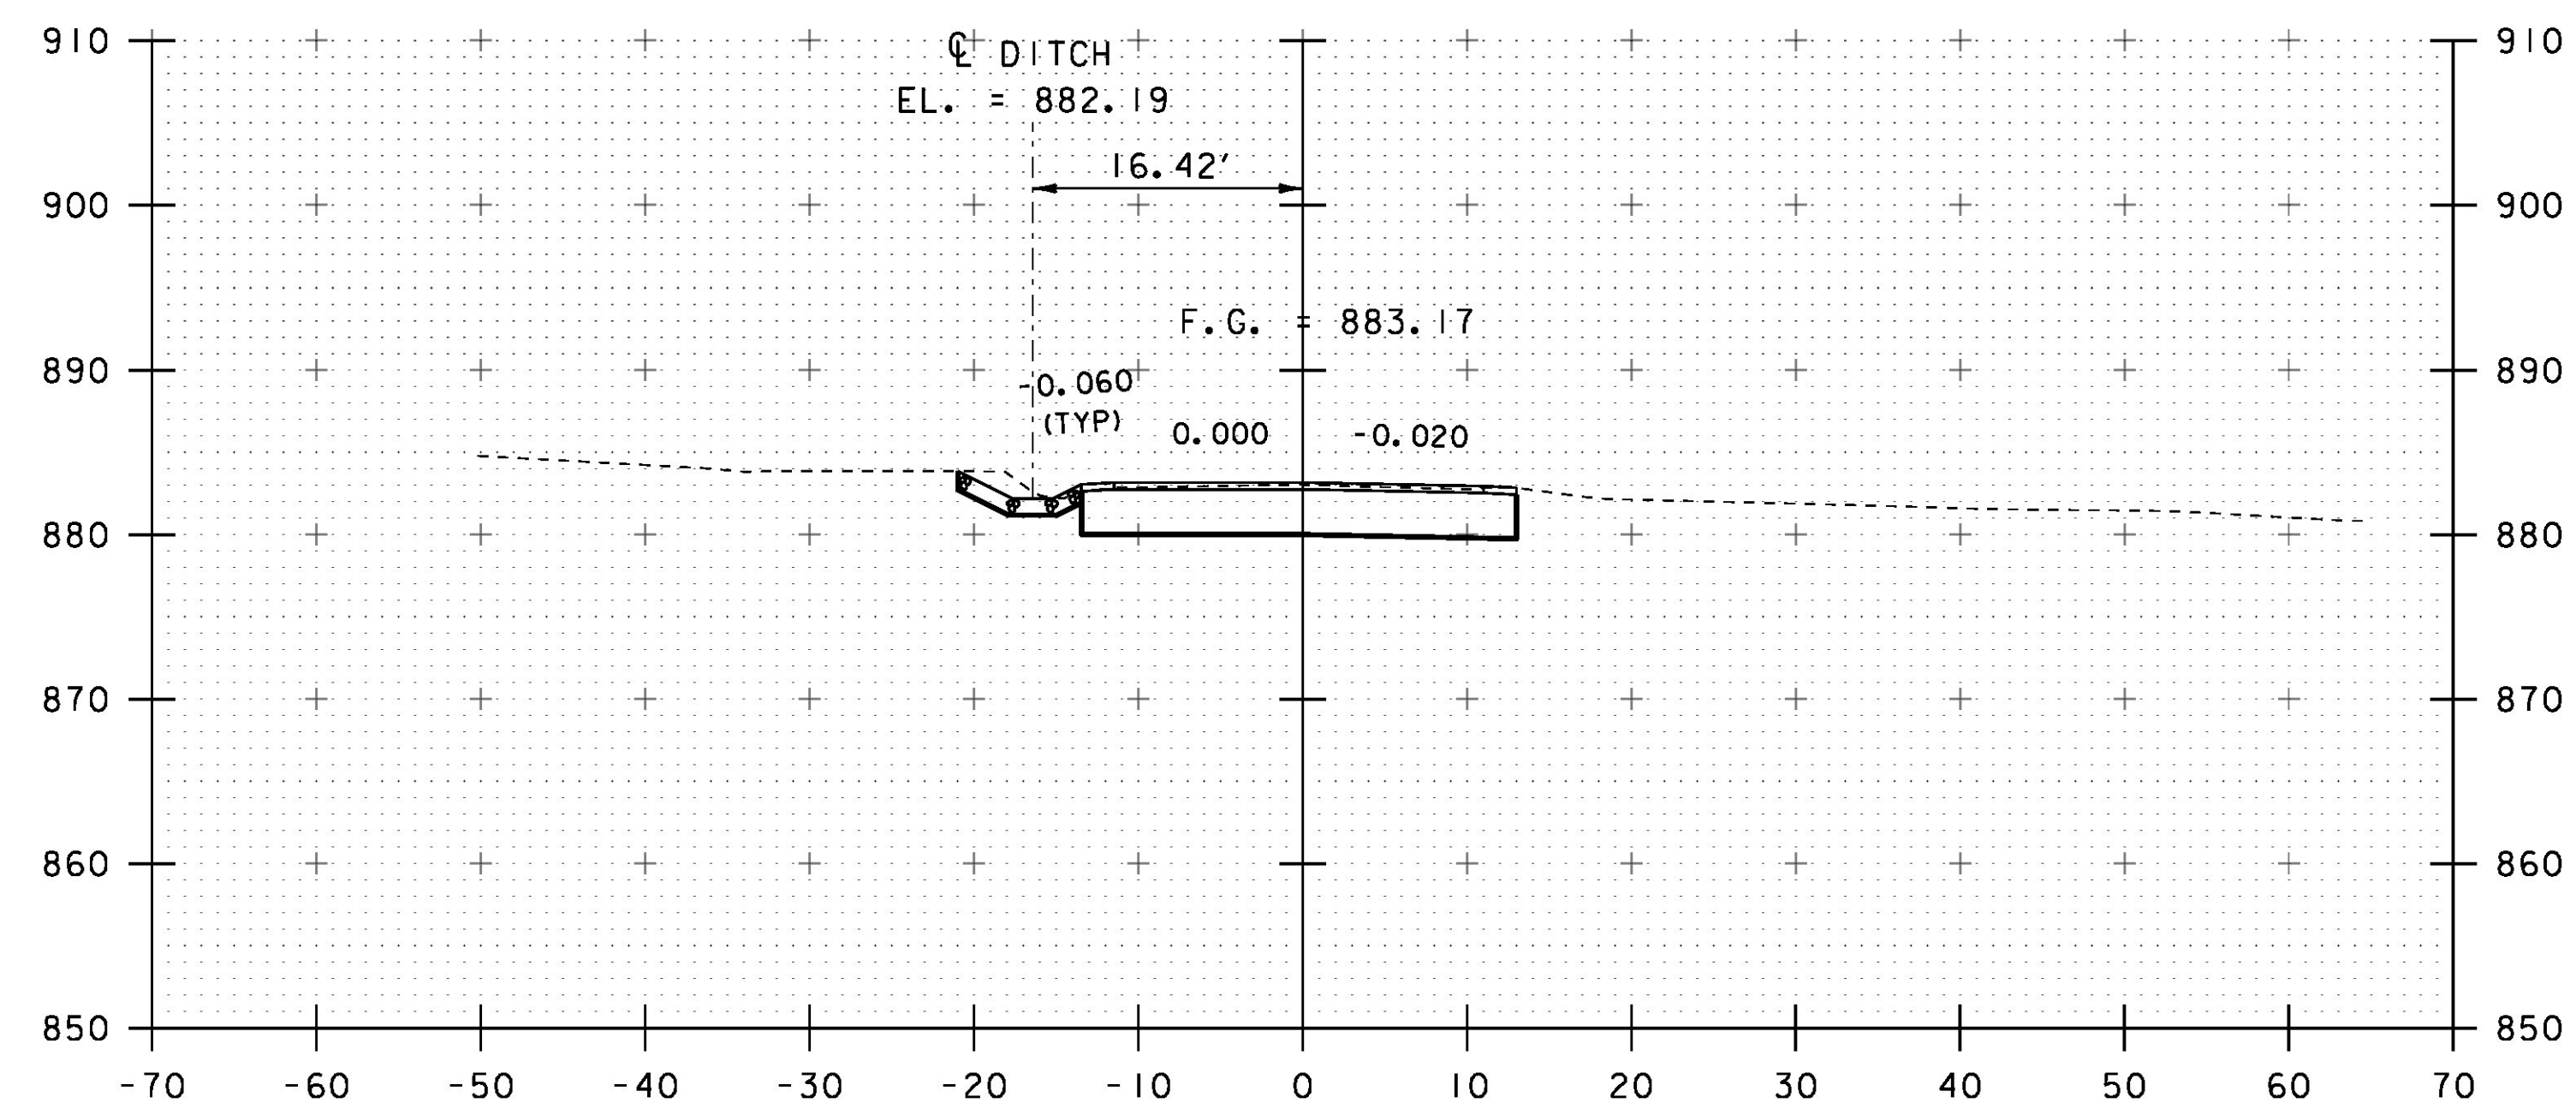

14+00  
END PROJECT

STA 14+20.00 LT  
END STONE FILL, TYPE I  
GEOTEXTILE UNDER STONE FILL

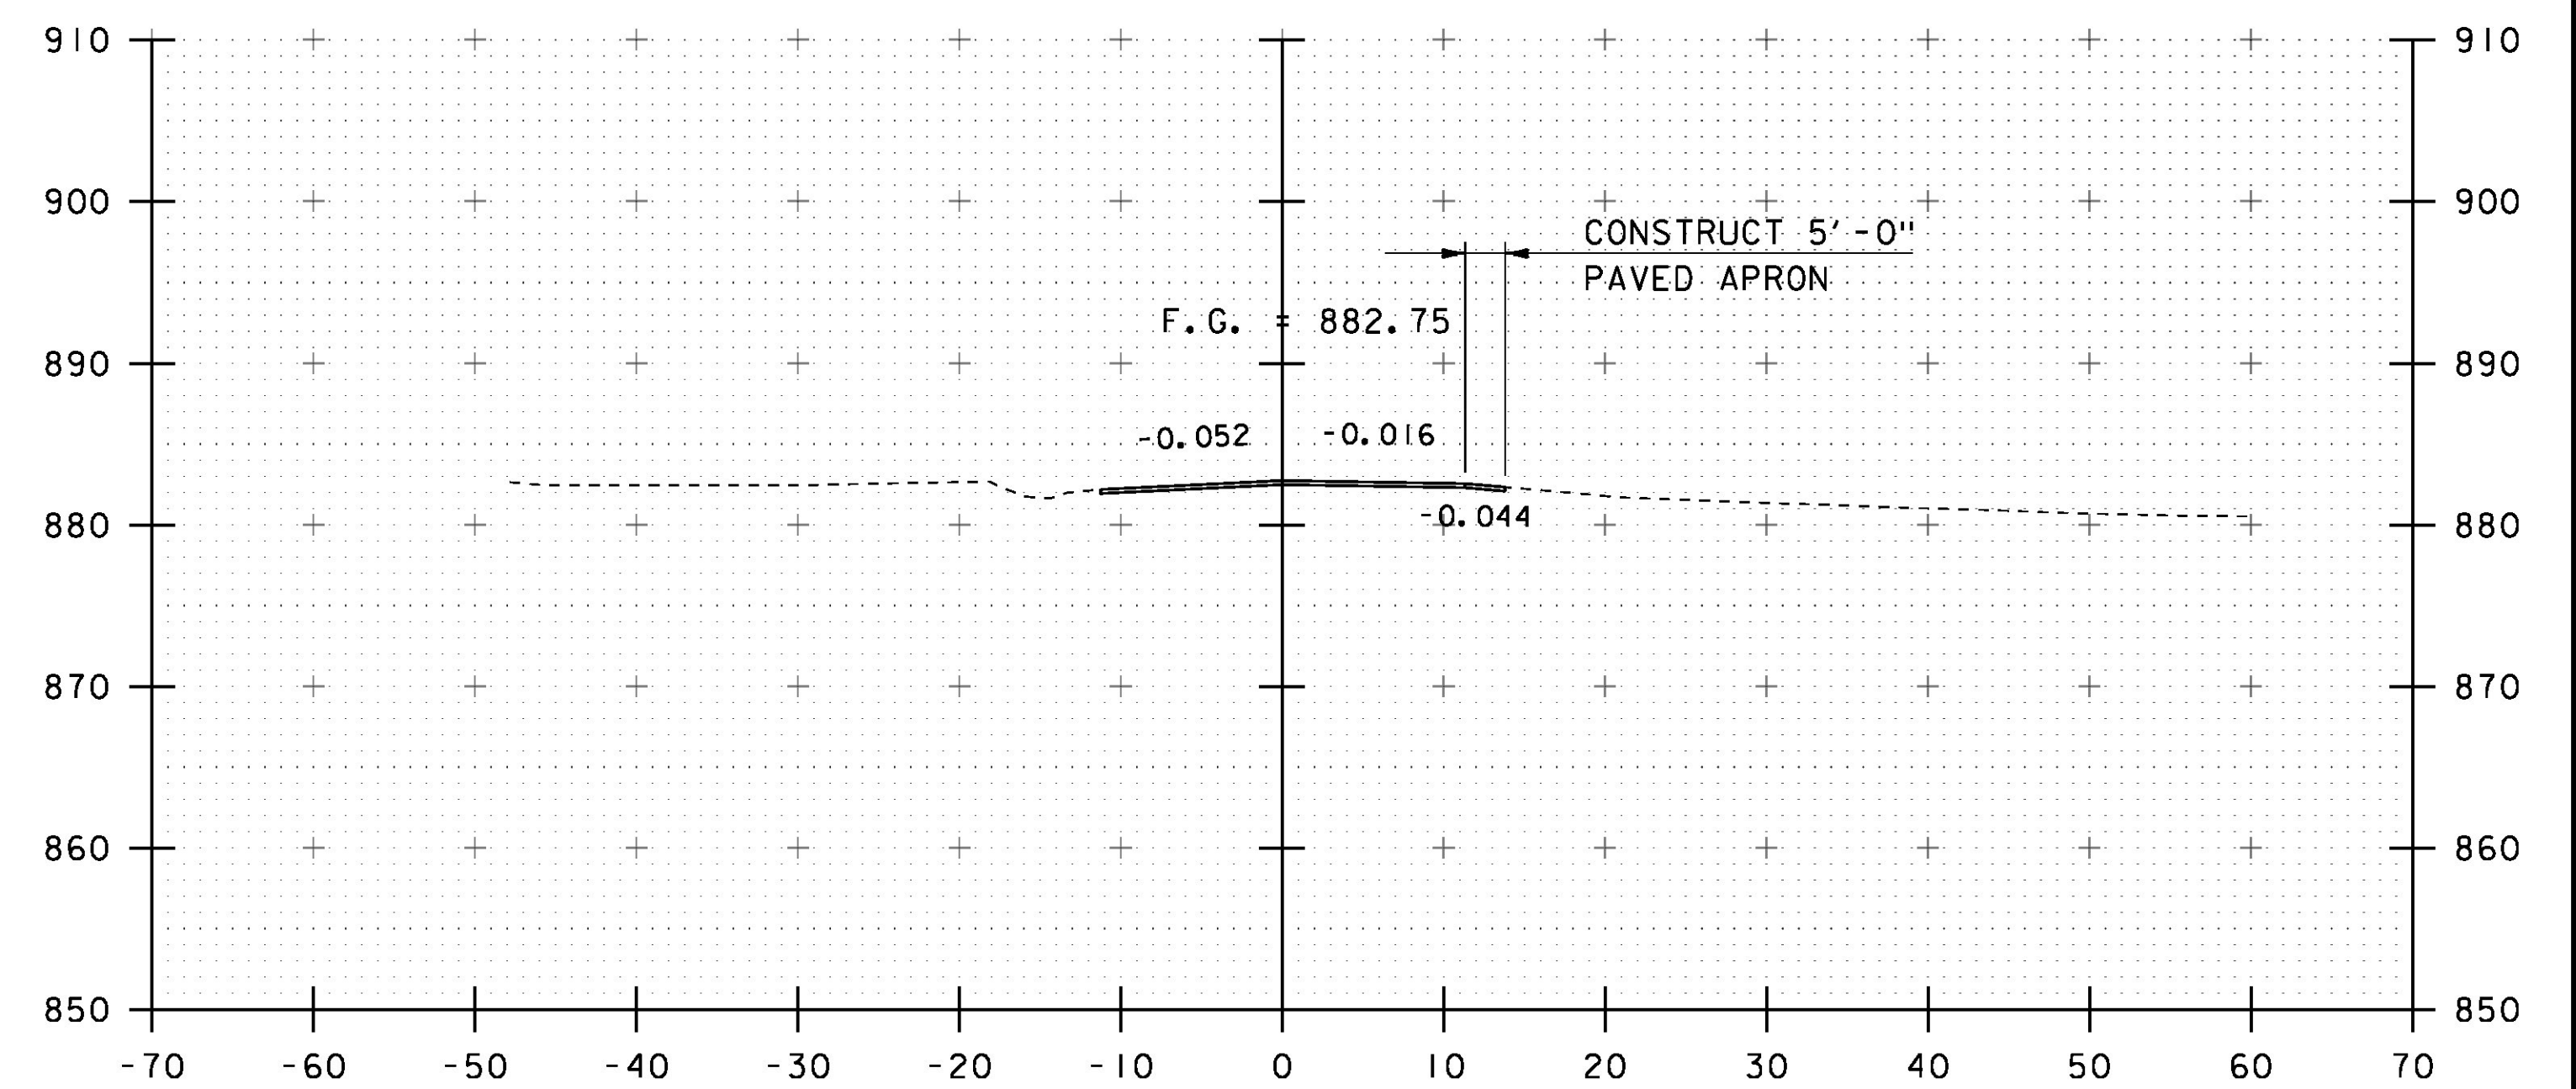

14+50

PROJECT NAME:	STRAFFORD
PROJECT NUMBER:	BF 0177(10)
FILE NAME:	sl3j088xsl.dgn
PROJECT LEADER:	K. HIGGINS
DESIGNED BY:	J. GRIGAS
MAINLINE SECTIONS	5
PLOT DATE:	31-AUG-2016
DRAWN BY:	J. GRIGAS
CHECKED BY:	T. MATTHEWS
SHEET	40 OF 52

STA. 14+00 TO STA. 14+75