



50+50

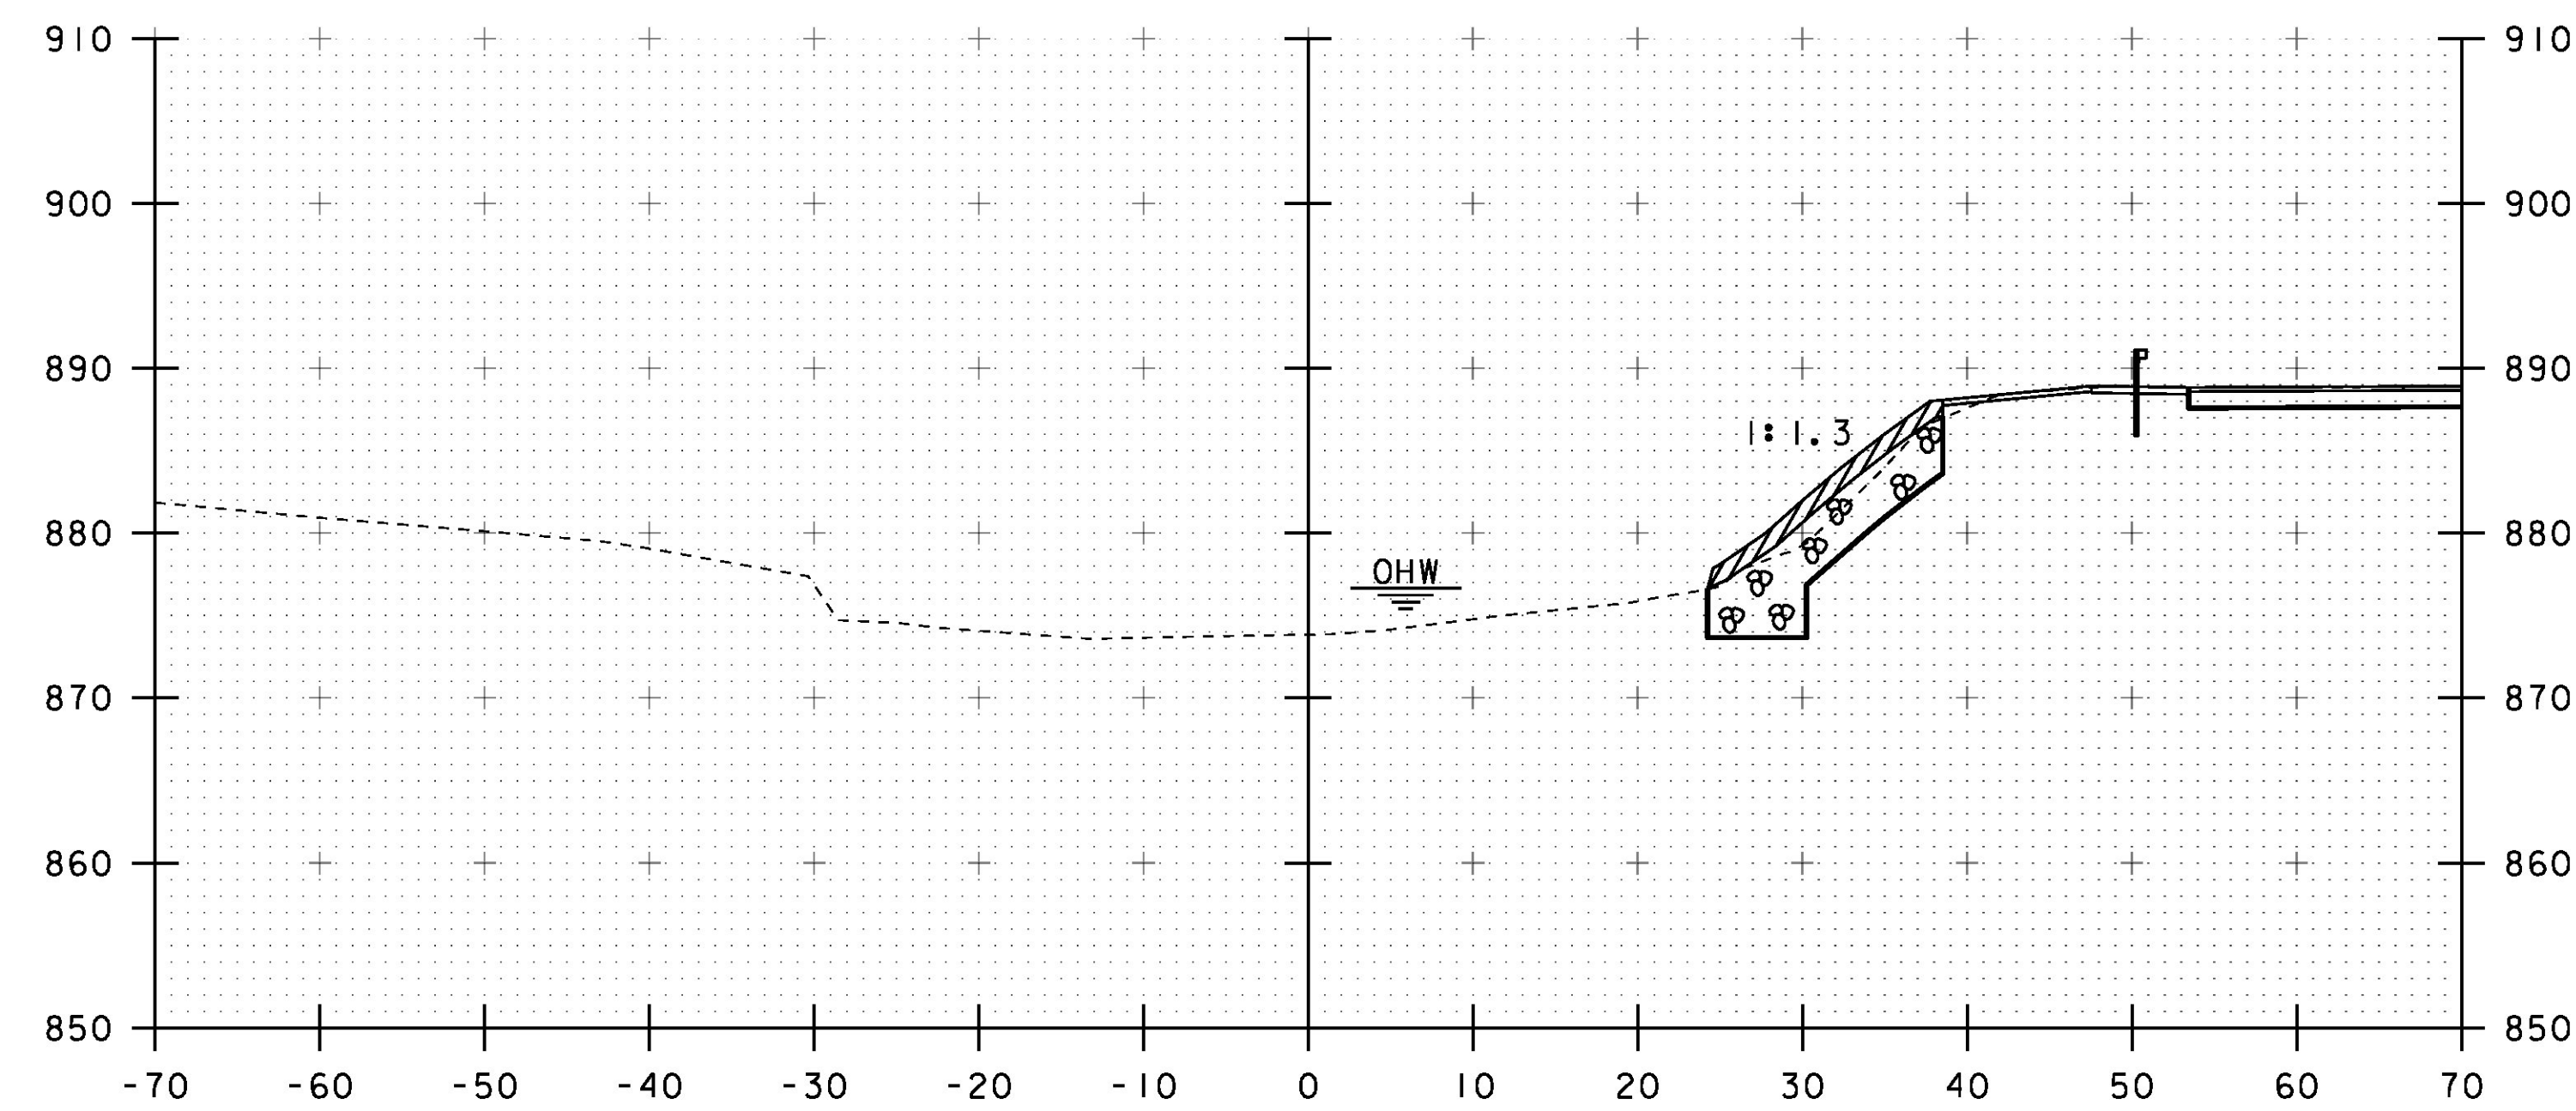


STA 50+76.00 LT
 BEGIN STONE FILL, TYPE III
 GEOTEXTILE UNDER STONE FILL
 GRUBBING MATERIAL
 UNCLASSIFIED CHANNEL EXCAVATION

50+70

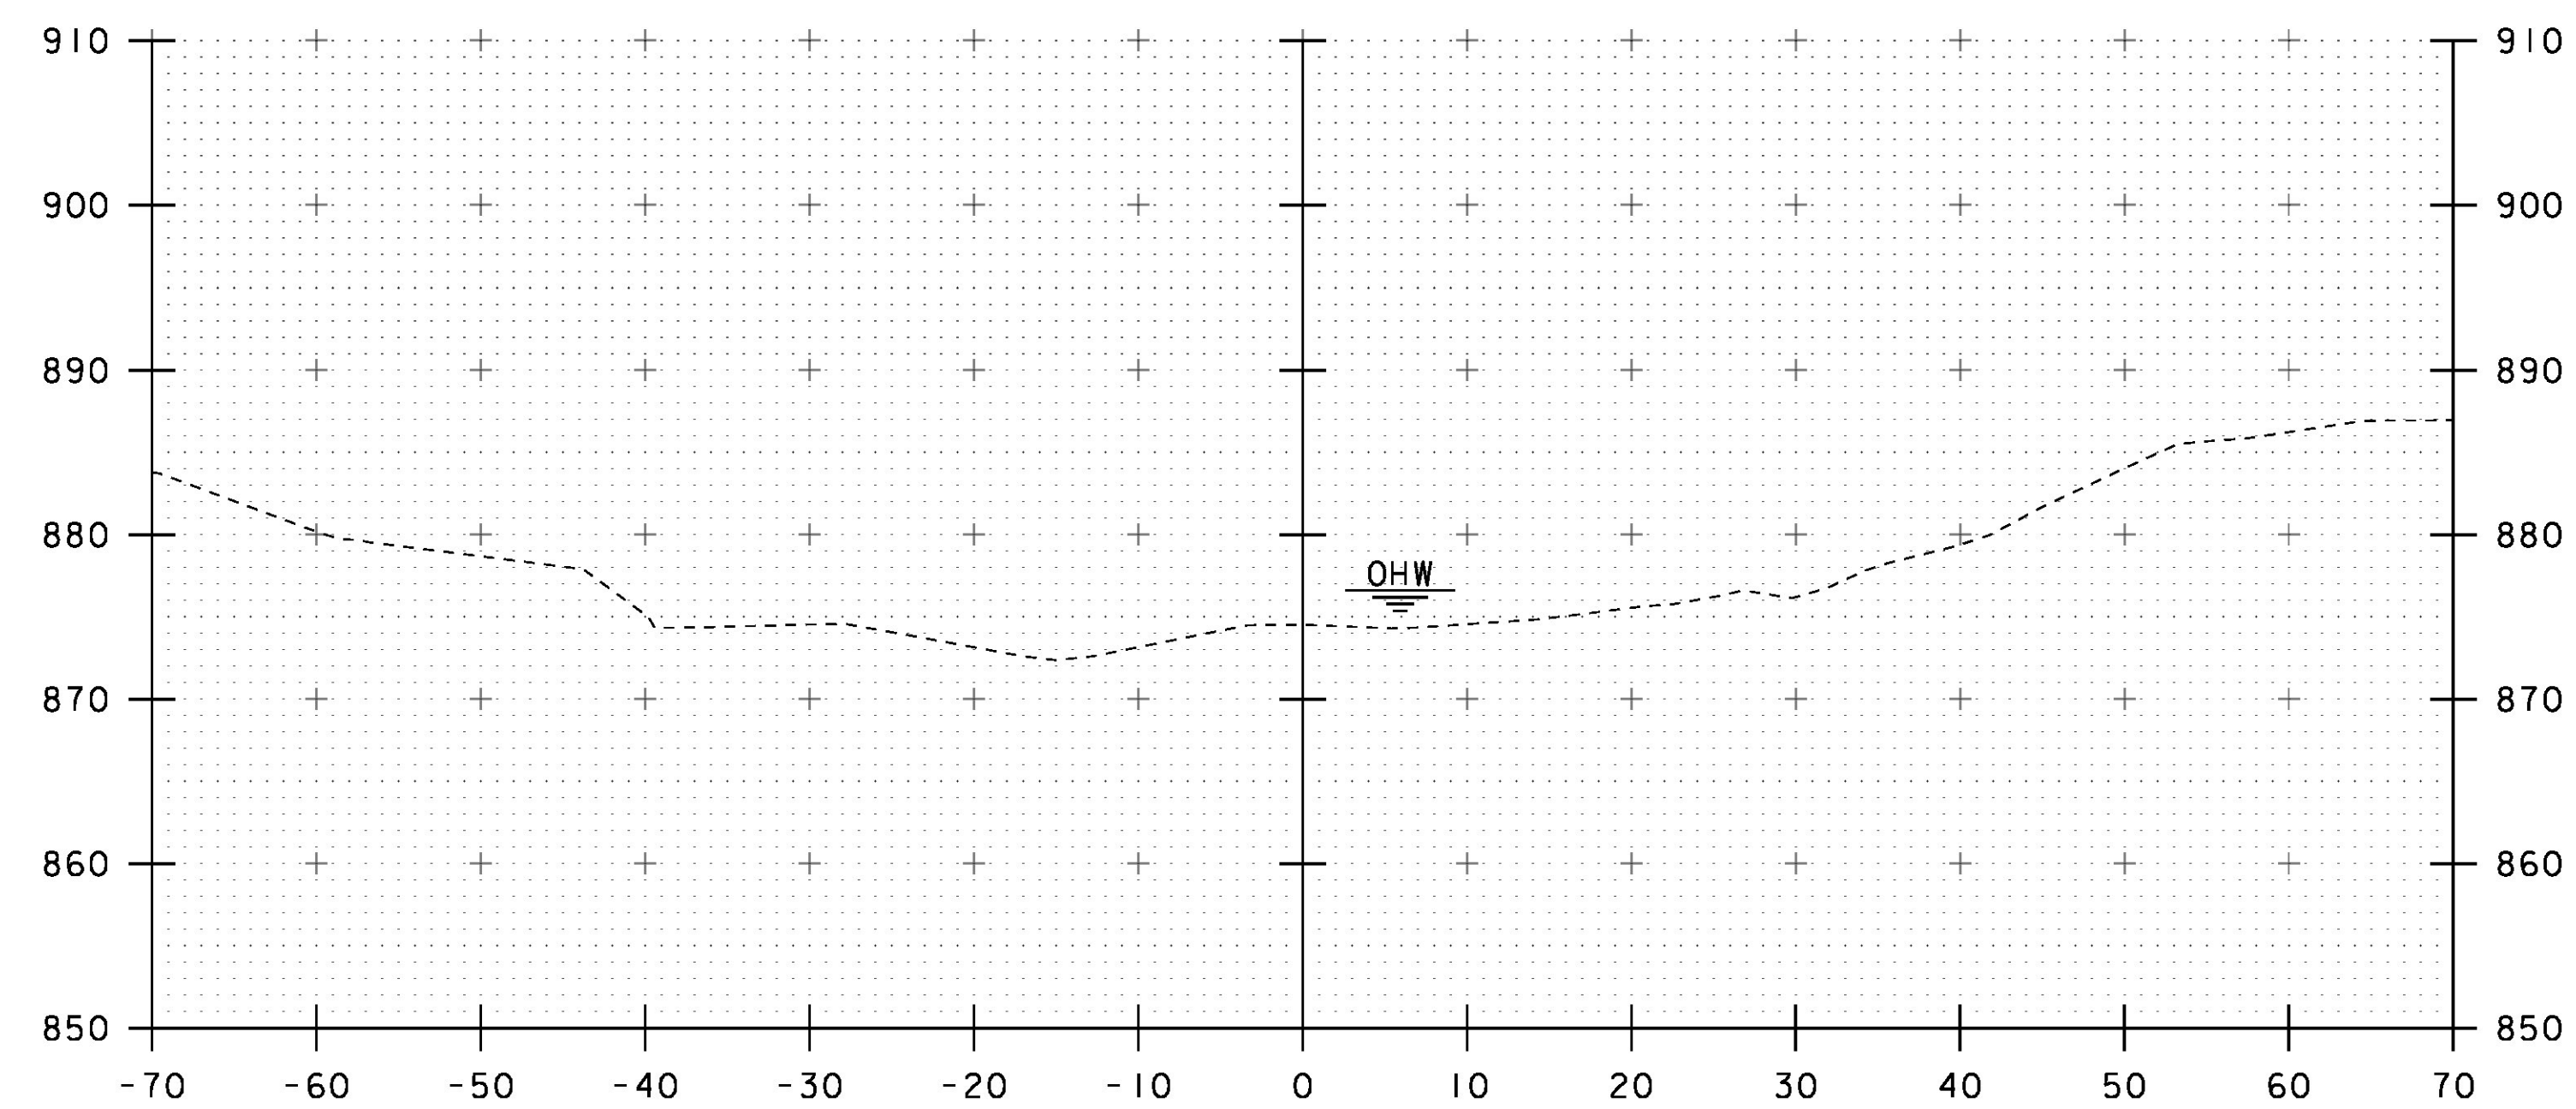

50+40

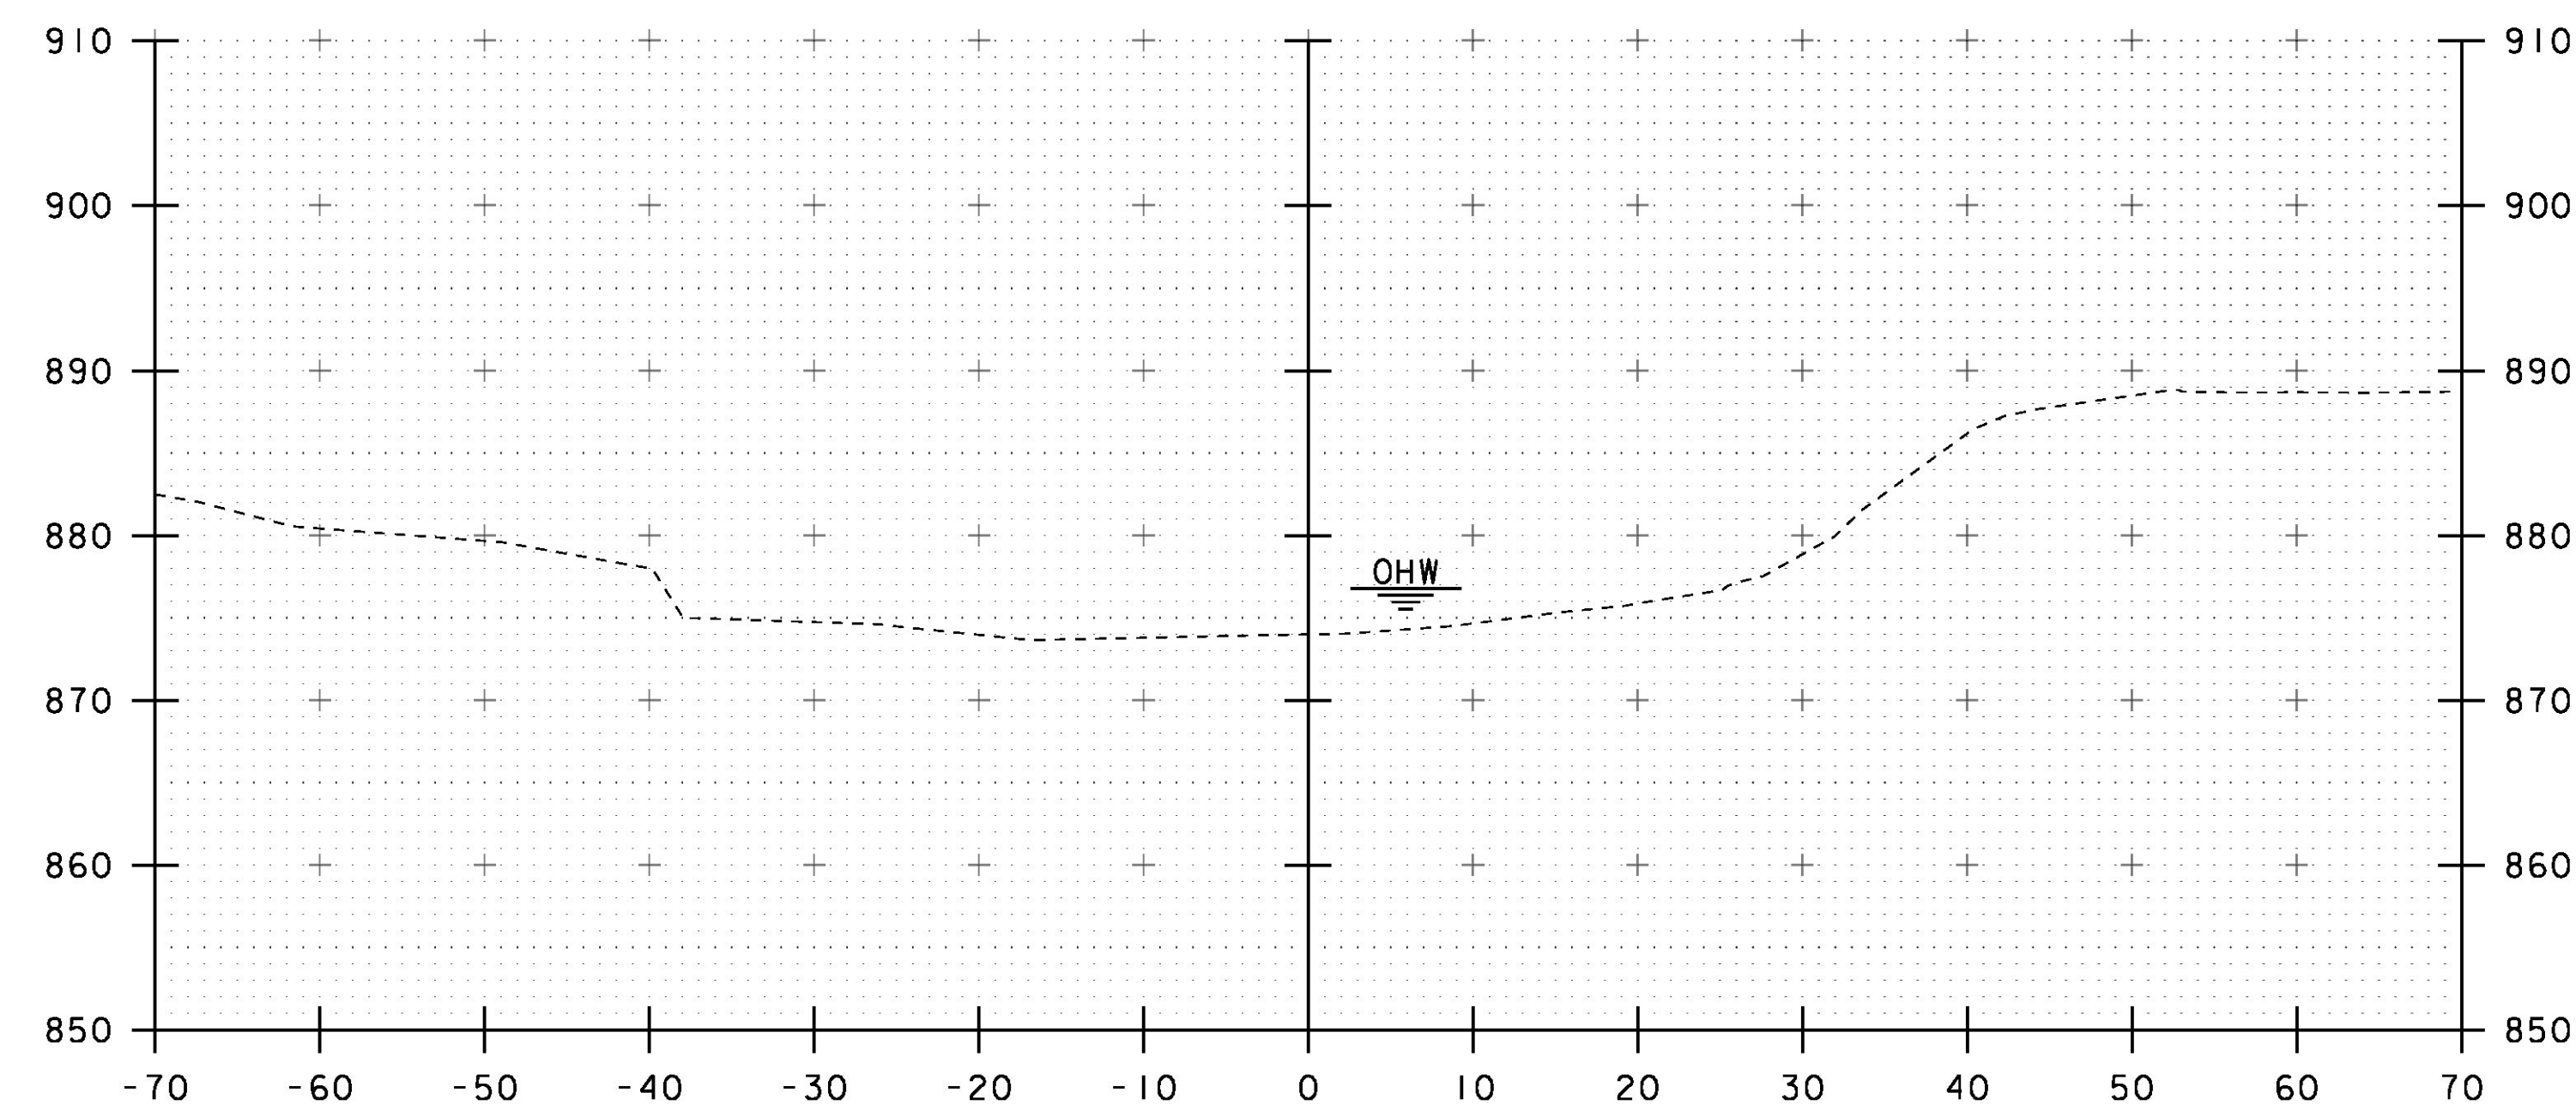

STA 50+65.00 RT
 BEGIN STONE FILL, TYPE III
 GEOTEXTILE UNDER STONE FILL
 GRUBBING MATERIAL
 UNCLASSIFIED CHANNEL EXCAVATION

50+60

STA. 50+40 TO STA. 50+70

PROJECT NAME:	STRAFFORD	PLOT DATE:	31-AUG-2016
PROJECT NUMBER:	BF 0177(10)	DRAWN BY:	J. GRIGAS
FILE NAME:	sl3j088xsl.dgn	DESIGNED BY:	J. GRIGAS
PROJECT LEADER:	K. HIGGINS	CHECKED BY:	T. MATTHEWS
CHANNEL SECTIONS 2		SHEET	43 OF 52