



STA 51+35.00 LT
 END STONE FILL, TYPE III
 GEOTEXTILE UNDER STONE FILL
 GRUBBING MATERIAL
 UNCLASSIFIED CHANNEL EXCAVATION

51+30

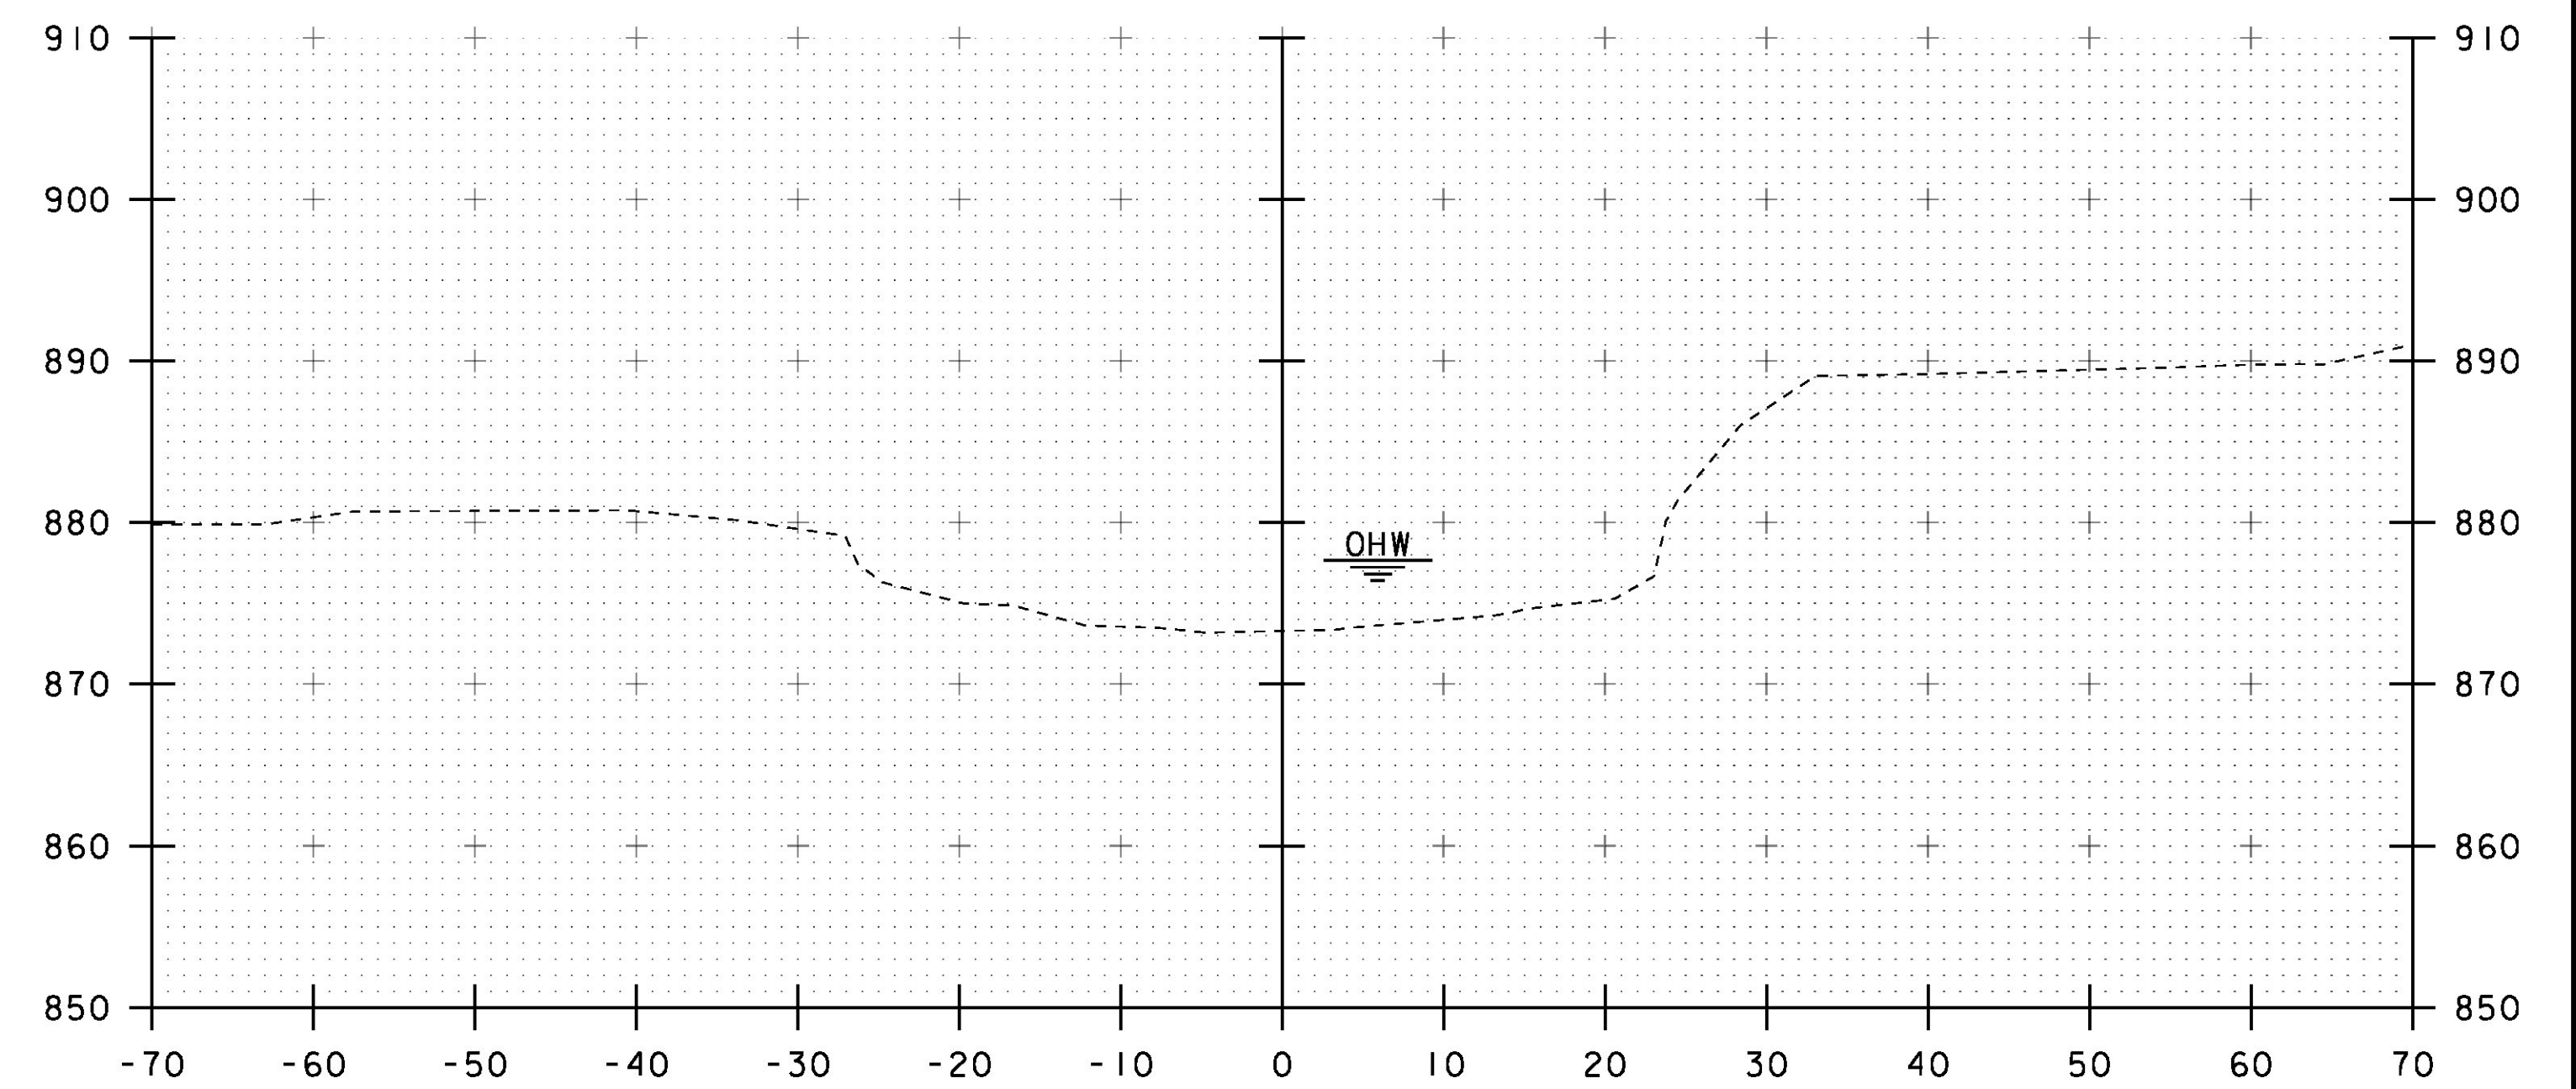

51+50

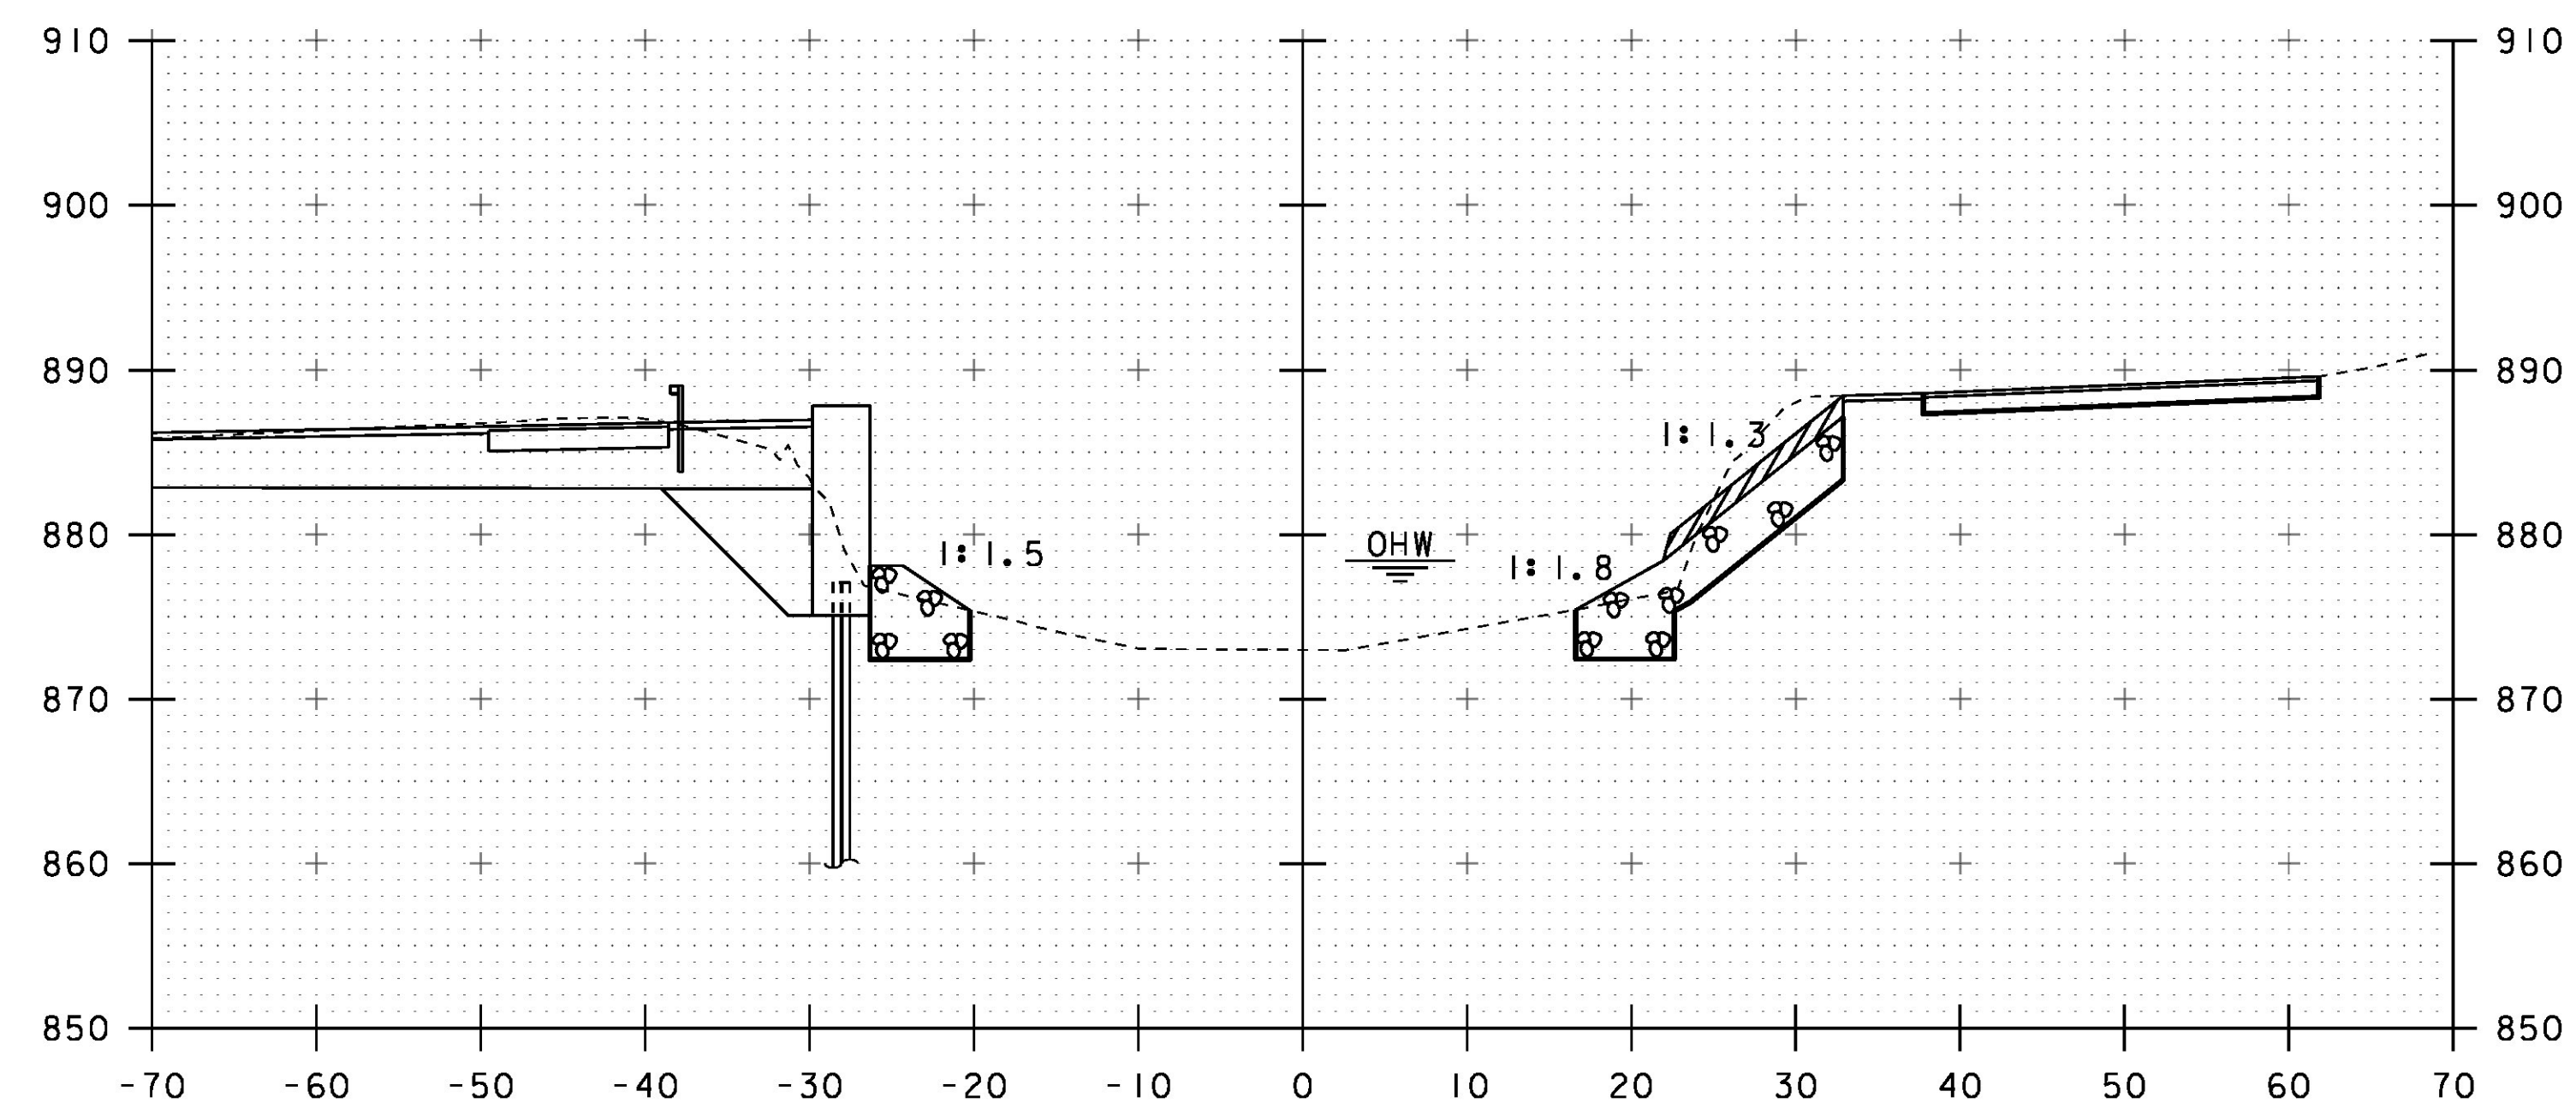


STA 51+18.00 LT
 BEGIN GRUBBING MATERIAL

51+20

STA 51+11.00 RT
 BEGIN GRUBBING MATERIAL

STA 51+29.00 RT
 END STONE FILL, TYPE III
 GEOTEXTILE UNDER STONE FILL
 GRUBBING MATERIAL
 UNCLASSIFIED CHANNEL EXCAVATION

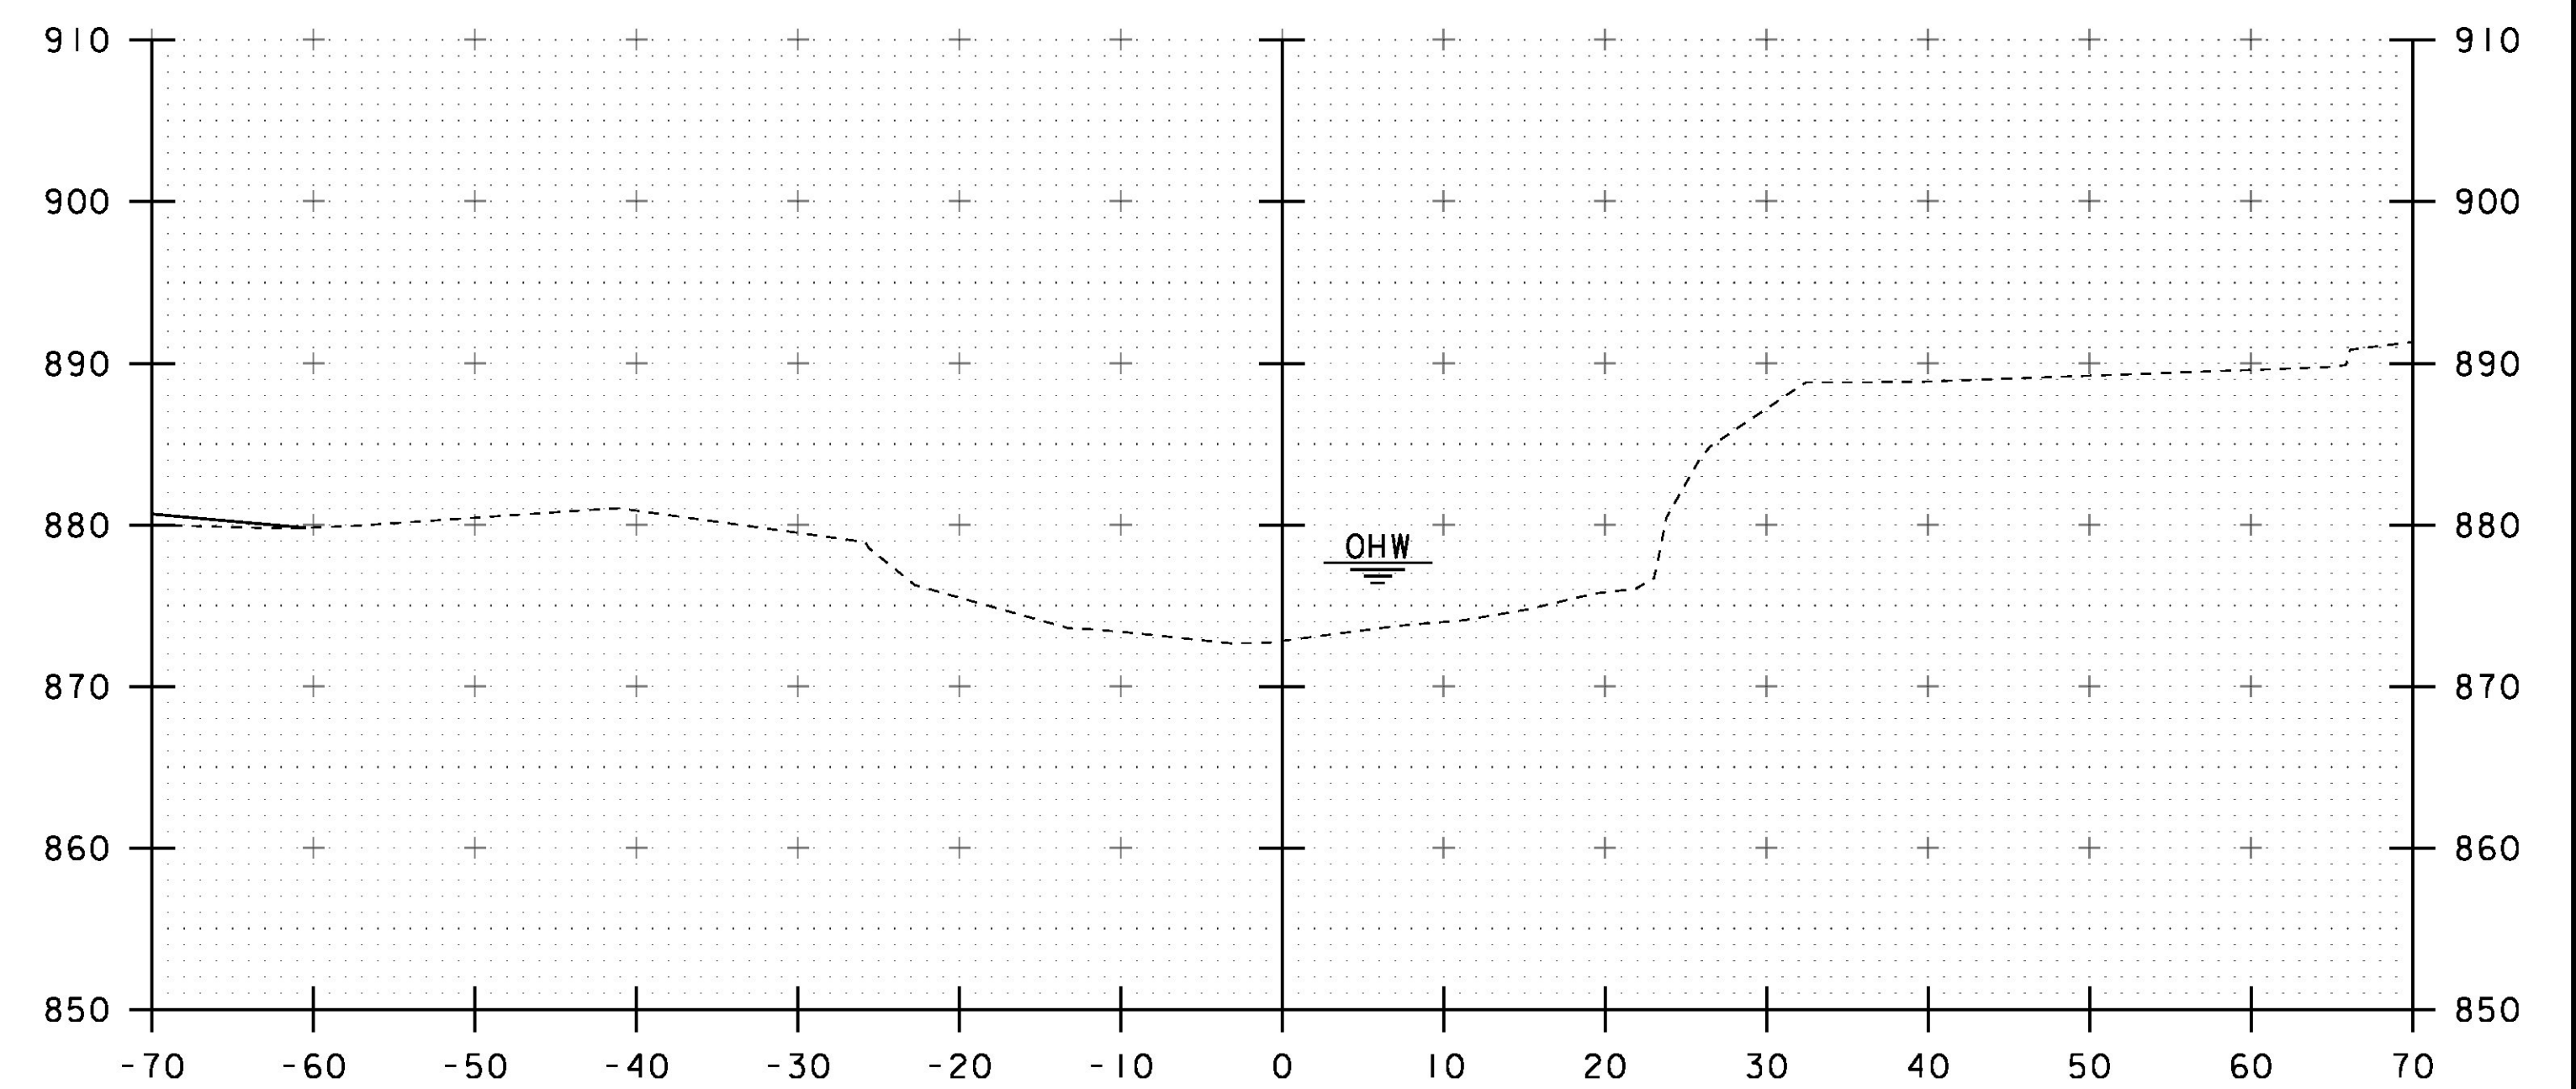

51+40

STA. 51+20 TO STA. 51+50

PROJECT NAME:	STRAFFORD	PLOT DATE:	31-AUG-2016
PROJECT NUMBER:	BF 0177(10)	DRAWN BY:	J. GRIGAS
FILE NAME:	sl3j088xsl.dgn	CHECKED BY:	T. MATTHEWS
PROJECT LEADER:	K. HIGGINS	CHANNEL SECTIONS	4
DESIGNED BY:	J. GRIGAS	SHEET	45 OF 52