




51+70

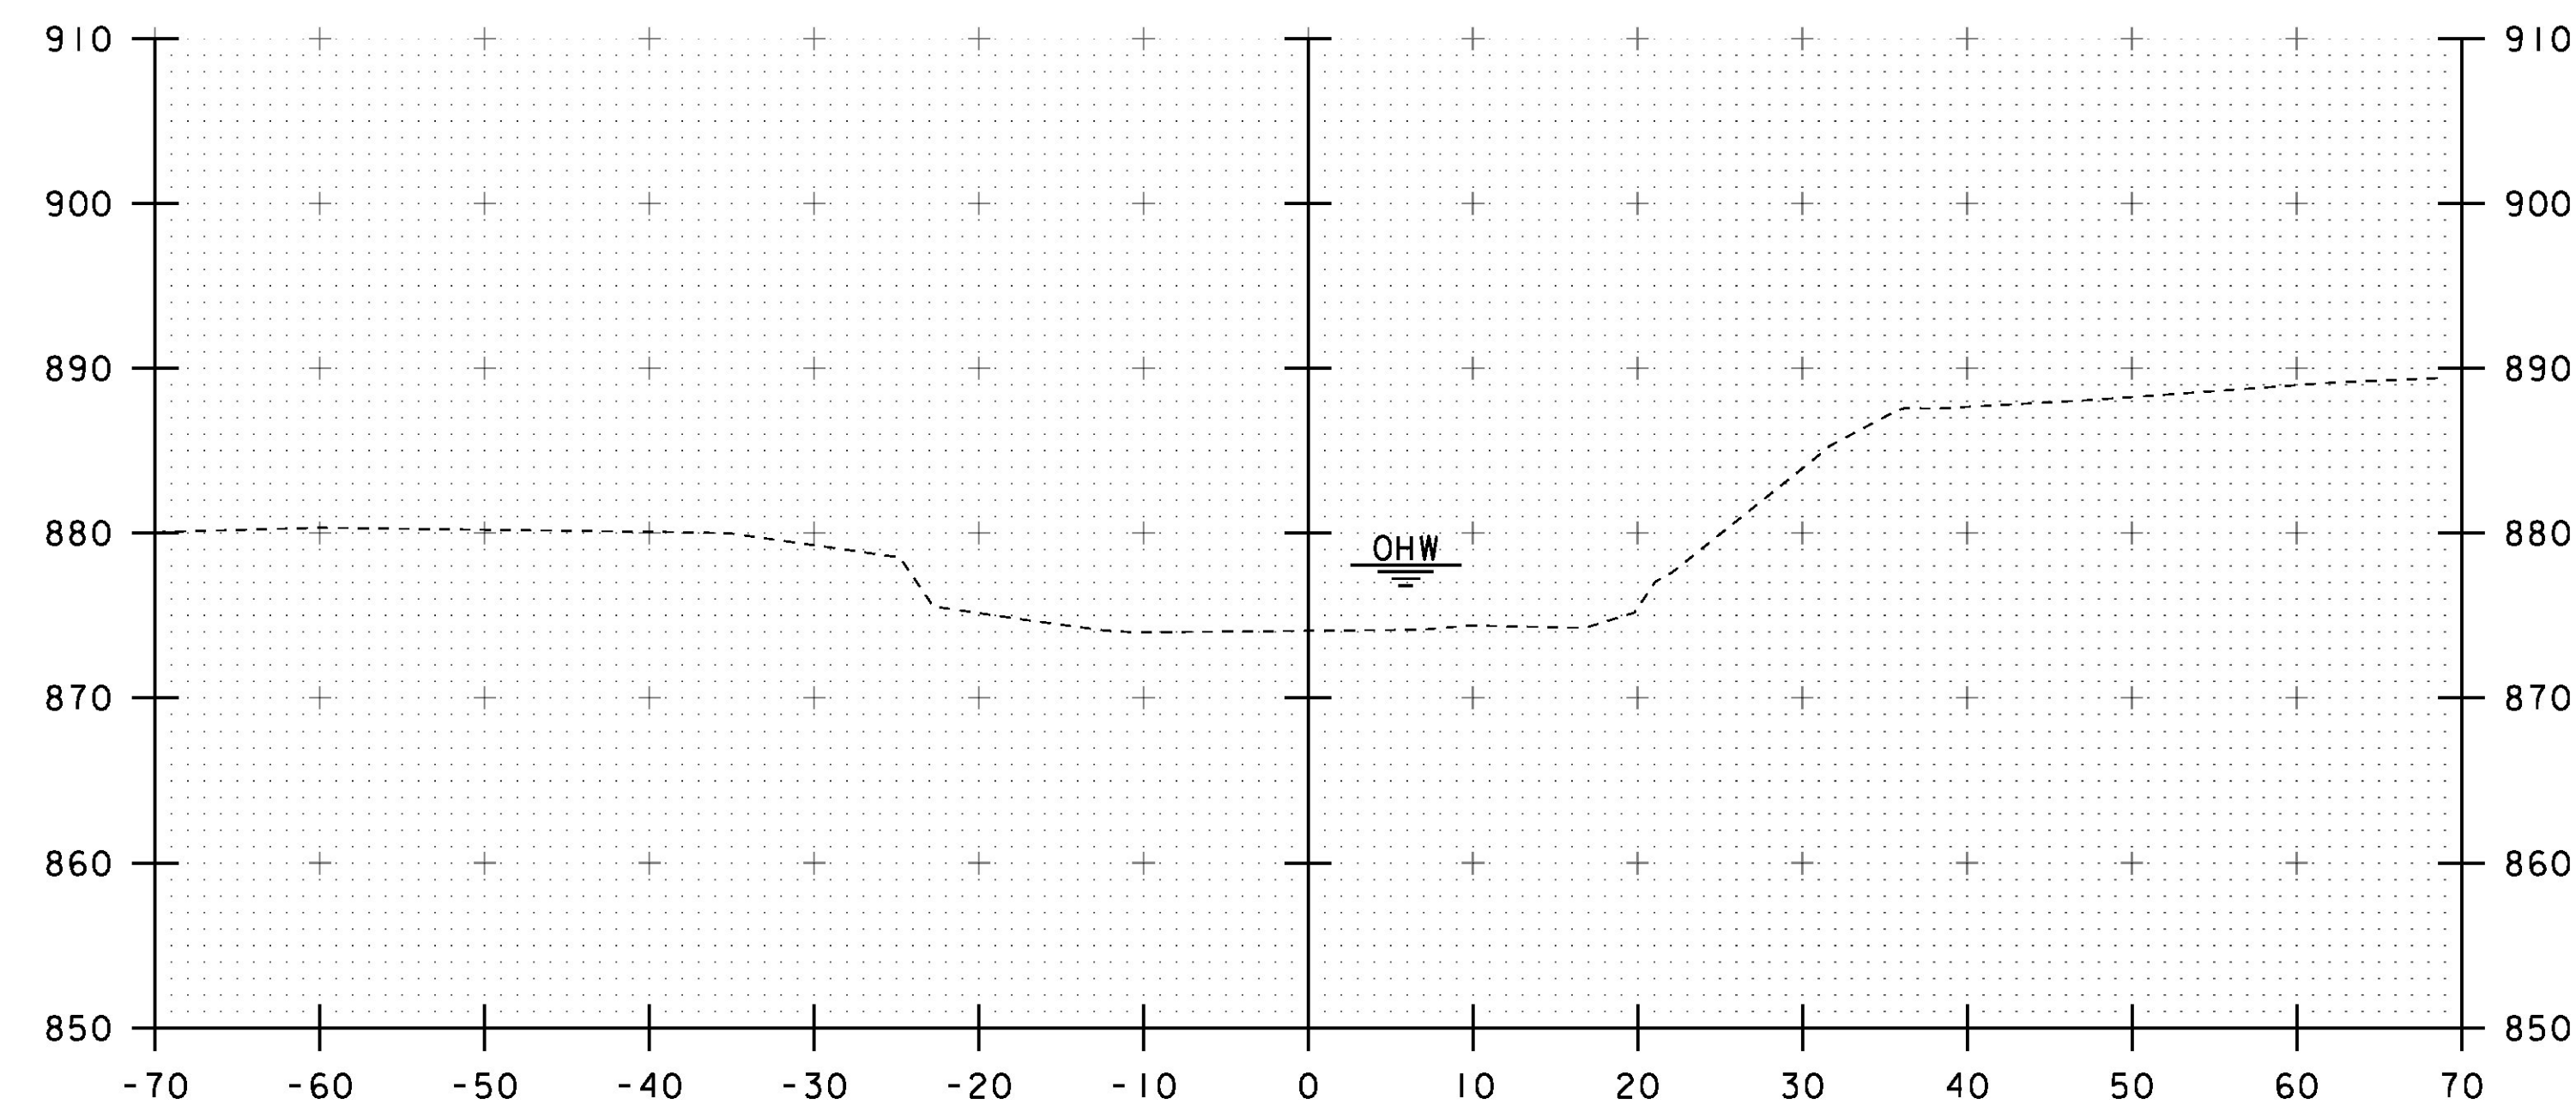

51+90

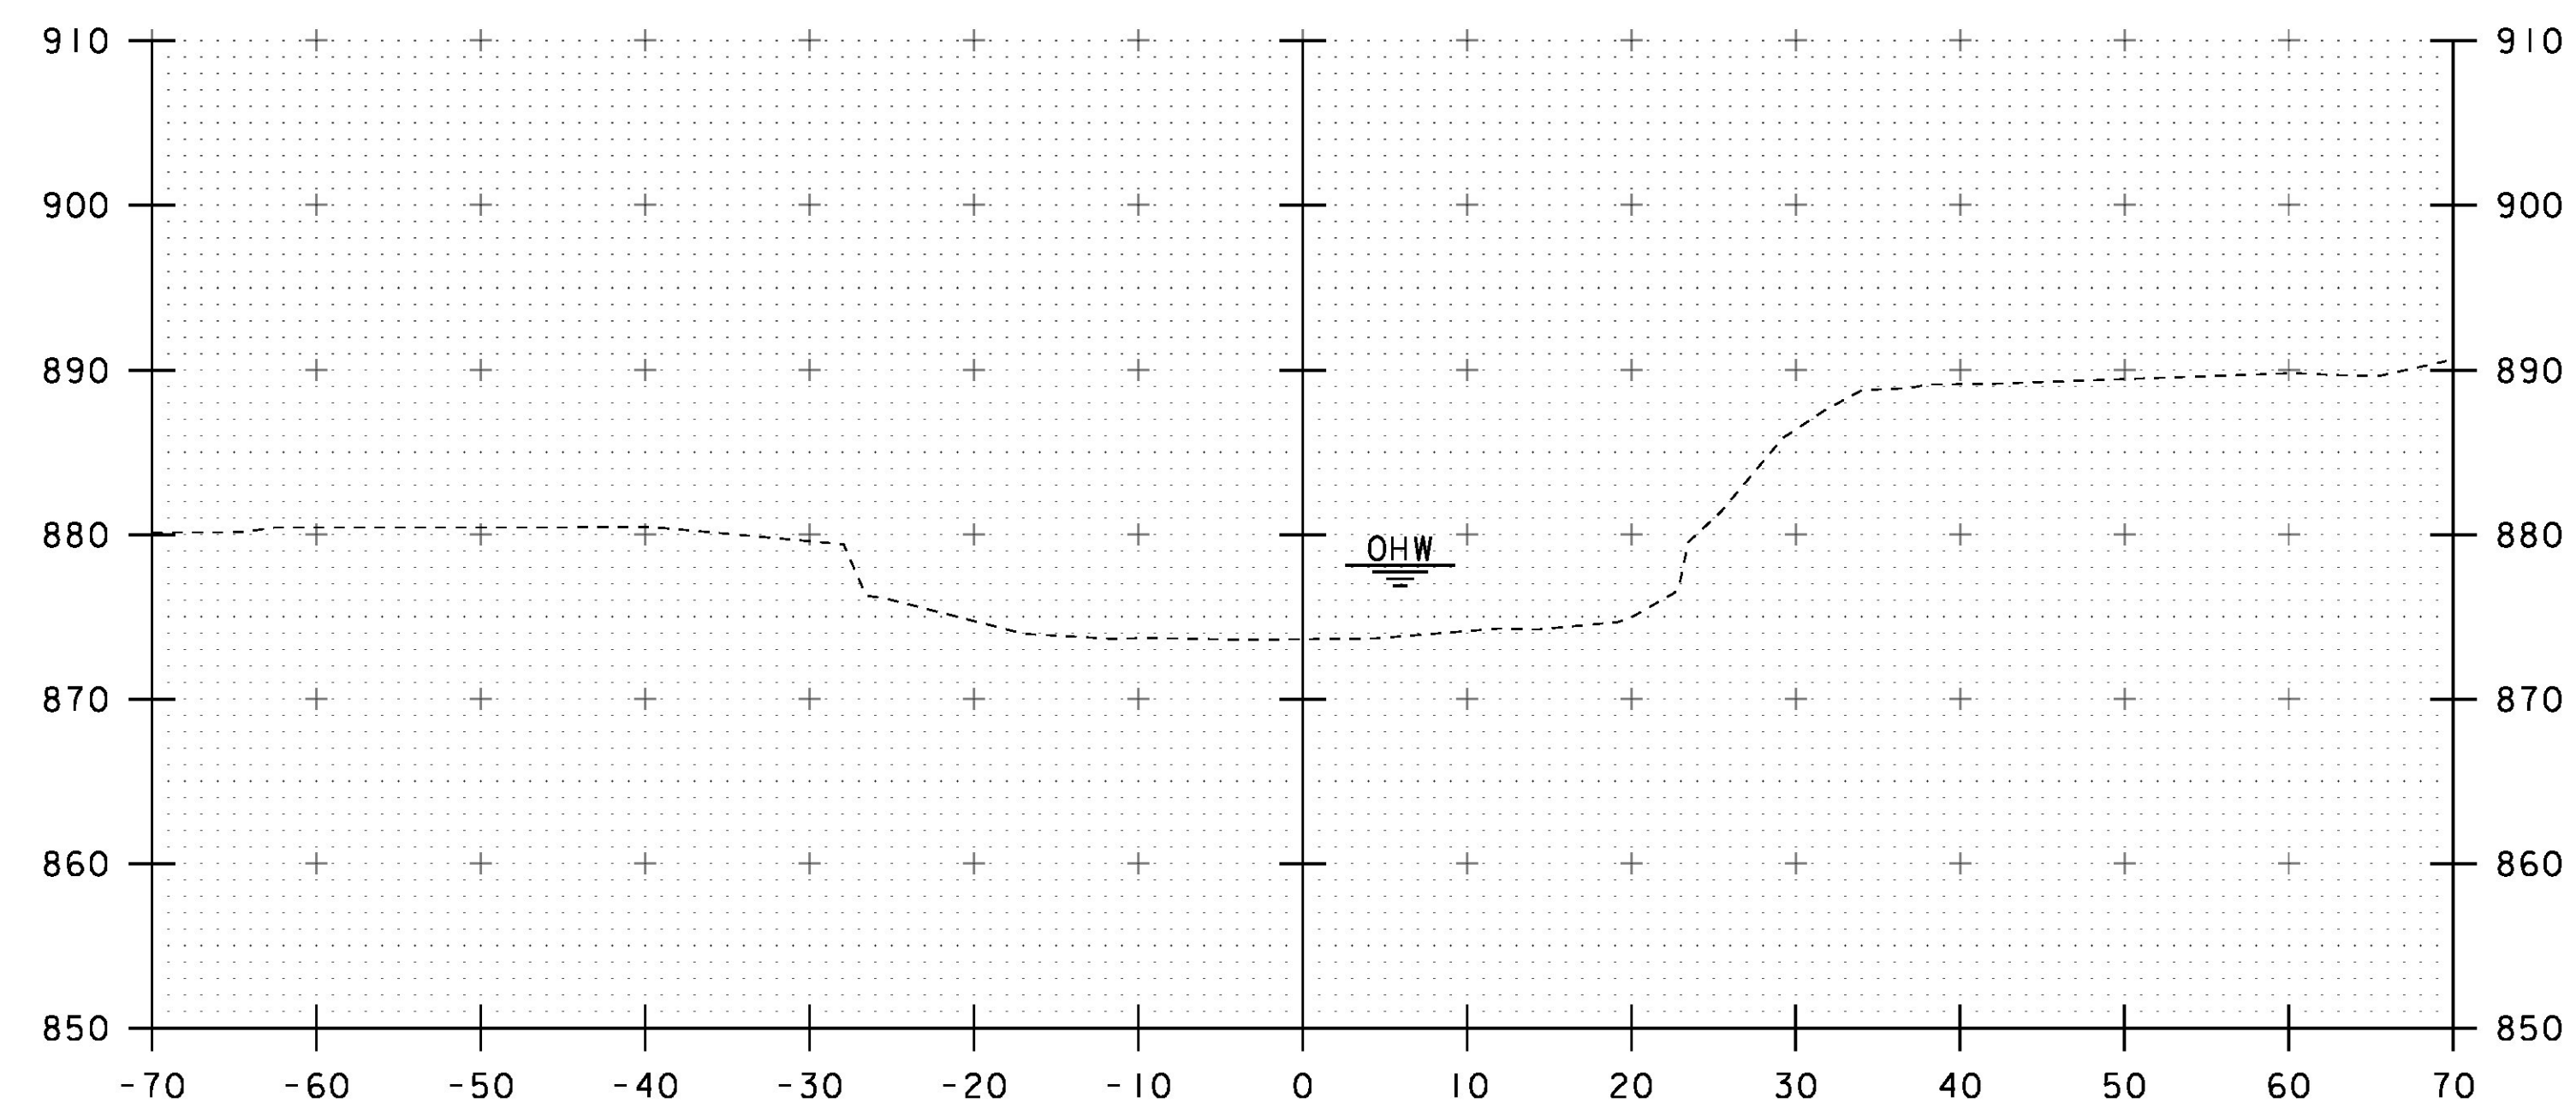

51+60

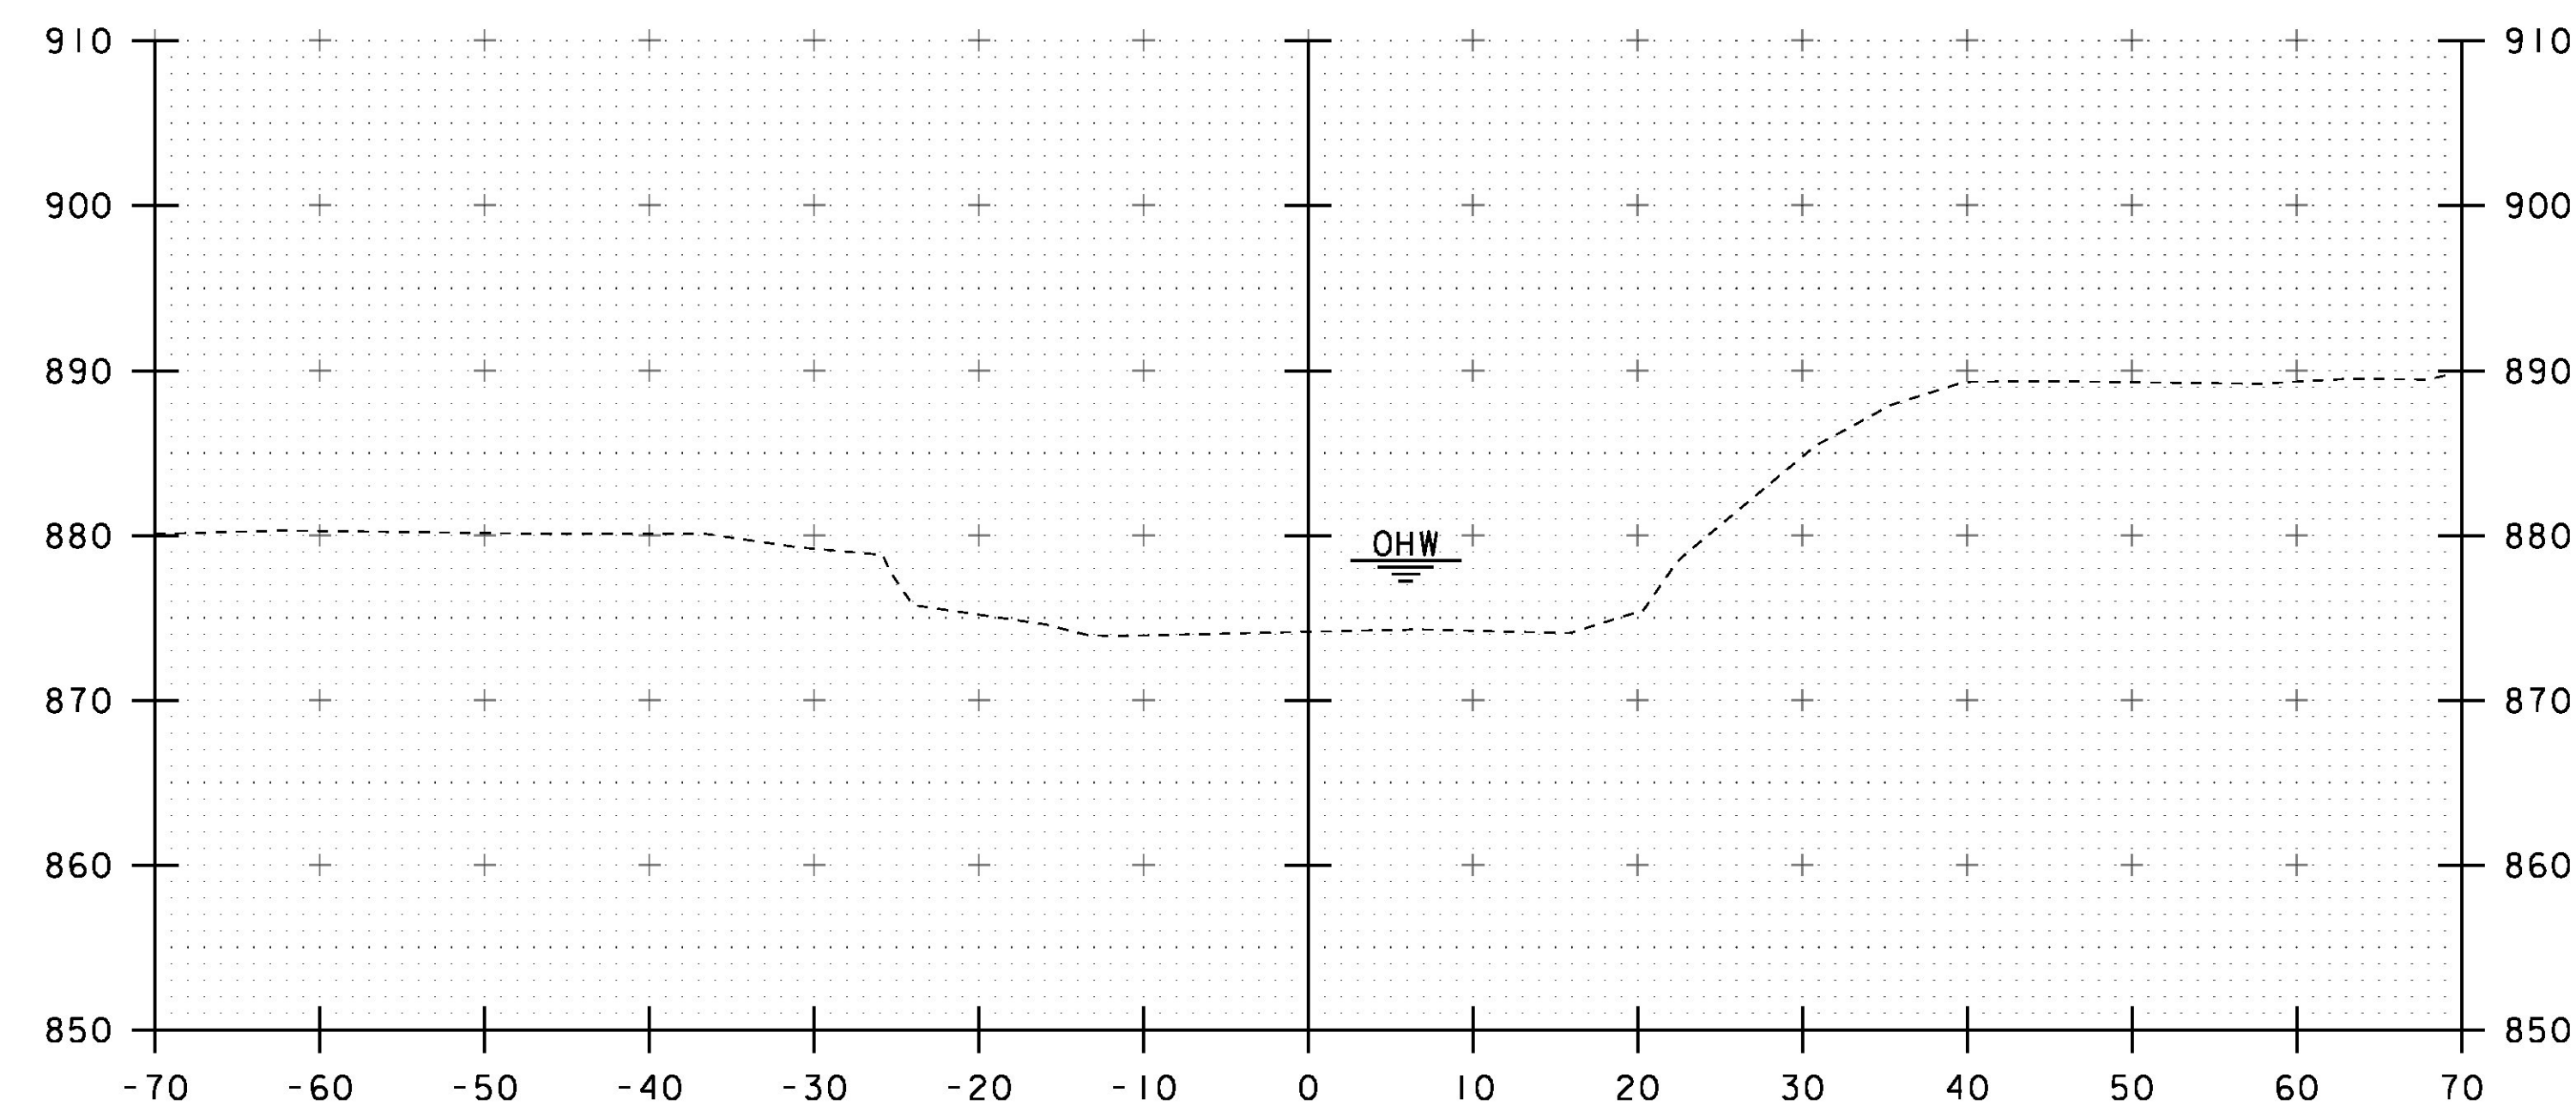

51+80

STA. 51+60 TO STA. 51+90

PROJECT NAME:	STRAFFORD
PROJECT NUMBER:	BF 0177(10)
FILE NAME:	sl3j088xsl.dgn
PROJECT LEADER:	K. HIGGINS
DESIGNED BY:	J. GRIGAS
CHANNEL SECTIONS	5
PLOT DATE:	31-AUG-2016
DRAWN BY:	J. GRIGAS
CHECKED BY:	T. MATTHEWS
SHEET	46 OF 52