


BEGIN APPROACH

END APPROACH

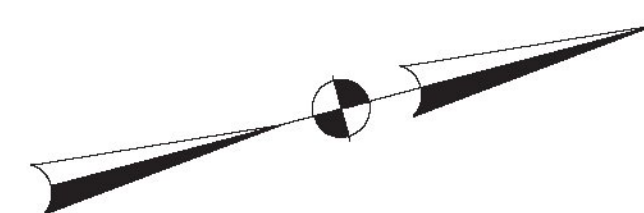

**APPROACH SLAB PLAN**  
CONTRACT DWG. REF. 35 OF 52

**FOR APPROVAL**

WORK THIS DRAWING WITH  
DRAWING P1

**LEGEND:**

CONT.-CONTINUOUS	E.E.-EACH END
TRANS.-TRANSVERSE	E.F.-EACH FACE
DWLS.-DOWELS	N.F.-NEAR FACE
VERTS.-VERTICAL	F.F.-FAR FACE
HORIZ.-HORIZONTAL	E.W.-EACH WAY
T&B -TOP & BOTTOM	O.C.-ON CENTER
I.F.-INNER FACE	L.W.-LONG WAY
O.F.-OUTER FACE	S.W.-SHORT WAY

EPOXY REINF. BARS ASTM A615  
GRADE 60, MARKED (E).  
EPOXY COATING TO MEET AASHTO  
M284/ASTM A775.

REINF. BARS ASTM A615 GRADE 60

ELEVATIONS & DIMENSIONS SHOWN  
ON THIS DWG. ARE FOR REINF.  
DETAILING PURPOSES ONLY AND ARE  
NOT INTENDED FOR DIMENSIONAL  
CONSTRUCTION.

VERIFICATION OF UNCLEAR INFORMATION  
MAY BE REQUESTED ON THIS DRAWING.  
SHOULD VERIFICATION BE LEFT  
UN-ADDRESSED IT WILL REMAIN AS  
SHOWN AND ASSUME TO BE CORRECT.

6			
5			
4			
3	1/24/17	-	NO CHANGE / REV. 1 FOR APPROVAL
2	1/4/17		REVISED PER APPROVAL / FOR APPROVAL
1	12/16/16	-	FOR APPROVAL
	DATE	REV.#	SENT FOR
<b>DIMENSION</b> DIMENSION FABRICATORS INC. <small>2000 7TH STREET SCOTIA, N.Y. 12302 PH: (518) 374-1936 FAX (518) 374-4830 www.dimensionfabricators.com</small>			
STRUCTURE	VTAOT STRAFFORD BF0177(10)		
LOCATION	TOWN OF STRAFFORD, ORANGE COUNTY, VT		
ARCHITECT			
ENGINEER			
CUSTOMER	MILLER CONSTRUCTION		
DRAWN BY	DATE	DFI #	
CMB	12/15/16	10098	
DRAWING COVERS			DRAWING #
APPROACH SLABS			P

Vermont Agency of Transportation  
**RECEIVED**

CK'D BY TAM OK'D BY JDG

February 13, 2017

RESUBMIT No Approved  
BY K. Higgins DATE 02/24/2017