
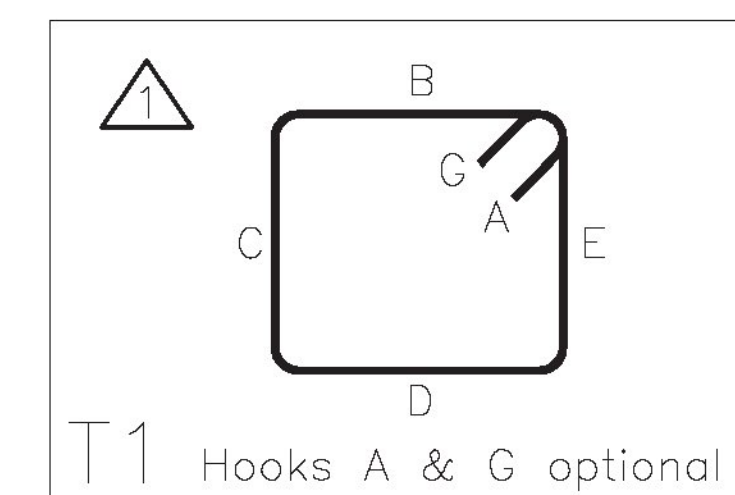
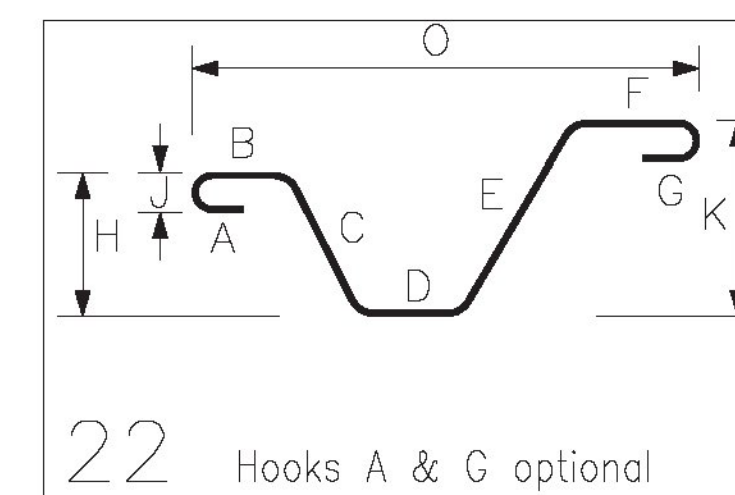
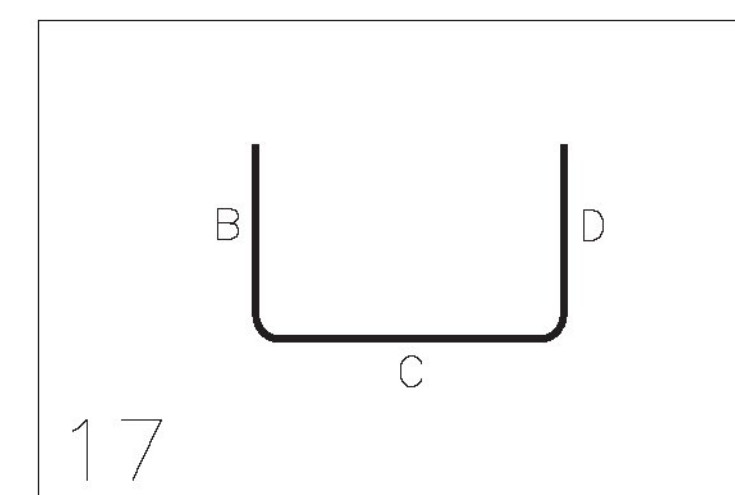
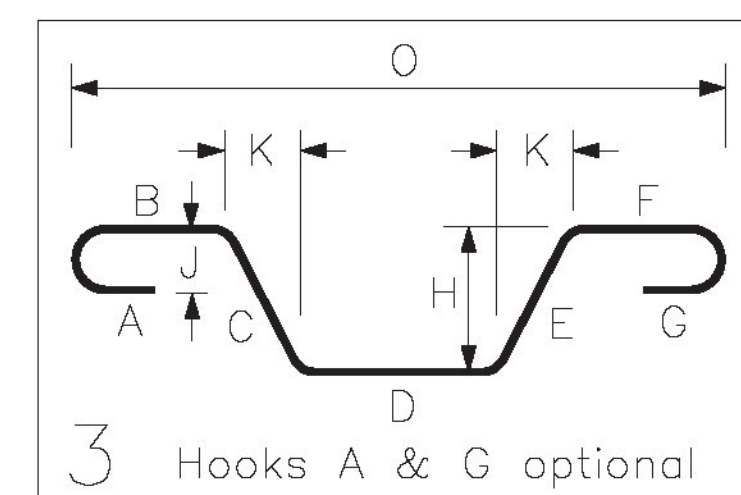
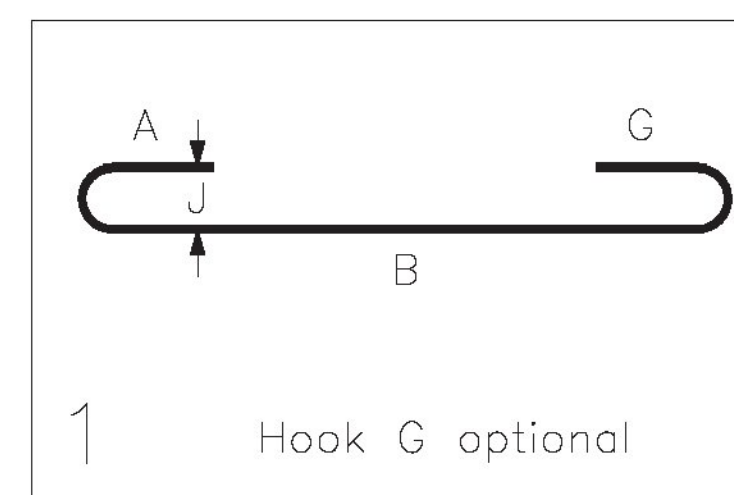


Release Number:

BAR LIST  

Bar Mark	Qty	Size	Total Length	Type	'A'	'B'	'C'	'D'	'E'	'F'	'G'	'H'	'J'	'K'	'O'	'R'
5A01	72	#5	6'-7"	17		1'-9"	3'-1"	1'-9"								
5A02	26	#5	4'-5"	1	0'-7"	3'-10"							0'-5"			
5AE01	12	#5	6'-7"	17		1'-9"	3'-1"	1'-9"								
5AE02	2	#5	5'-10 1/4"	3		5'-3"	0'-7 1/4"					0'-3 1/4"		0'-7 1/4"	5'-10 1/4"	
5AE03	10	#5	4'-5"	1	0'-7"	3'-10"							0'-5"			
6A01	8	#6	8'-3"	3			3'-5"	1'-5"	3'-5"			2'-11 1/2"		1'-8 1/2"	4'-10"	
6A02	4	#6	6'-11"	22			2'-1"	1'-5"	3'-5"			1'-9 1/2"		2'-11 1/2"	4'-2 1/4"	
8AE01	18	#8	12'-0 1/2"	1	0'-11"	11'-1 1/2"							0'-8"			
8AE02	20	#8	12'-4"	1	0'-11"	11'-5"							0'-8"			
8AE03	19	#8	12'-7"	1	0'-11"	11'-8"							0'-8"			
4A01	24	#4	2'-9"	T1	0'-4 1/2"	0'-6"	0'-6"	0'-6"	0'-6"		0'-4 1/2"					
5AE04a	2	#5	9'-7"	0		9'-7"										
Varies To																
5AE04g	2	#5	11'-7"	0		11'-7"										

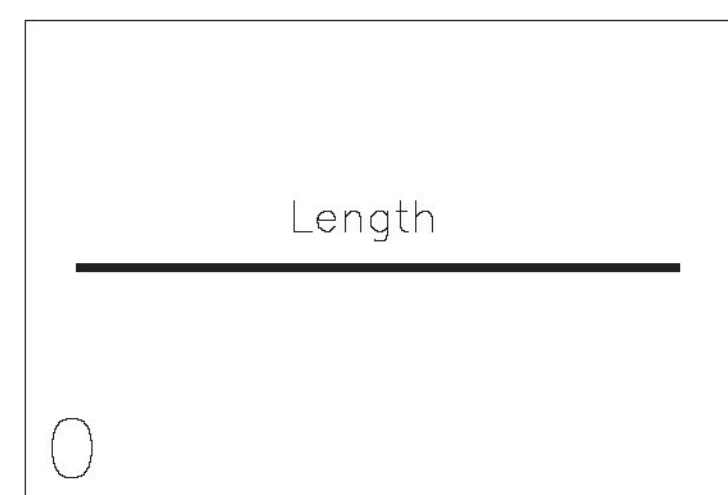

 BAR MARKS MAY CHANGE, DUE TO REVISIONS

 2 TEST BARS AT 30" LONG WILL BE PROVIDED FOR EACH 15 TONS OF EACH BAR SIZE OF EACH DELIVERY

FOR APPROVAL

WORK THIS DRAWING WITH DRAWINGS A, A1, & A2

LEGEND:

CONT.-CONTINUOUS	E.E.-EACH END
TRANS.-TRANSVERSE	E.F.-EACH FACE
DWLS.-DOWELS	N.F.-NEAR FACE
VERTS.-VERTICAL	F.F.-FAR FACE
HORIZ.-HORIZONTAL	E.W.-EACH WAY
T&B -TOP & BOTTOM	O.C.-ON CENTER
I.F.-INNER FACE	L.W.-LONG WAY
O.F.-OUTER FACE	S.W.-SHORT WAY




EPOXY REINF. BARS ASTM A615 GRADE 60, MARKED (E). EPOXY COATING TO MEET AASHTO M284/ASTM A775.

REINF. BARS ASTM A615 GRADE 60

ELEVATIONS & DIMENSIONS SHOWN ON THIS DWG. ARE FOR REINF. DETAILING PURPOSES ONLY AND ARE NOT INTENDED FOR DIMENSIONAL CONSTRUCTION.

VERIFICATION OF UNCLEAR INFORMATION MAY BE REQUESTED ON THIS DRAWING. SHOULD VERIFICATION BE LEFT UN-ADDRESSED IT WILL REMAIN AS SHOWN AND ASSUME TO BE CORRECT.

Vermont Agency of Transportation
RECEIVED
Shaded 01/07/10 CIP Abakers 521-2017 - Receipt
 CK'D BY NVDB, JW, KM, TM OK'D BY JG
 March 21, 2017
 RESUBMIT No Approved
 BY K. Higgins DATE 03/23/2017

6			
5	3/9/17		REVISED PER APPROVAL / FOR APPROVAL
4	2/10/17		REVISED PER APPROVAL / FOR APPROVAL
3	1/13/17	-	FOR APPROVAL
2	1/4/17	-	FOR APPROVAL
1	12/16/16	-	FOR APPROVAL
	DATE	REV.#	SENT FOR
 DIMENSION DIMENSION FABRICATORS INC. <small>2000 7TH STREET SCOTIA, N.Y. 12302 PH: (518) 374-1936 FAX (518) 374-4830 www.dimensionfabricators.com</small>			
STRUCTURE	VTAOT STRAFFORD BF0177(10)		
LOCATION	TOWN OF STRAFFORD, ORANGE COUNTY, VT		
ARCHITECT			
ENGINEER			
CUSTOMER	MILLER CONSTRUCTION		
DRAWN BY	DATE	DFI #	
CMB	12/12/16	10098	
DRAWING COVERS		DRAWING #	
ABUTMENT 1		A3	