
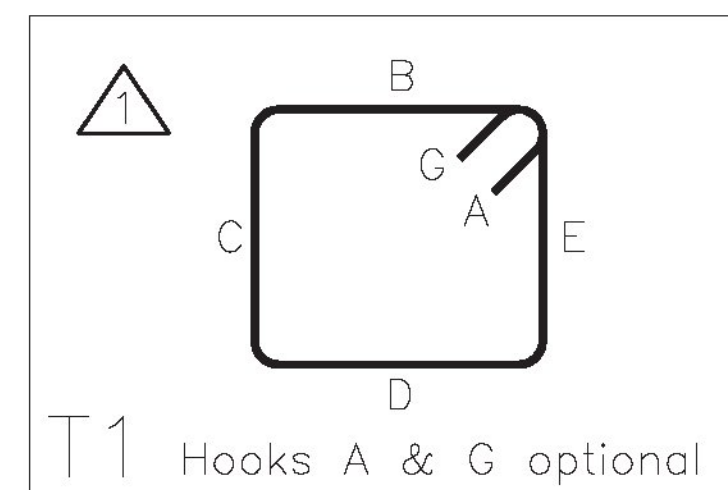
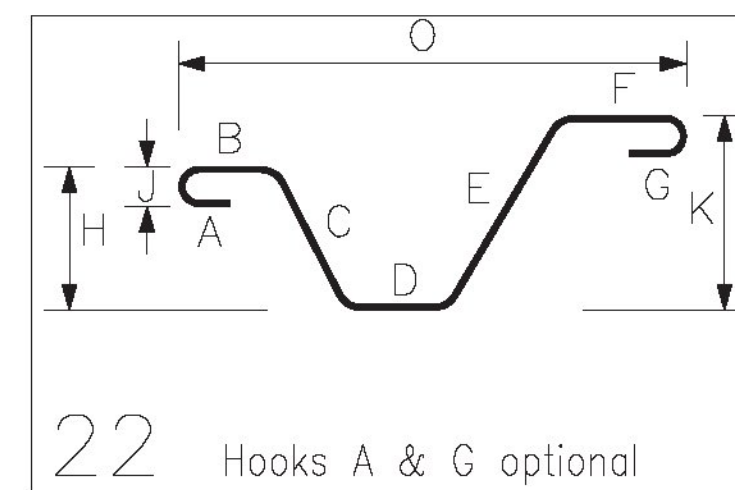
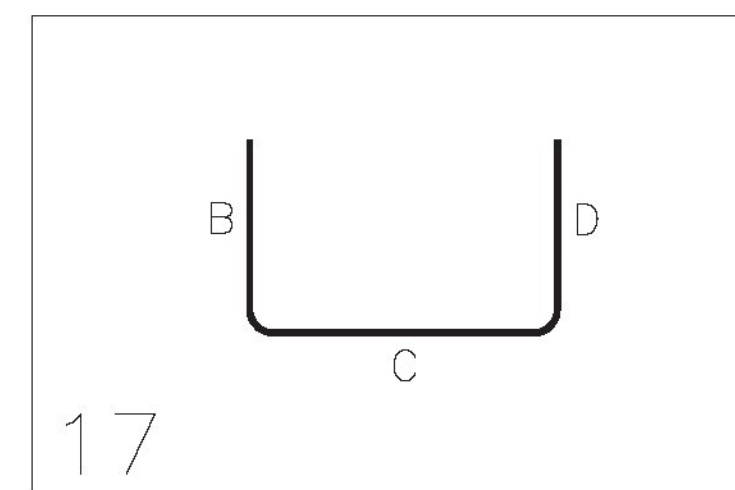
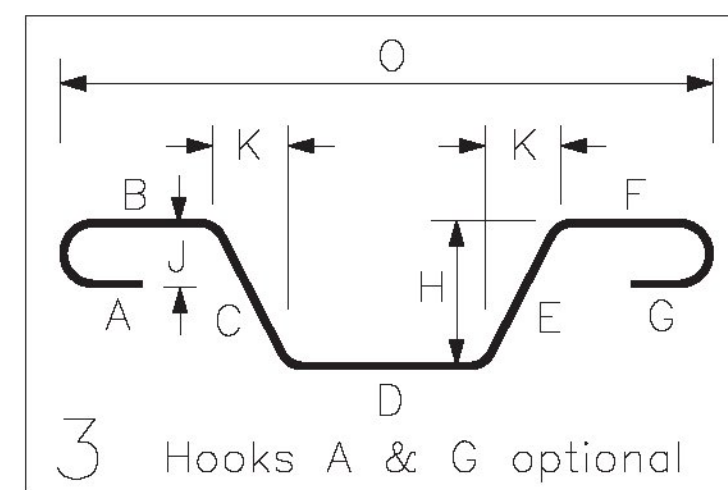


Release Number:

BAR LIST

Bar Mark	Qty	Size	Total Length	Type	'A'	'B'	'C'	'D'	'E'	'F'	'G'	'H'	'J'	'K'	'O'	'R'
5B01	66	#5	6'-7"	17		1'-9"	3'-1"	1'-9"								
5B02	52	#5	4'-5"	1	0'-7"	3'-10"							0'-5"			
5BE01	6	#5	6'-7"	17		1'-9"	3'-1"	1'-9"								
5BE02	20	#5	4'-5"	1	0'-7"	3'-10"							0'-5"			
6B01	8	#6	8'-3"	3			3'-5"	1'-5"	3'-5"			2'-11 1/2"		1'-8 1/2"	4'-10"	
6B02	4	#6	6'-11"	22			2'-1"	1'-5"	3'-5"			1'-9 1/2"		2'-11 1/2"	4'-2 1/4"	
8BE01	19	#8	11'-11"	1	0'-11"	11'-0"							0'-8"			
8BE02	20	#8	12'-5"	1	0'-11"	11'-6"							0'-8"			
8BE03	18	#8	12'-10"	1	0'-11"	11'-11"							0'-8"			
4B01	24	#4	2'-9"	T1	0'-4 1/2"	0'-6"	0'-6"	0'-6"	0'-6"		0'-4 1/2"					

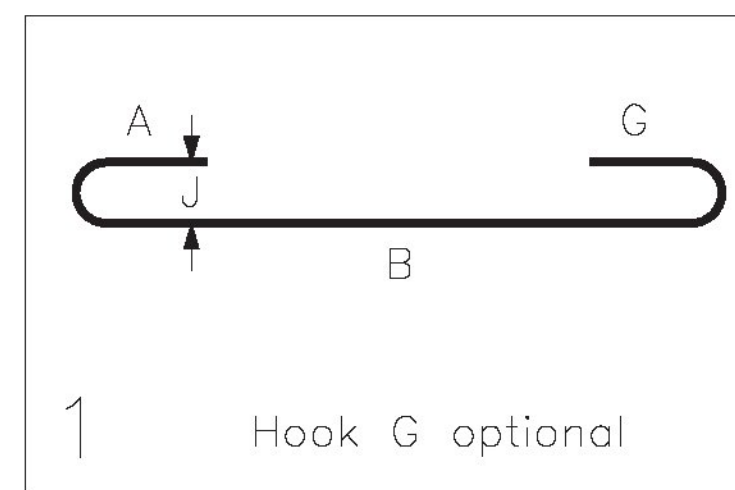

BAR MARKS MAY CHANGE, DUE TO REVISIONS

2 TEST BARS AT 30" LONG WILL BE PROVIDED FOR EACH 15 TONS OF EACH BAR SIZE OF EACH DELIVERY

FOR APPROVAL

WORK THIS DRAWING WITH DRAWINGS B, B1, & B2

LEGEND:

CONT.-CONTINUOUS	E.E.-EACH END
TRANS.-TRANSVERSE	E.F.-EACH FACE
DWLS.-DOWELS	N.F.-NEAR FACE
VERTS.-VERTICAL	F.F.-FAR FACE
HORIZ.-HORIZONTAL	E.W.-EACH WAY
T&B -TOP & BOTTOM	O.C.-ON CENTER
I.F.-INNER FACE	L.W.-LONG WAY
O.F.-OUTER FACE	S.W.-SHORT WAY

EPOXY REINF. BARS ASTM A615 GRADE 60, MARKED (E).
EPOXY COATING TO MEET AASHTO M284/ASTM A775.

REINF. BARS ASTM A615 GRADE 60

ELEVATIONS & DIMENSIONS SHOWN ON THIS DWG. ARE FOR REINF. DETAILING PURPOSES ONLY AND ARE NOT INTENDED FOR DIMENSIONAL CONSTRUCTION.

VERIFICATION OF UNCLEAR INFORMATION MAY BE REQUESTED ON THIS DRAWING. SHOULD VERIFICATION BE LEFT UN-ADDRESSED IT WILL REMAIN AS SHOWN AND ASSUME TO BE CORRECT.

Vermont Agency of Transportation
RECEIVED
CK'D BY NVDB, JW, KM, TM OK'D BY JG
March 21, 2017
RESUBMIT No Approved
BY K. Higgins DATE 03/23/2017

6			
5	3/9/17		REVISED PER APPROVAL / FOR APPROVAL
4	2/10/17		REVISED PER APPROVAL / FOR APPROVAL
3	1/13/17	-	FOR APPROVAL
2	1/4/17	-	FOR APPROVAL
1	12/16/16	-	FOR APPROVAL
	DATE	REV.#	SENT FOR
			VTAOT STRAFFORD BF0177(10)
STRUCTURE			
LOCATION			TOWN OF STRAFFORD, ORANGE COUNTY, VT
ARCHITECT			
ENGINEER			
CUSTOMER			MILLER CONSTRUCTION
DRAWN BY	DATE	DFI #	
CMB	12/13/16	10098	
DRAWING COVERS			DRAWING #
ABUTMENT 2			B3

DIMENSION
DIMENSION FABRICATORS INC. www.dimensionfabricators.com
2000 7TH STREET
SCOTIA, N.Y. 12302
PH: (518) 374-1936
FAX (518) 374-4830