


PLAN VIEW
 1/4" = 1'-0"
 NOTE: DIAPHRAGMS, CONNECTION E'S, &
 PROJECTING REBAR NOT SHOWN FOR CLARITY

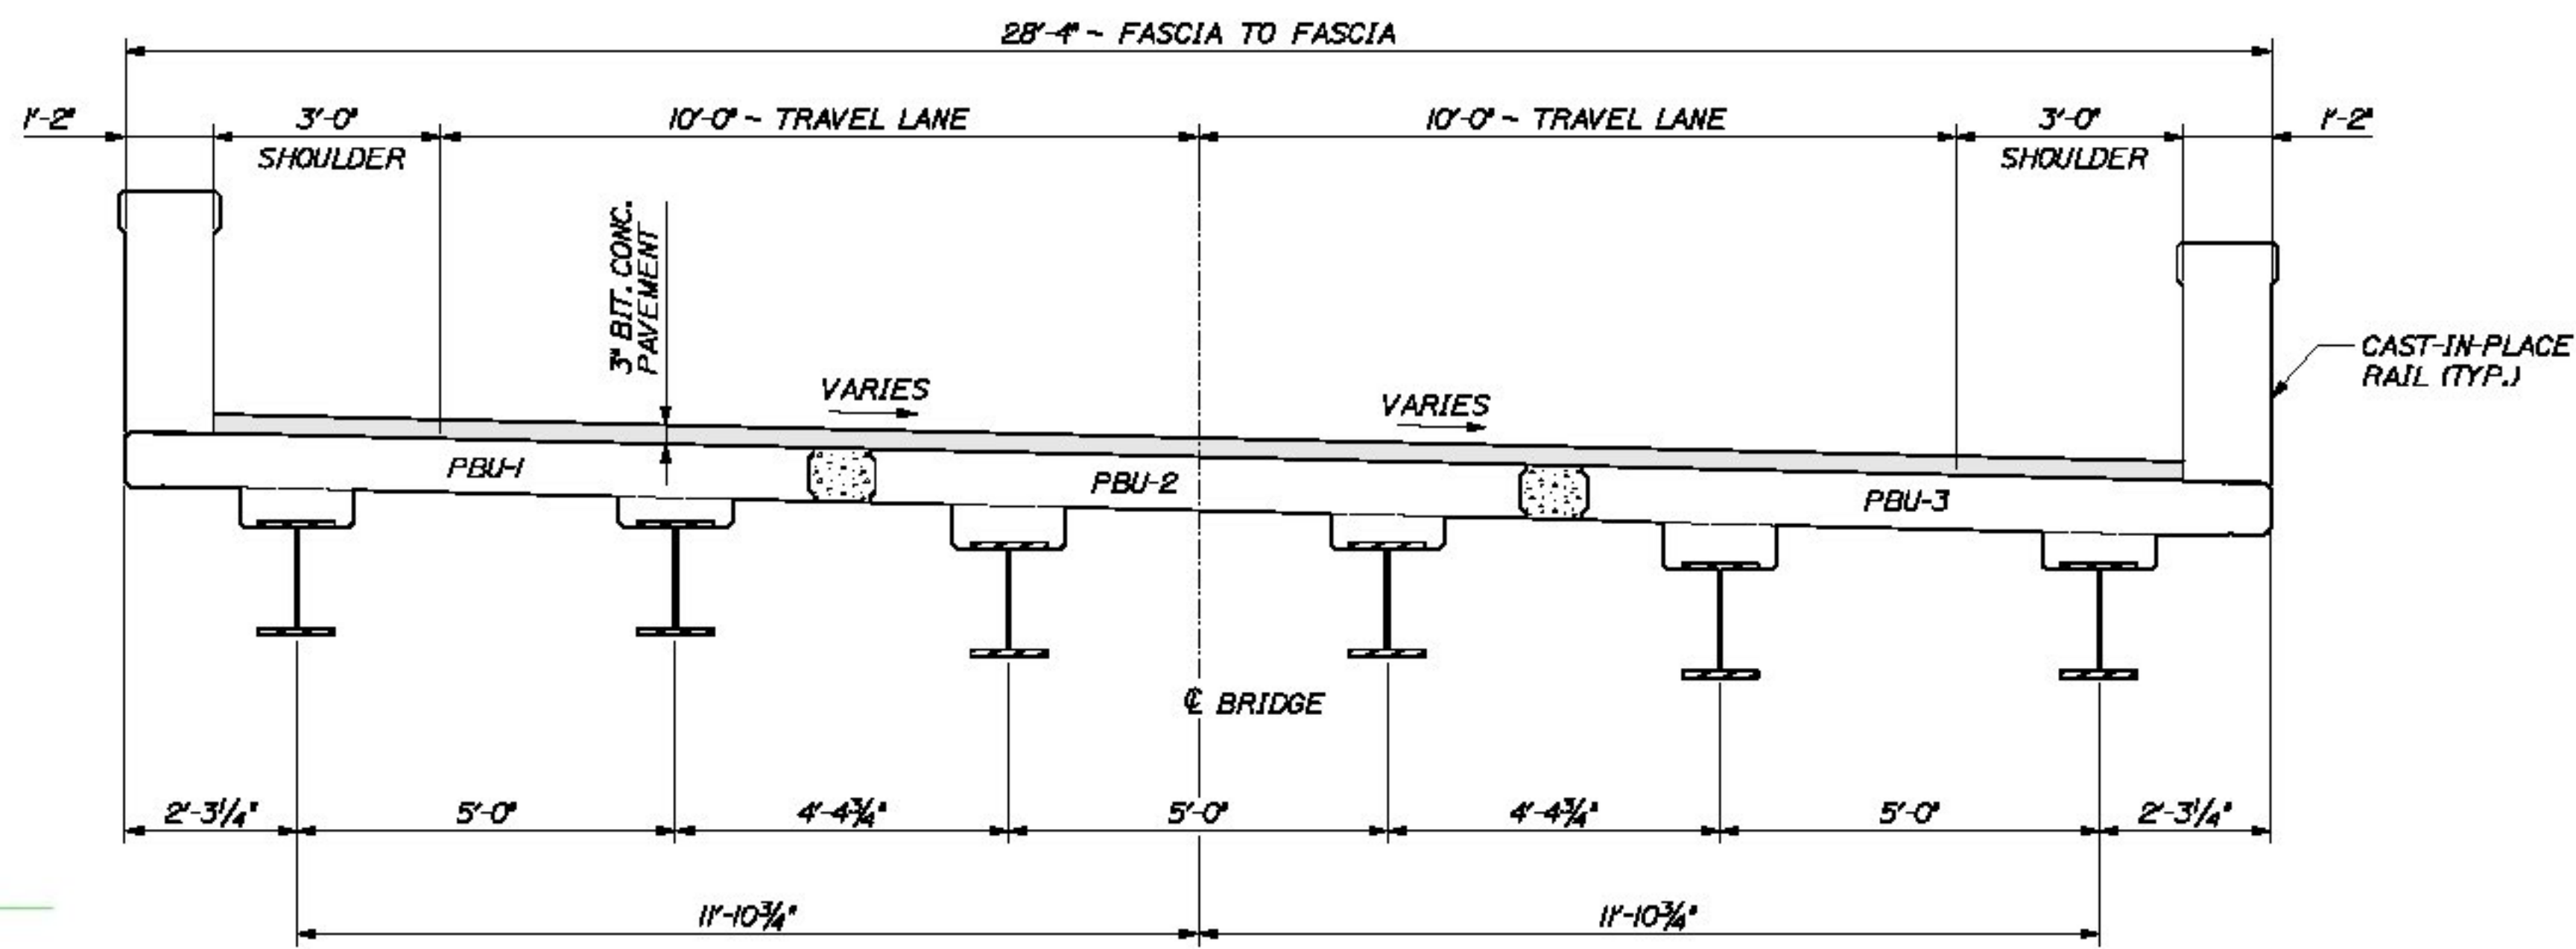

TYPICAL SECTION
 1/2" = 1'-0"
 NOTE: DIAPHRAGMS, CONNECTION E'S, &
 PROJECTING REBAR NOT SHOWN FOR CLARITY

Vermont Agency of Transportation
RECEIVED

CK'D BY TM, JW, NVDB, KM, RK OK'D BY JG

April 12, 2017

RESUBMIT No Approved
 BY K. Higgins DATE 04/13/17

CALDERWOOD ENGINEERING, ETC.
 STRUCTURAL ENGINEERING • DETAILING SERVICES
 222 RIVER RD, RICHMOND, ME 05477-2007 / 737-2008
 PREPARED FOR
MILLER CONSTRUCTION
 STRAFFORD BF 01777(10)



DATE	BY	REVISION
JAN 2017	ETC	DESIGN-DETAILED
		CHECKED-REVIEWED
		REVISION 1
		REVISION 2
		REVISION 3
		REVISION 4
		FIELD CHANGES

STRAFFORD VERMONT
 ABUTMENT SHOP DETAILS
 PBU LAYOUT & DIMENSIONAL DETAILS

SHEET NUMBER
1

