


Miller Construction, Inc.
3103 US Route 5 South
P.O. Box 86
Windsor, Vermont 05089
802-674-5525 Fax: 802-674-5245

JOB STRAFFORD BF 0177 (10)
SHEET NO. 1 OF 1
CALCULATED BY SBS DATE 3/6/17
CHECKED BY _____ DATE _____
SCALE N.T.S.

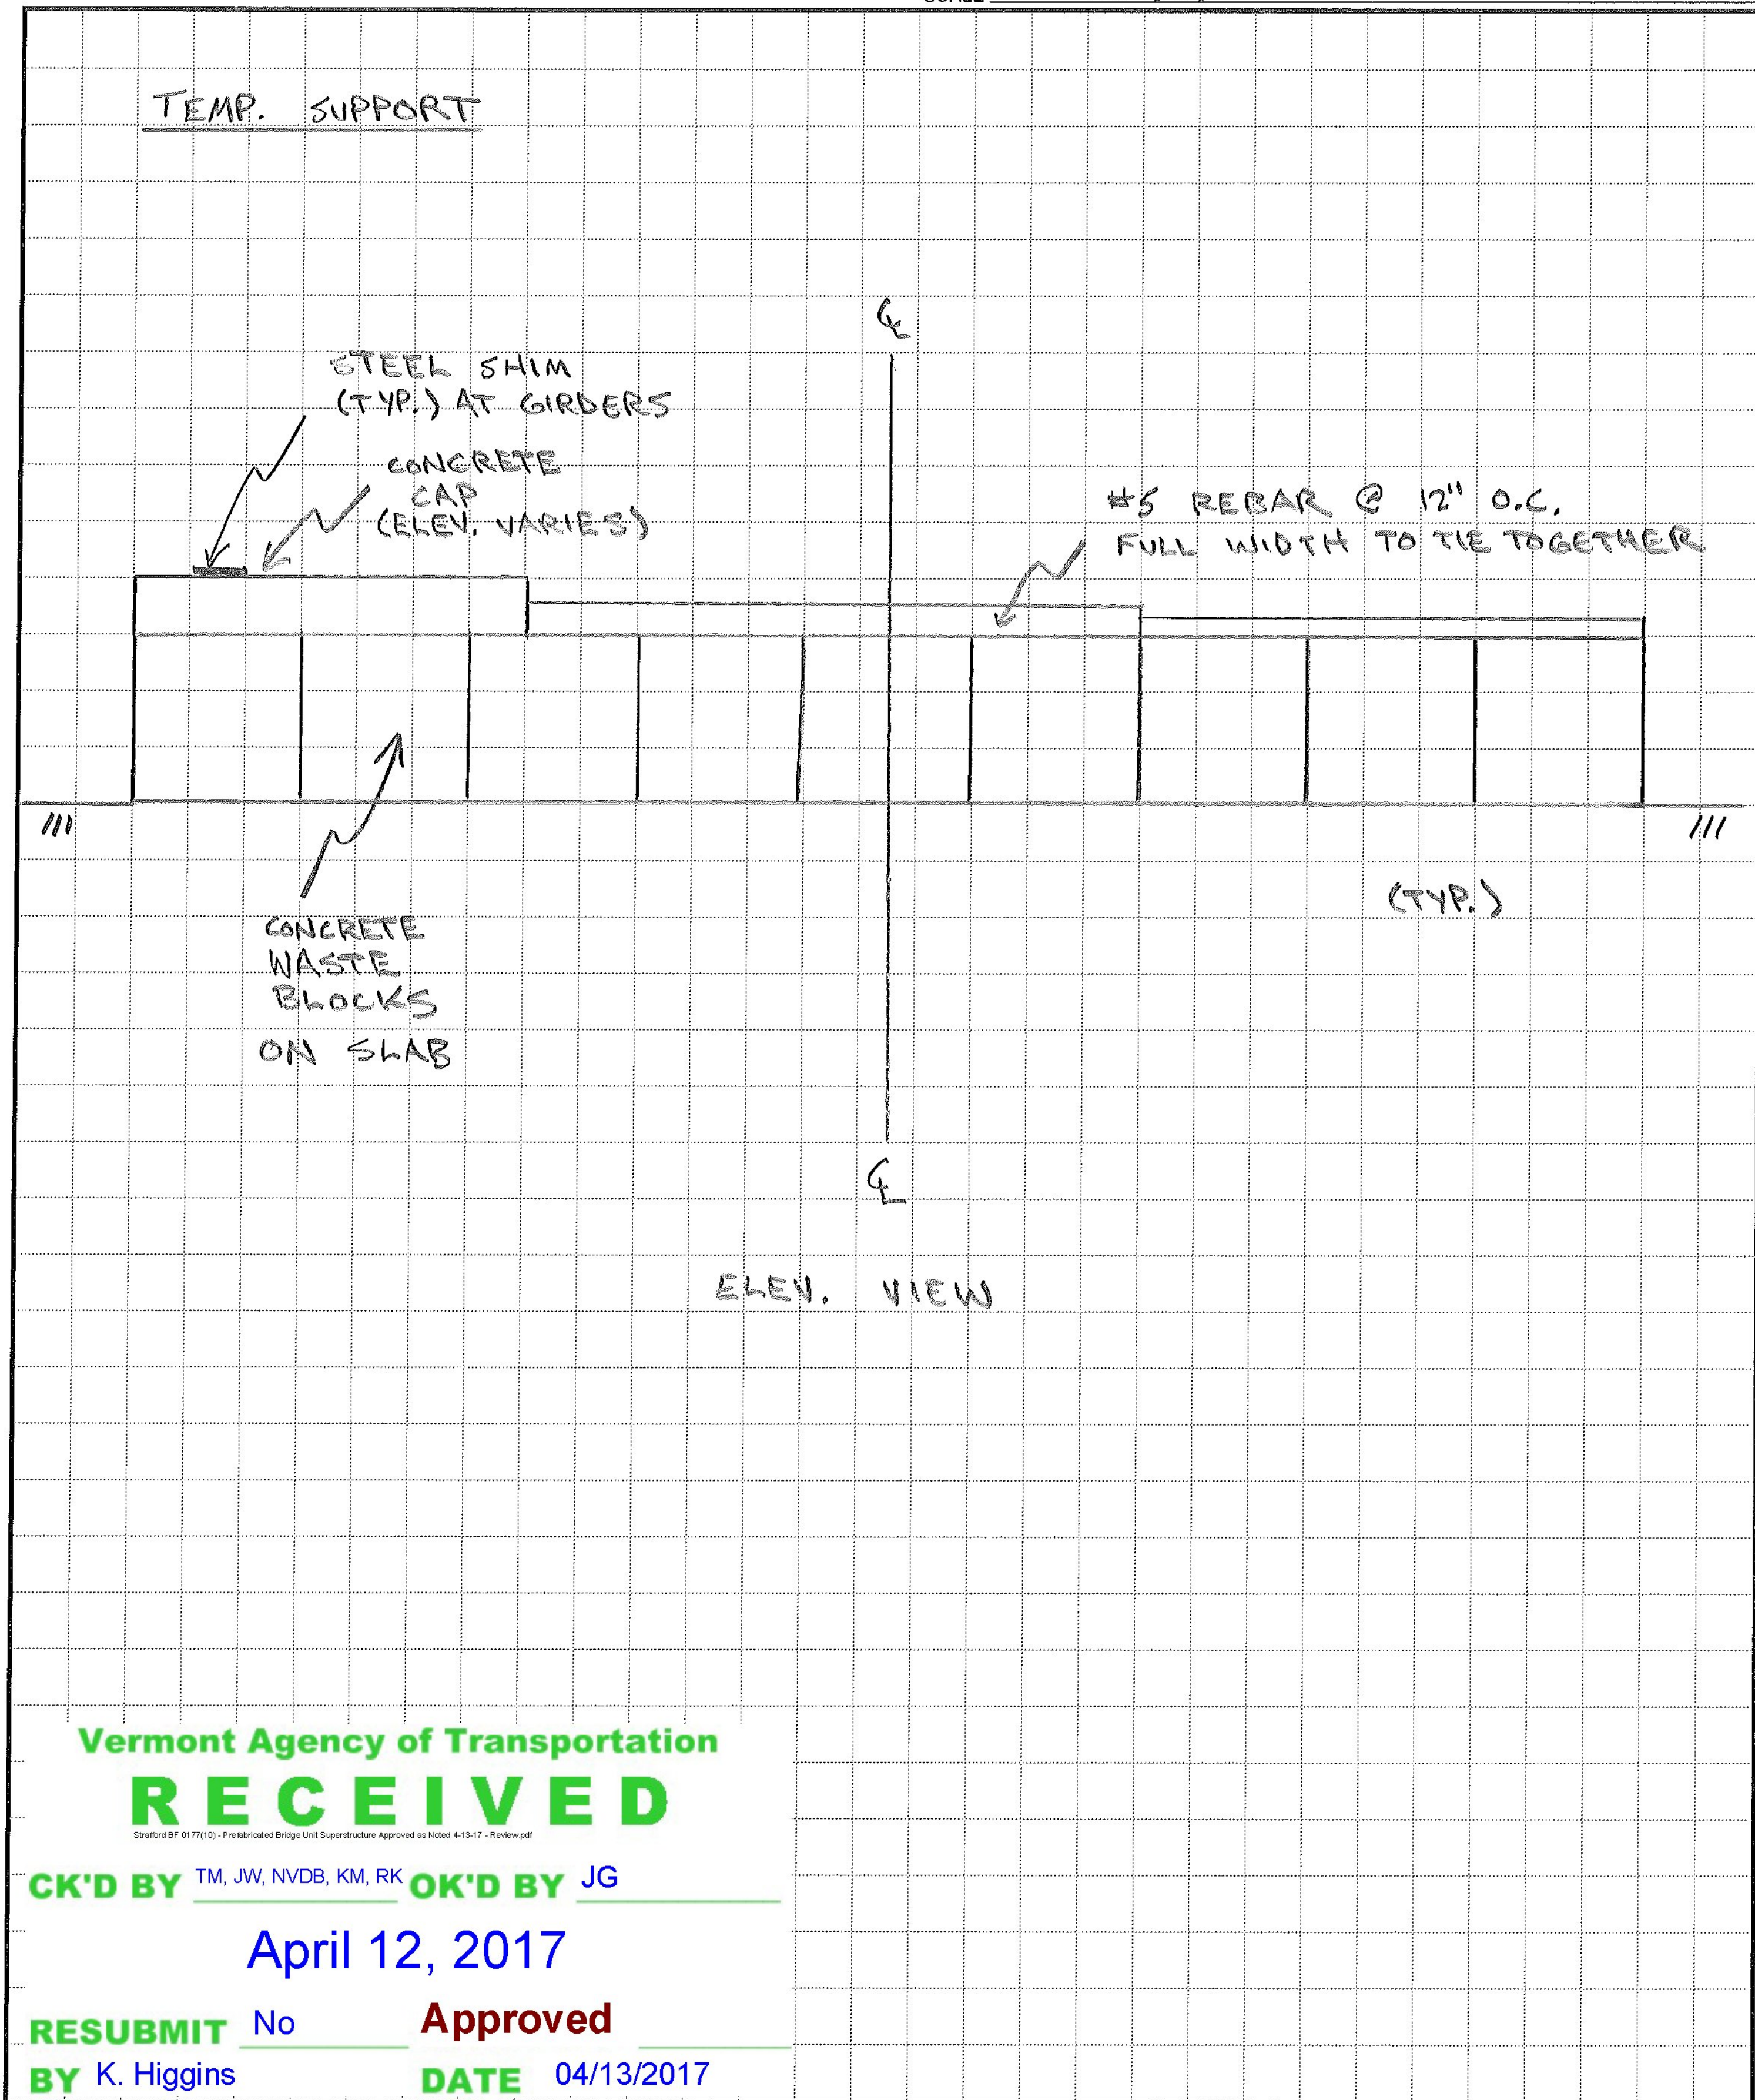

Vermont Agency of Transportation

RECEIVED

CK'D BY TM, JW, NVDB, KM, RK OK'D BY JG

April 12, 2017

RESUBMIT No **Approved**

BY K. Higgins DATE 04/13/2017