




STATE OF VERMONT AGENCY OF TRANSPORTATION

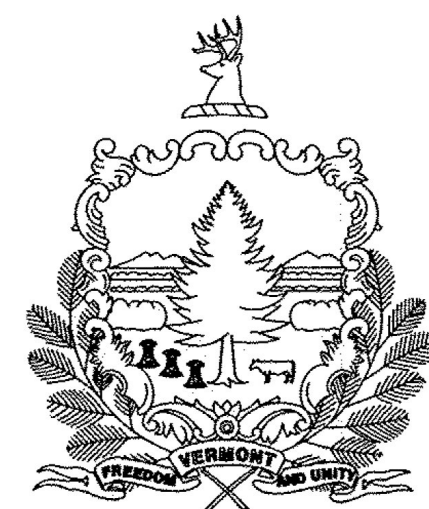

PROPOSED IMPROVEMENT BRIDGE PROJECT

WOODSTOCK VILLAGE
COUNTY OF WINDSOR

ROUTE NO: TH 1/US 4 (CLASS 1), VILLAGE PRINCIPAL ARTERIAL, BRIDGE NO: BR 51
 PROJECT LOCATION: ON US 4 APPROXIMATELY 0.2 MILES EAST OF THE JUNCTION
 WITH VT ROUTE 106 (OVER KEDRON BROOK)
 PROJECT DESCRIPTION: REPLACEMENT OF EXISTING SUPERSTRUCTURE
 LENGTH OF STRUCTURE: 36.94 FEET
 LENGTH OF ROAD: 0.00 FEET
 LENGTH OF PROJECT: 36.94 FEET

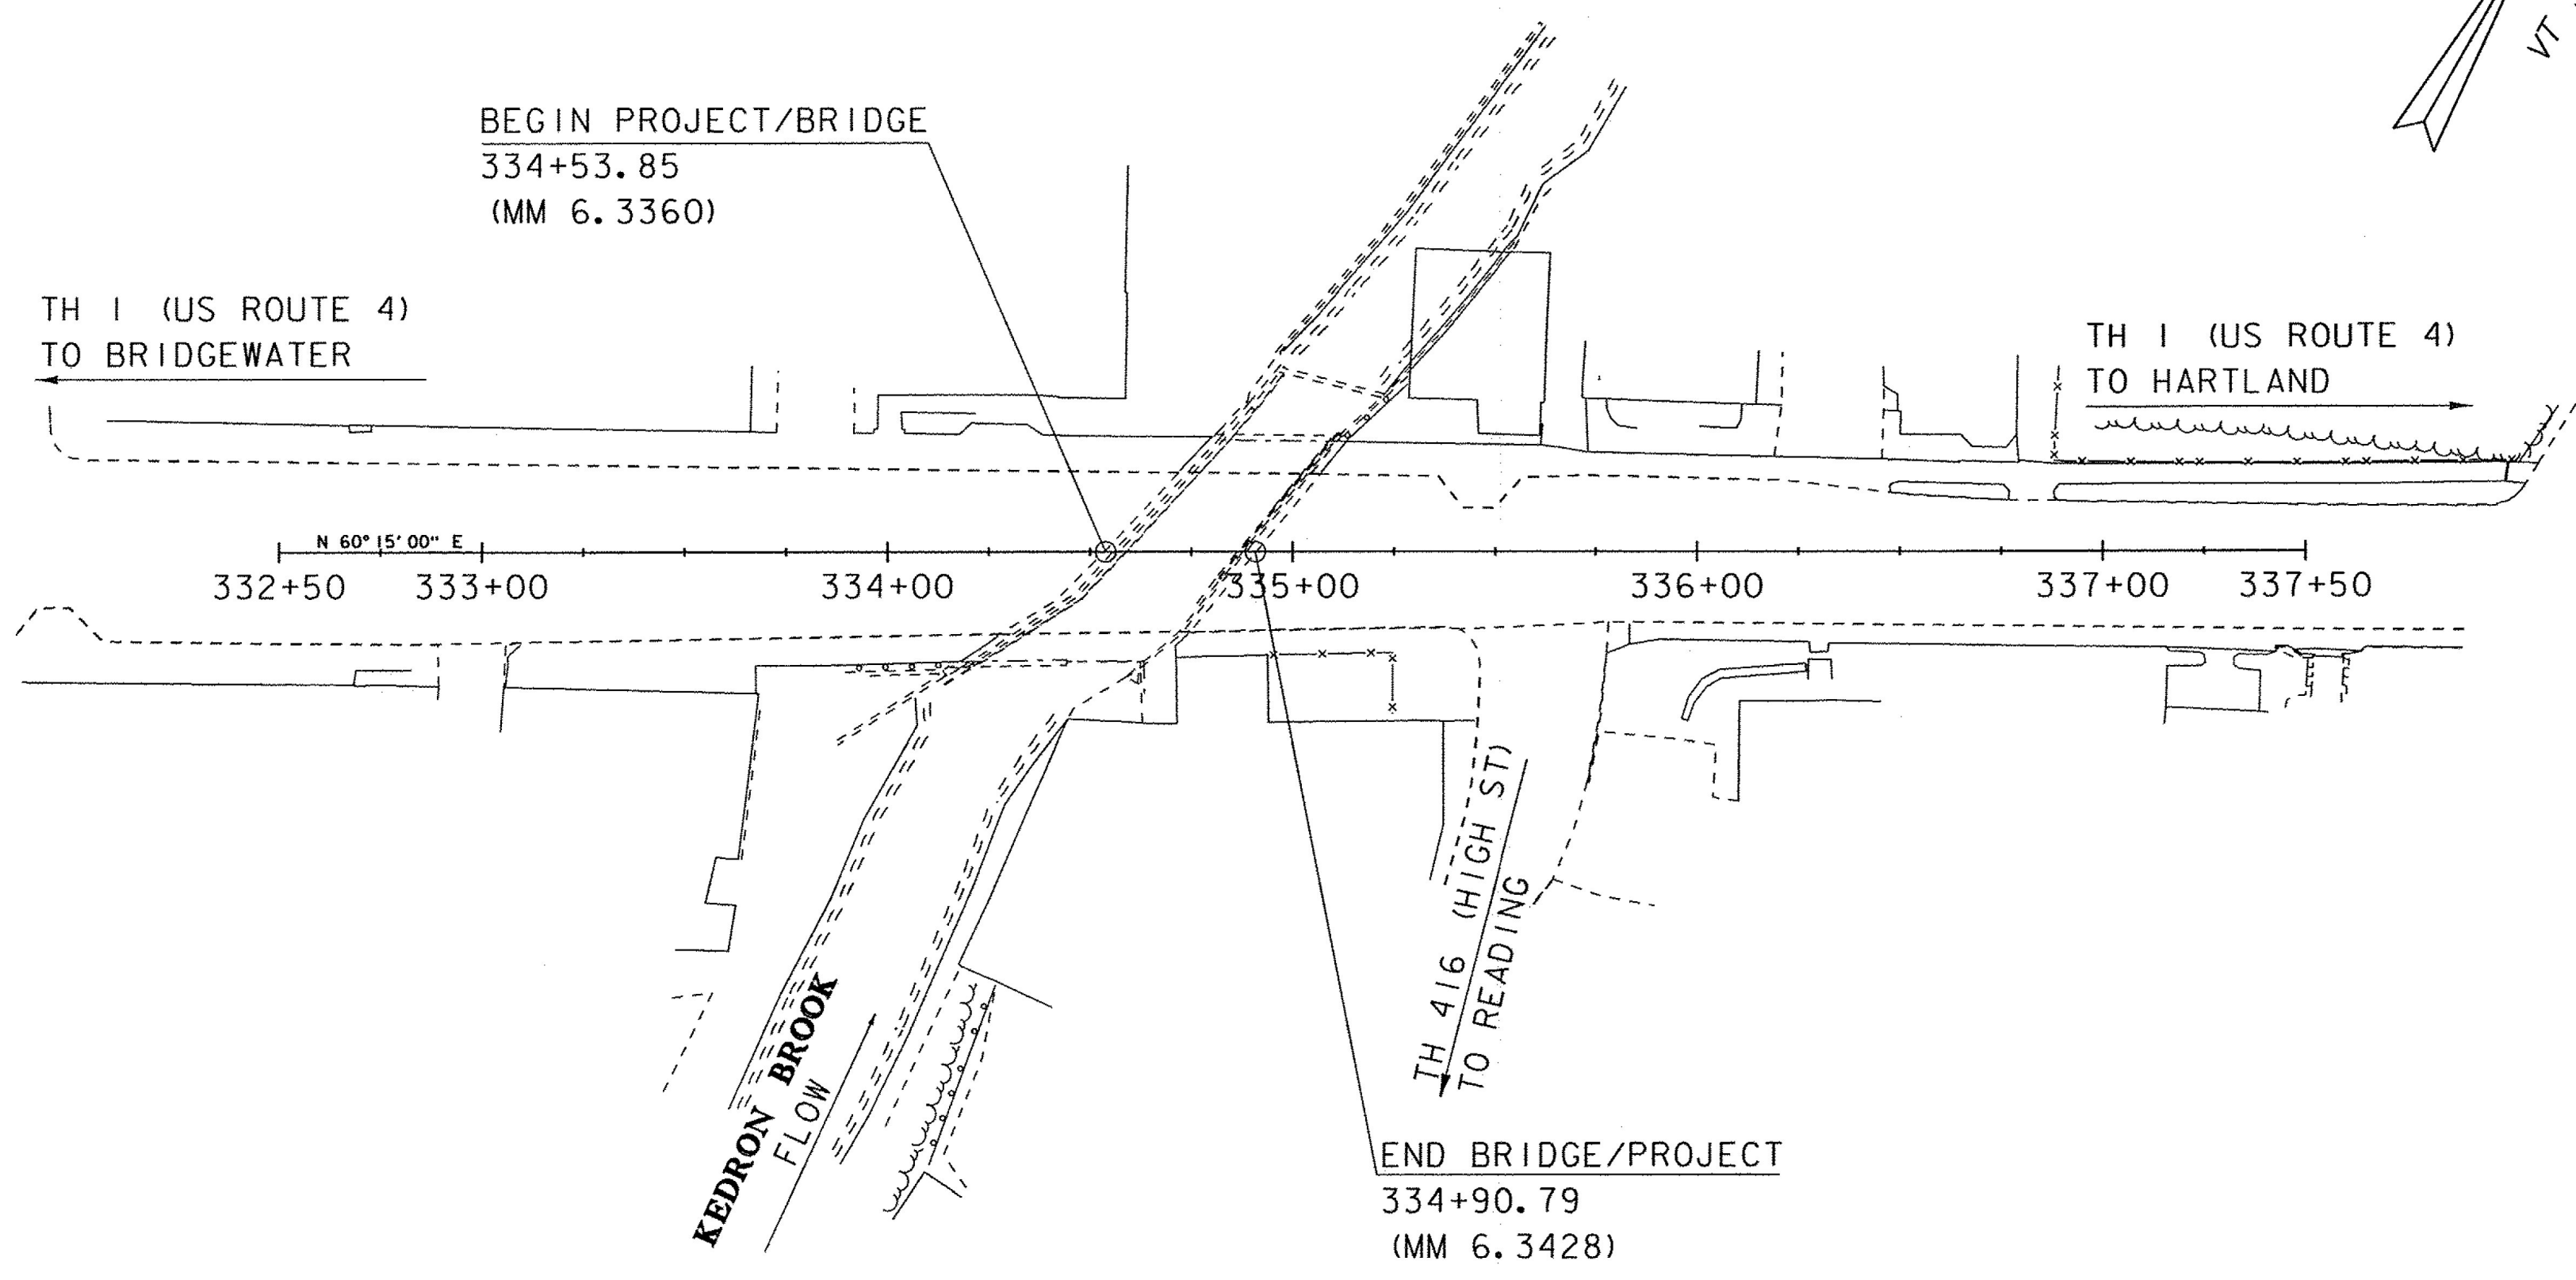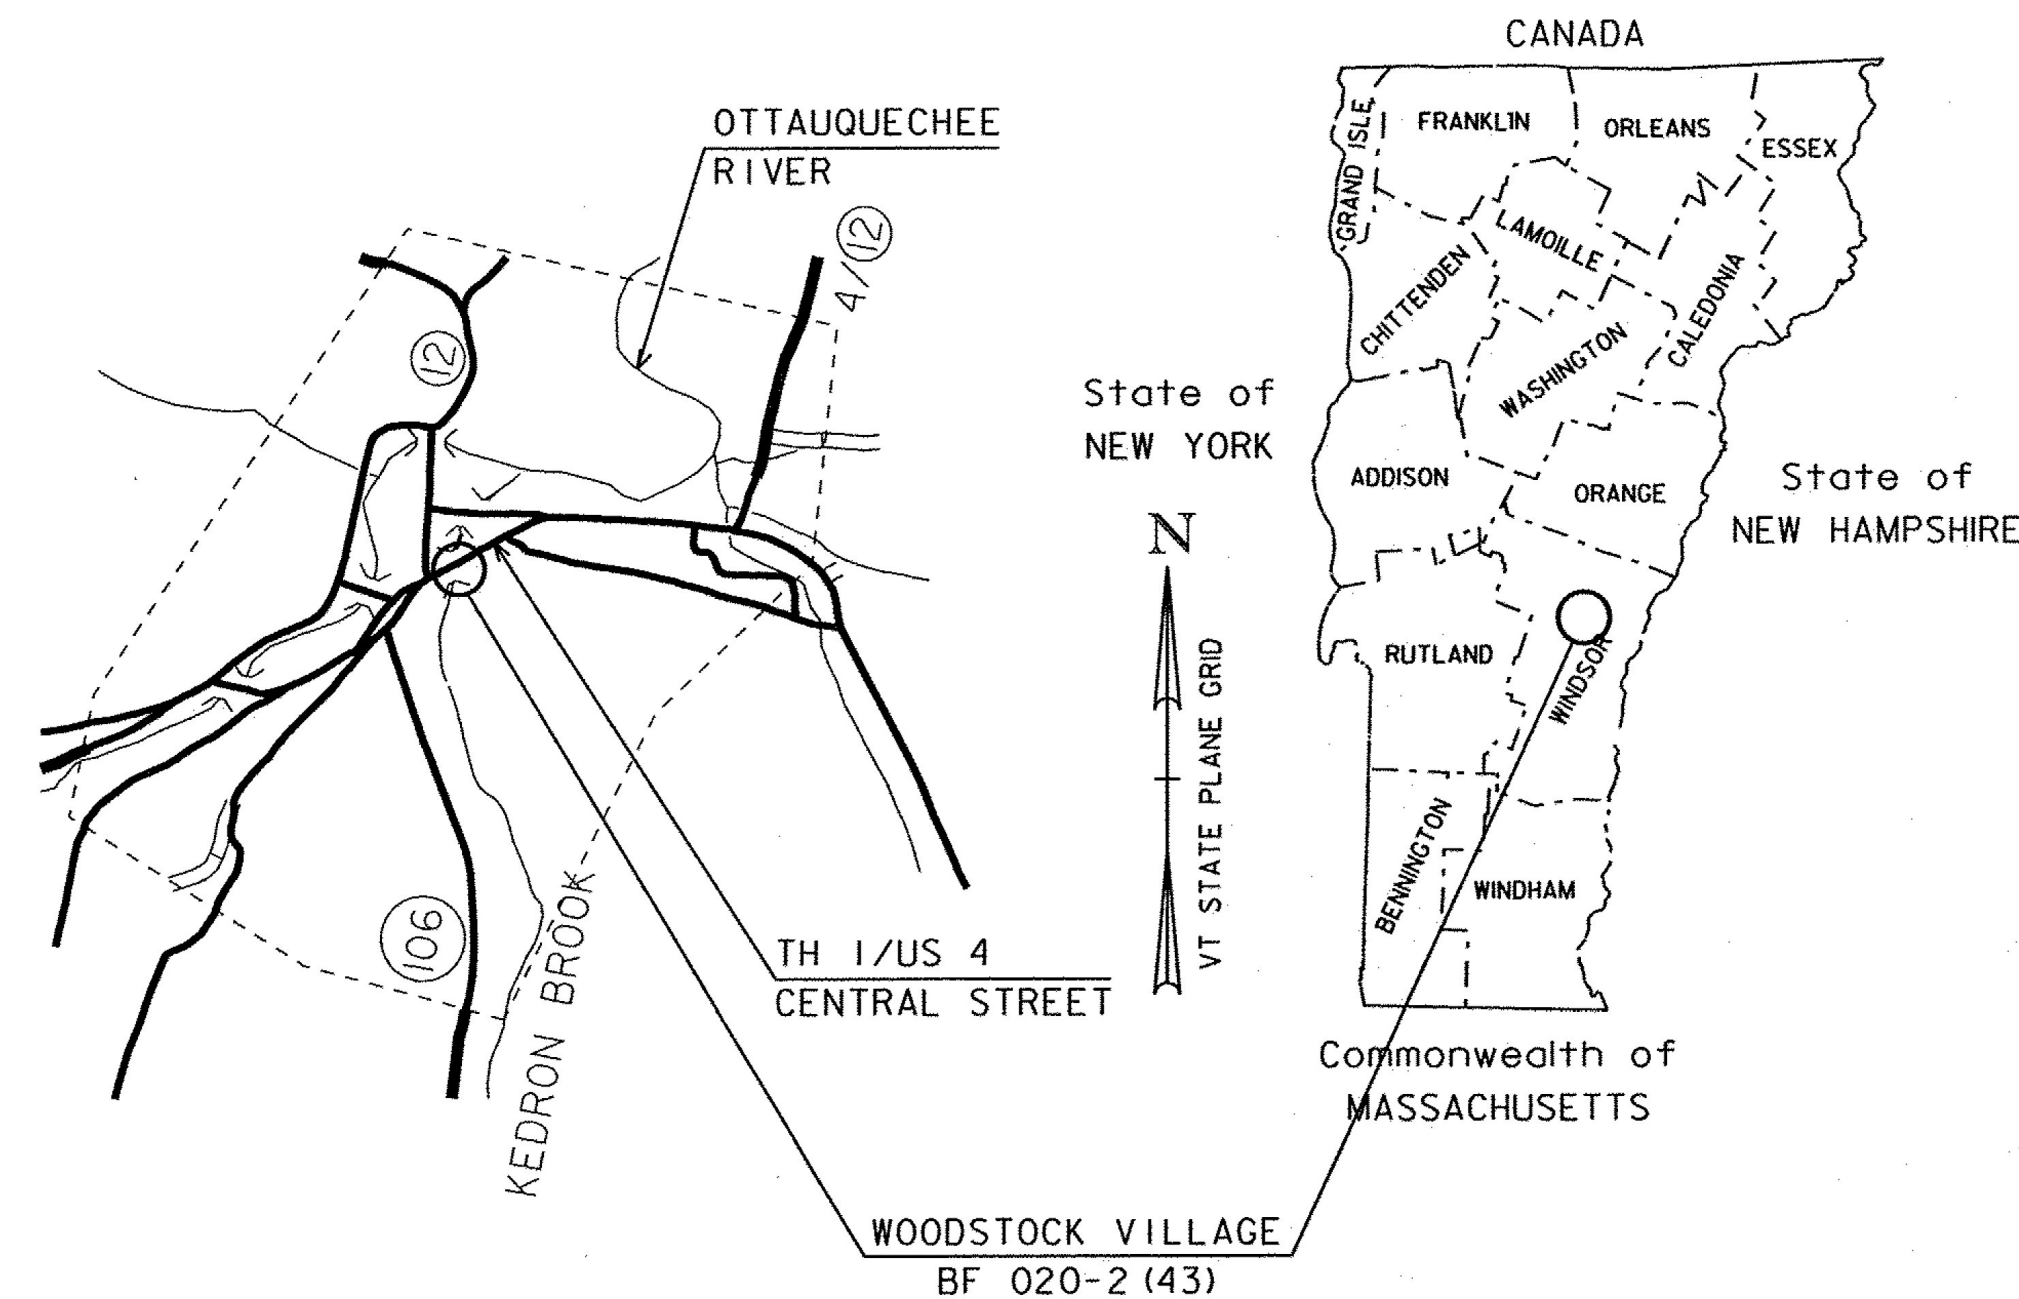

CONSTRUCTION IS TO BE CARRIED ON IN ACCORDANCE WITH THESE PLANS AND THE STANDARD SPECIFICATIONS FOR CONSTRUCTION DATED 2011, AS APPROVED BY THE FEDERAL HIGHWAY ADMINISTRATION ON JULY 20, 2011 FOR USE ON THIS PROJECT, INCLUDING ALL SUBSEQUENT REVISIONS AND SUCH REVISED SPECIFICATIONS AND SPECIAL PROVISIONS AS ARE INCORPORATED IN THESE PLANS.

QUALITY ASSURANCE PROGRAM : LEVEL 2	
SURVEYED BY :	RG
SURVEYED DATE :	5-23-2014
DATUM	
VERTICAL	NAVD 88
HORIZONTAL	NAD 83 (2011)

SCALE 1" = 40'-0"

DIRECTOR OF PROJECT DELIVERY	
APPROVED	DATE 7/20/2019
PROJECT MANAGER : ROB YOUNG, P.E.	
PROJECT NAME :	WOODSTOCK VILLAGE
PROJECT NUMBER :	BF 020-2 (43)
SHEET 1	OF 53 SHEETS

Record Plans
 Contractor: COLD RIVER BRIDGES, LLC
 Resident Engineer: TOM CHASE
 Construction Began: MARCH 21, 2018
 Construction Complete: JUNE 7, 2018
 Record Plans By: TOM CHASE & ELIZABETH CRAFFEY

I hereby certify that all construction required by this set of drawings has been accomplished as indicated herein.

BY: E-SIGNED by Thomas Chase on 2019-01-22 18:40:44 UTC Resident Engineer

Date: January 22, 2019

NOTE: Any further information concerning final quantities, amounts or other details relative to this project may be found at Central Files in the electronic archives.