

DURABLE 4 INCH YELLOW LINE (DOUBLE)
STA 333+90 - 335+40 CL

DURABLE 4 INCH WHITE PAVEMENT
MARKINGS, PARKING STALLS
STA 334+11.86 - 334+99.86 LT
STA 333+90.00 - 335+20.00 RT

DURABLE LETTER OR SYMBOL
(HANDICAP PAVEMENT MARKING)
STA 335+07 RT



DURABLE 8 INCH WHITE PAVEMENT
MARKINGS, PAINTED ISLANDS
STA 333+91.63 - 334+11.86 LT
STA 334+99.86 - 335+41.72 LT
STA 335+20.00 - 335+40.00 RT

SPECIAL PROVISION
(REMOVE PARKING METER POST)
334+54.47 LT
333+91.71 RT
334+78.96 ~~LT RT~~

SPECIAL PROVISION
(PARKING METER POST/ METER)
333+90 RT (DOUBLE METER)
334+32 RT (DOUBLE METER)
334+56 LT (DOUBLE METER)
334+76 LT (SINGLE METER)
334+78 RT (DOUBLE METER)

REMOVING SIGNS
STA 334+53.66 LT
STA 334+60.10 RT
STA 334+99.09 LT
STA 335+02.50 LT
STA 335+05.09 RT
~~STA 335+29.34 LT~~

ERECTING SALVAGED SIGNS
~~STA 335+29.34 LT~~
TRAFFIC SIGN, TYPE A
STA 334+53.66 LT
STA 334+99.09 LT
STA 335+02.50 LT
STA 335+05.09 RT

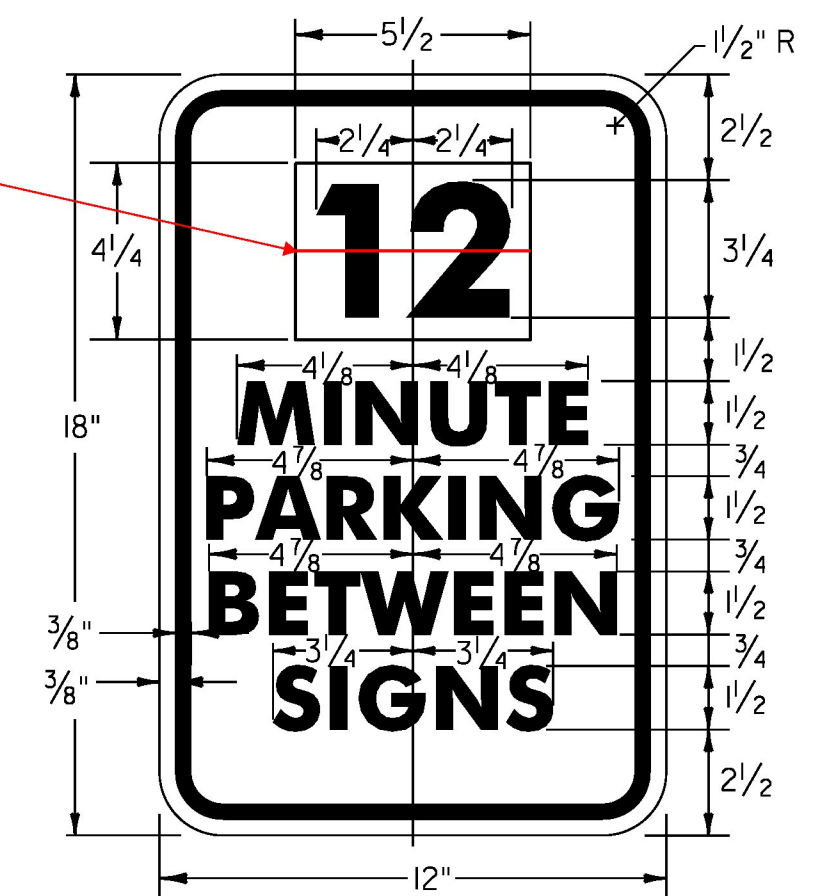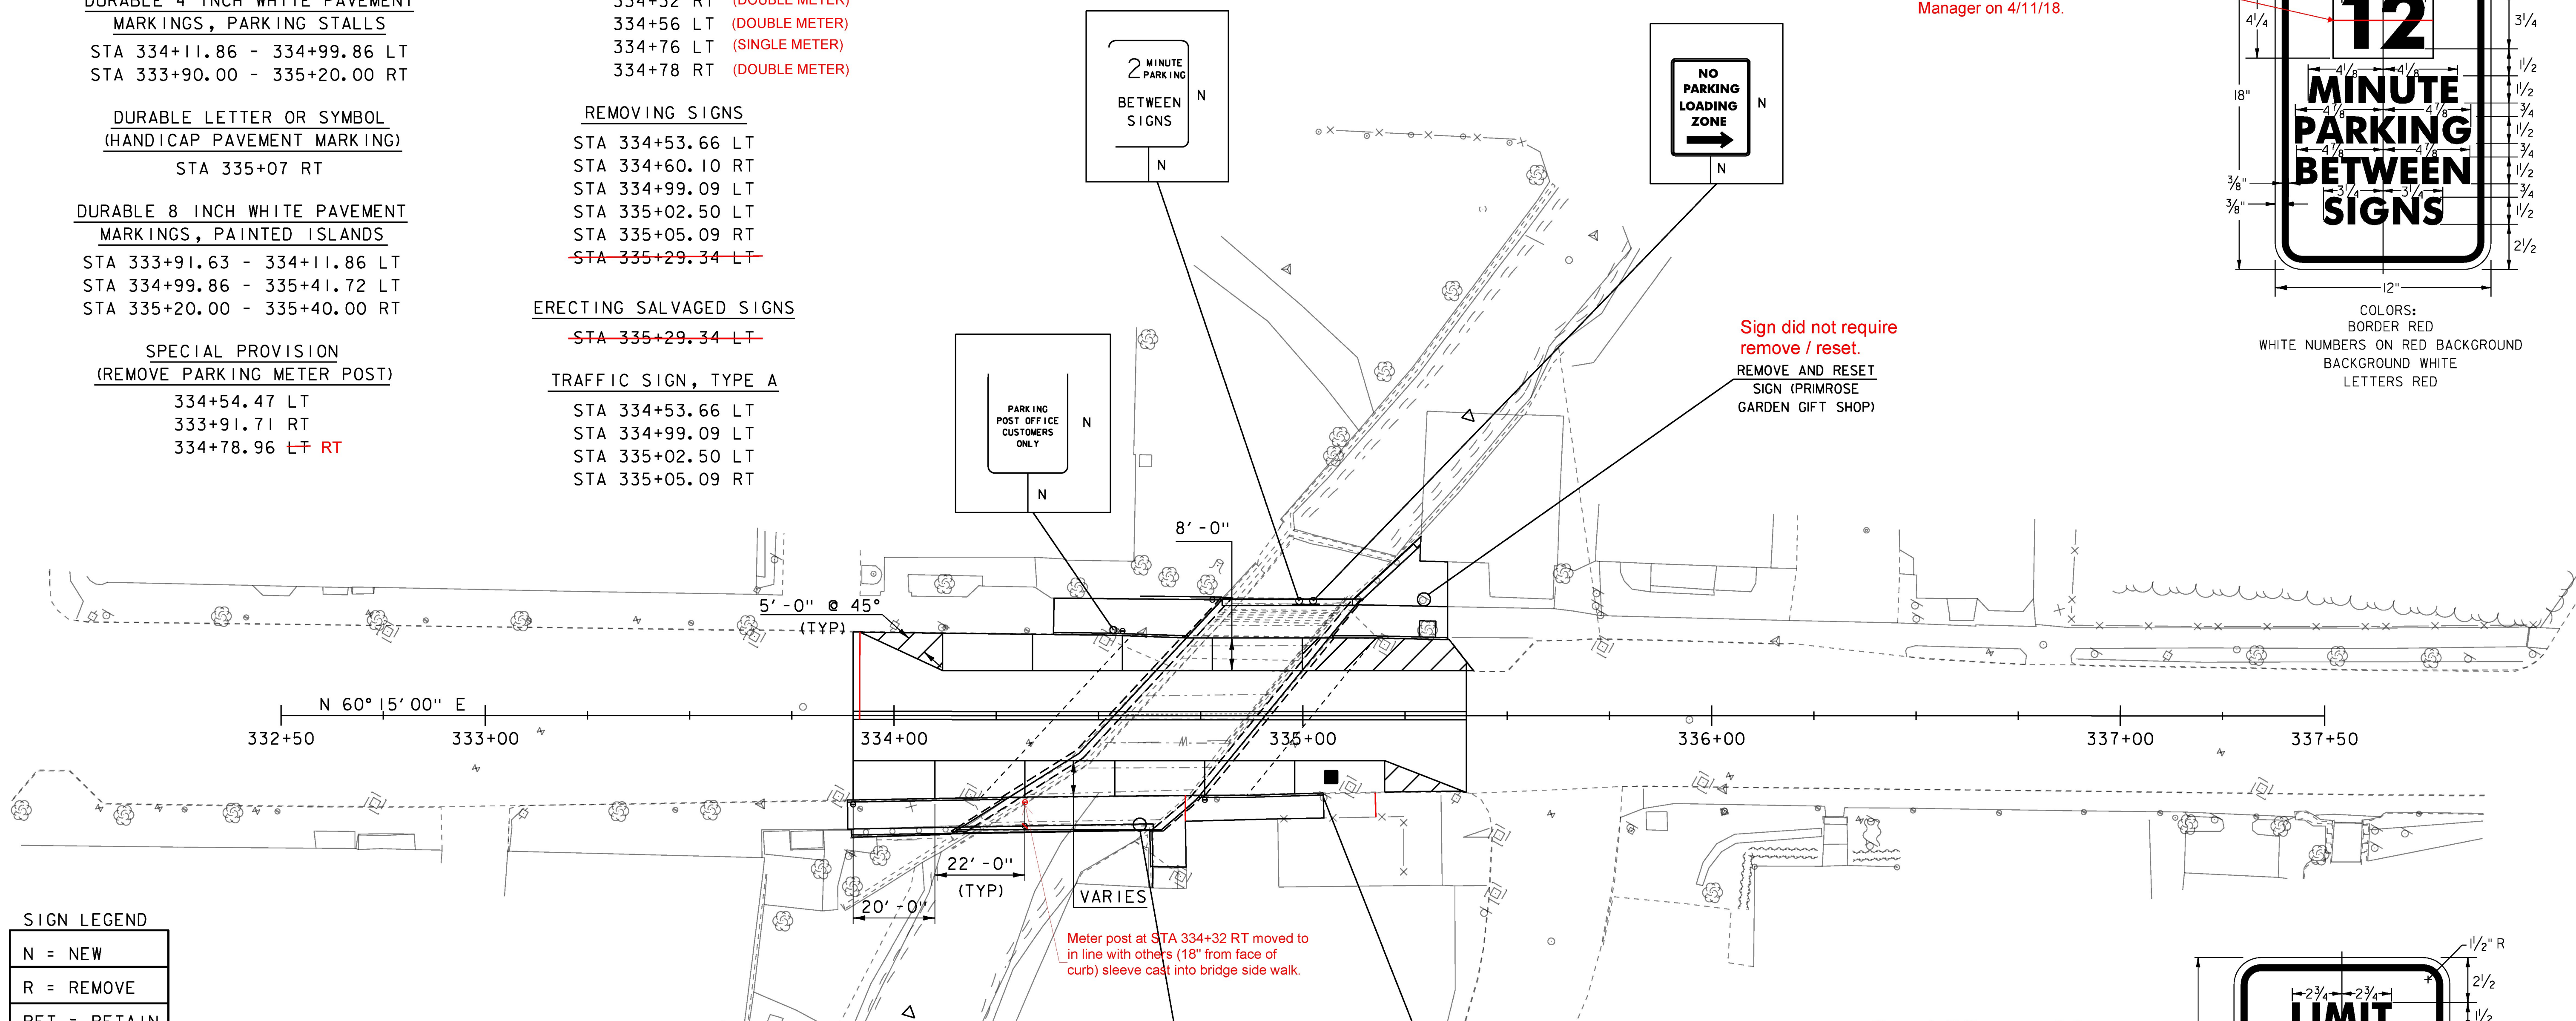

COLORS:
BORDER RED
WHITE NUMBERS ON RED BACKGROUND
BACKGROUND WHITE
LETTERS RED

Change to "15" per request of
Phil Swanson Woodstock Town
Manager on 4/11/18.

Sign did not require
remove / reset.
REMOVE AND RESET
SIGN (PRIMROSE
GARDEN GIFT SHOP)

SIGN LEGEND

N = NEW
R = REMOVE
RET = RETAIN


MILEMARKER, STATION, OR SIGN NUMBER	SIGN LEGEND	SIGN DIMENSIONS		NEW SIGN "A"	EXIST POST SALVAGE RETAIN	NO. OF POSTS	NEW SIGN POSTS SQUARE STEEL (in)			REMARKS	SIGN DETAIL	
		WIDTH (in)	HEIGHT (in)				1.75	2.0	2.5		DETAIL ON SHEET NUMBER	STD. SHEET NUMBER
334+53.66 LT		12	18	1.50		1	1.88	2.42	3.35	BLACK ON WHITE	15	----
334+99.09 LT 334+93 LT		12	18	1.50		1	1.88	2.42	3.35	RED ON WHITE	15	----
335+02.50 LT		12	18	1.50		1	1.88	2.42	3.35	R7-6R DETAIL IN SHSM	----	----
335+05.09 RT		12	18	1.50		1	1.88	2.42	3.35	R7-8 DETAIL IN SHSM	----	----
							FT	FT	EA			
							30	33.2				
TOTALS				SF			FT			SHSM = STANDARD HIGHWAY SIGNS AND MARKINGS		
				6.00			30					

FINAL POST LENGTHS ARE TO BE DETERMINED
IN THE FIELD. POST SIZES ARE COMPUTED
BASED ON INFORMATION FURNISHED ON THE
STANDARD SHEETS AND THE VTRANS
"SIGN POST DESIGN GUIDELINE."

Meter post at STA 334+32 RT moved to
in line with others (18" from face of
curb) sleeve cast into bridge side walk.

REMOVE AND SALVAGE
SIGN (COLLECTIVE,
THE ART OF CRAFT)

Change to "15" per request of
Phil Swanson Woodstock Town
Manager on 4/11/18.

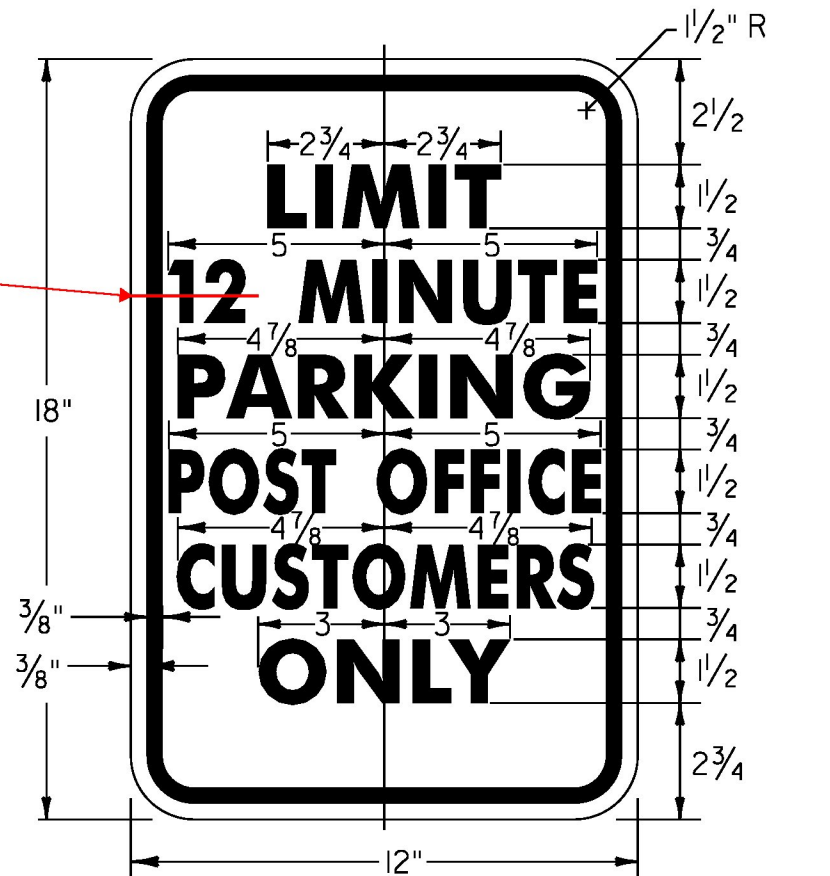

COLORS:
BACKGROUND WHITE
BLACK LETTERS

SIGN AND PAVEMENT MARKINGS SHEET

SCALE 1" = 20' - 0"
20 0 20

PROJECT NAME: WOODSTOCK VILLAGE	PLOT DATE: 18-JUL-2017
PROJECT NUMBER: BF 020-2(43)	DRAWN BY: S. COLEY
FILE NAME: s13j280sgn.dgn	CHECKED BY: W. LAMMER
PROJECT LEADER: R. YOUNG	SHEET 15 OF 53
DESIGNED BY: S. COLEY	
SIGN AND PAVEMENT MARKINGS SHEET	