


SHEET REVISED 1/11/18.  
SEE NEW SHEET # 23.

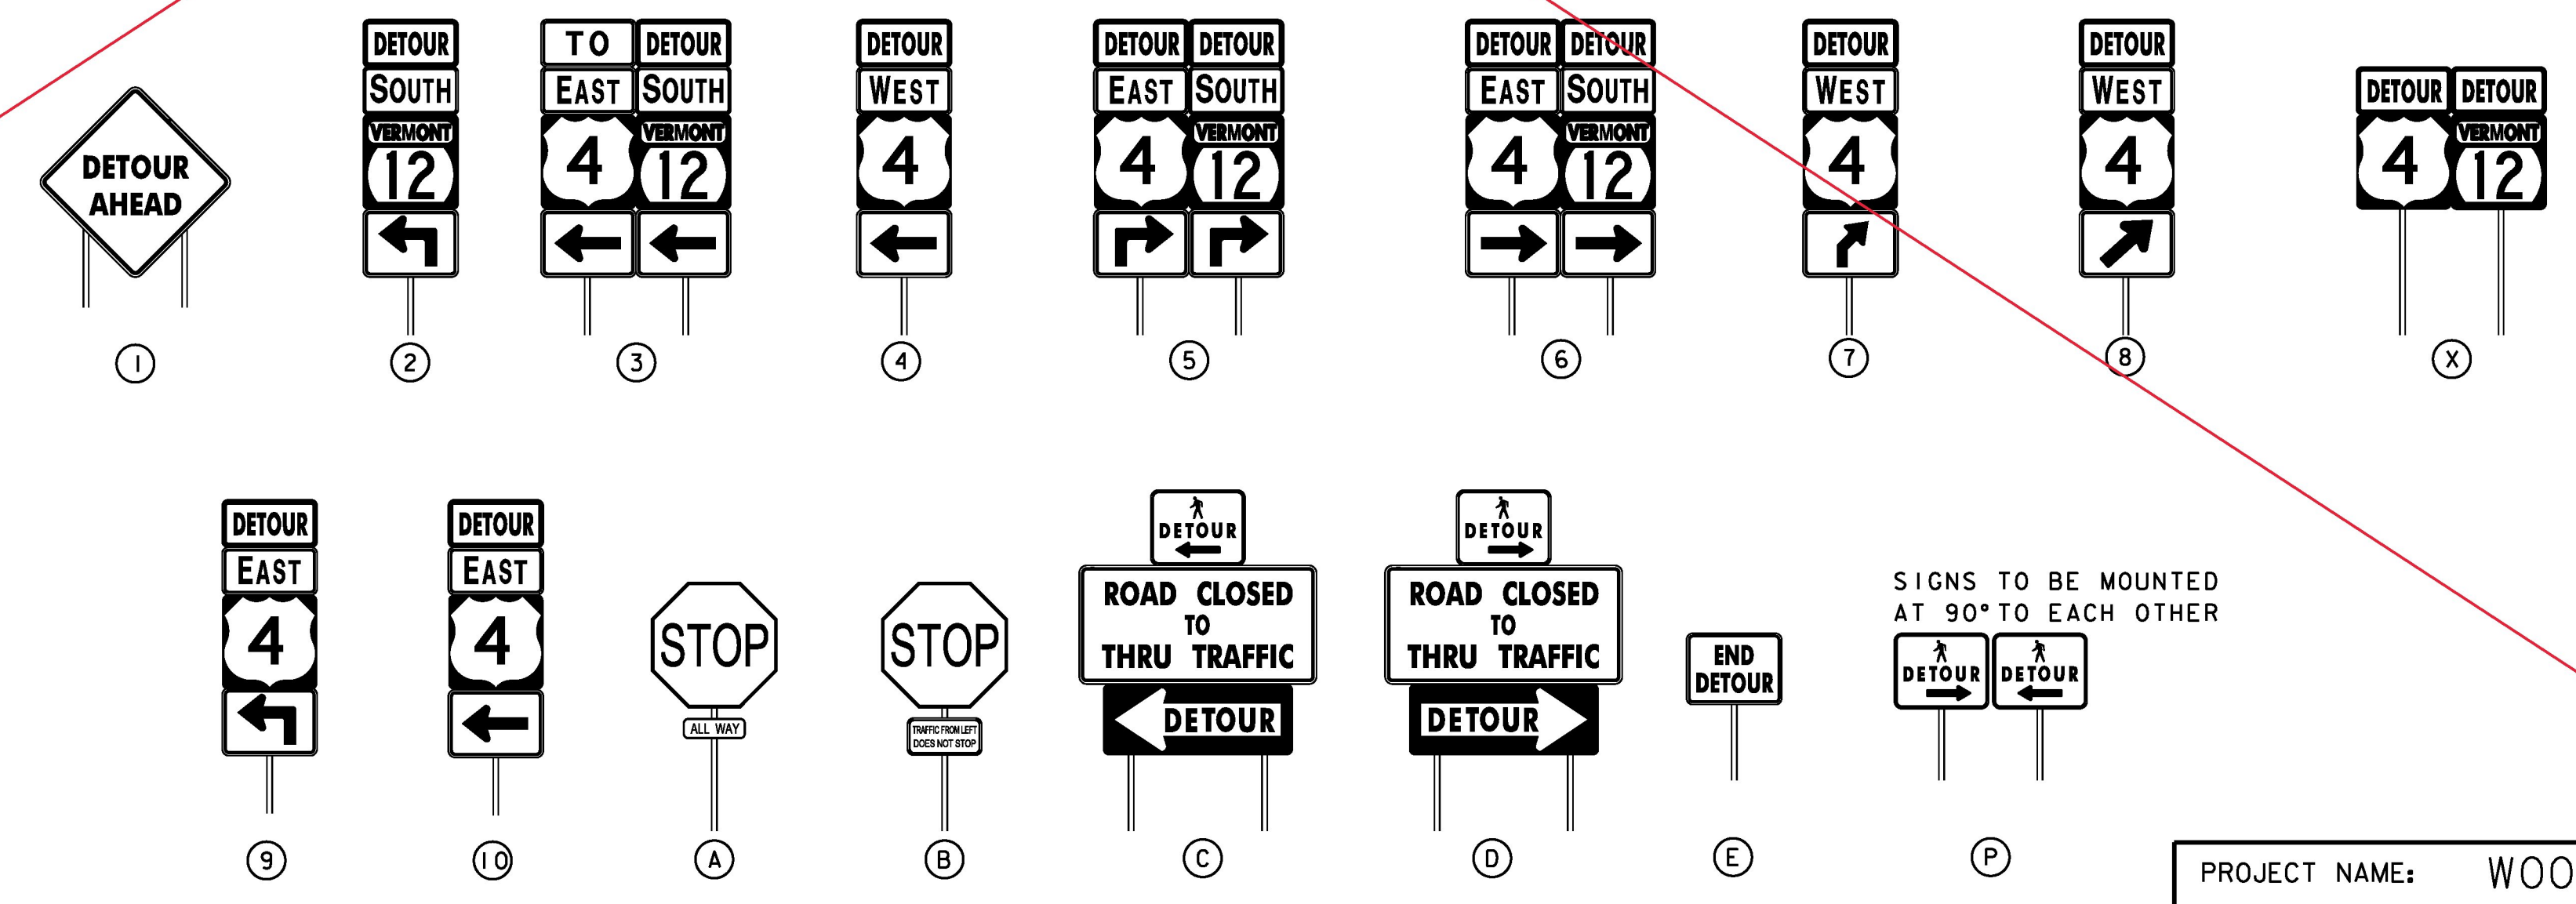

SIGNS TO BE MOUNTED AT 90° TO EACH OTHER

PROJECT NAME:	WOODSTOCK VILLAGE
PROJECT NUMBER:	BF 020-2(43)
FILE NAME:	13J280/si3J280detour.dgn
PROJECT LEADER:	R.YOUNG
DESIGNED BY:	W.LAMMER
LOCAL DETOUR	
PLOT DATE:	18-JUL-2017
DRAWN BY:	D.D.BEARD
CHECKED BY:	W.LAMMER
SHEET	23 OF 53