


** US 4: EAST / WEST
 ○ ○ CONFIRMATION ROUTE MARKER

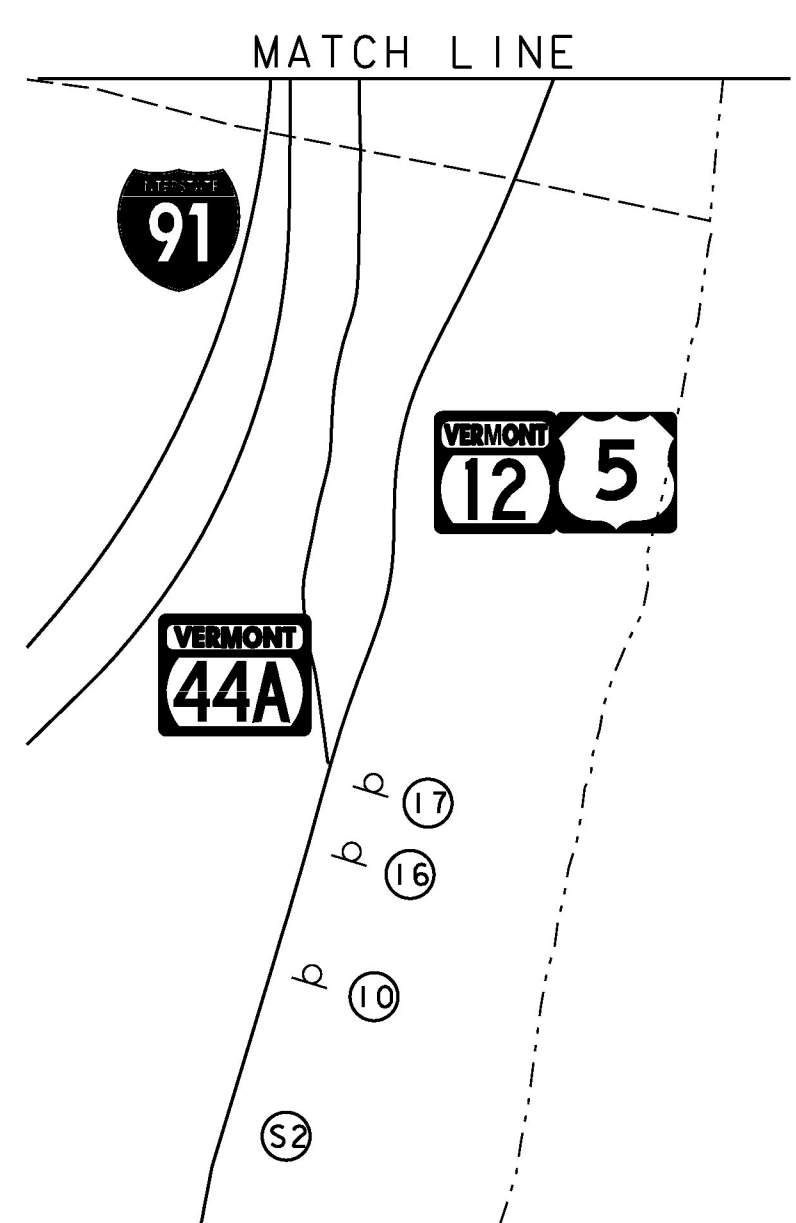

CONFIRMATION ROUTE MARKER ASSEMBLY SHALL BE COMPRISED OF THE TWO SIGN ASSEMBLIES AS MARKED ADJACENT TO CONFIRMATION ROUTE MARKER SYMBOL.

- CONFIRMATION ROUTE MARKER LOCATIONS:
- VT 106 - 300 FT NORTH OF KENDALL ROAD.
 - VT 106 - 700 FT NORTH OF BAILEYS MILLS ROAD.
 - VT 44 - 200 FT EAST OF WILLOW BROOK ROAD.
 - VT 44 - 300 FT EAST OF BROOK ROAD.
 - VT 44 - 100 FT WEST OF VT44A.
 - US 5/VT 12 - 600 FT NORTH OF JUNIPER HILL ROAD.
 - VT 12 - 300 FT NORTH OF BROWNSVILLE ROAD.
 - VT 12 - AT INTERSECTION OF DAMON ROAD.

REV	DATE	DESCRIPTION
1	1/11/18	REVISED DETOUR SIGNAGE.

PROJECT NAME:	WOODSTOCK VILLAGE
PROJECT NUMBER:	BF 020-2(43)
FILE NAME:	s13j280detour.Revi.dgn
PROJECT LEADER:	R. YOUNG
DESIGNED BY:	W.LAMMER
REGIONAL TRUCK DETOUR	
PLOT DATE:	16-JAN-2018
DRAWN BY:	E.A.CRAFFEY
CHECKED BY:	S.COLEY
SHEET	24A OF 53