


BRIDGE SEAT 2 PLAN  
SCALE 1/4" = 1'-0"

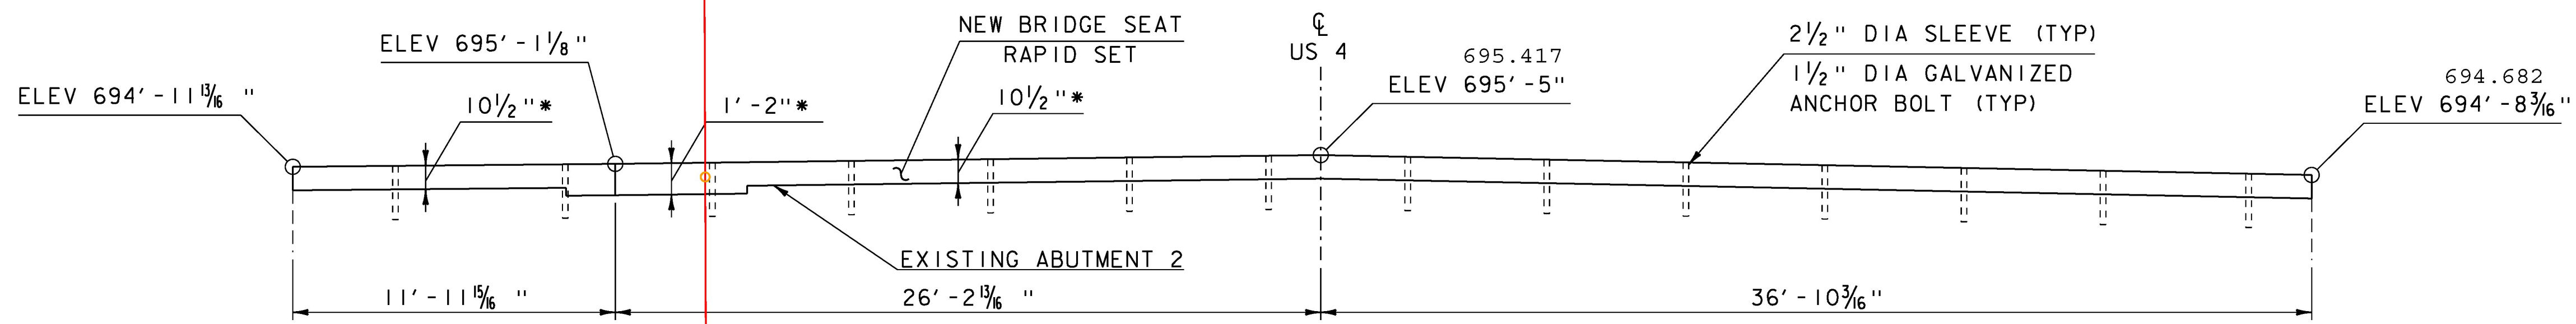

BRIDGE SEAT 2 ELEVATION ALONG CL BEARING  
SCALE 1/4" = 1'-0"

NOTES:  
\* CUT EXISTING ABUTMENT AS REQUIRED TO MEET THE MINIMUM DEPTH REQUIREMENTS OF 0'-10 1/2" FOR THE BRIDGE SEAT. DEPTH OF BRIDGE SEAT VARIES BASED ON EXISTING BRIDGE SEAT ELEVATION.

PROJECT NAME:	WOODSTOCK VILLAGE
PROJECT NUMBER:	BF 020-2(43)
FILE NAME:	sl3j280sub.dgn
PROJECT LEADER:	R. YOUNG
DESIGNED BY:	S. COLEY
BRIDGE SEAT 2	
PLOT DATE:	18-JUL-2017
DRAWN BY:	S. COLEY
CHECKED BY:	W. LAMMER
SHEET	26 OF 53