




BRIDGE SEAT 1 REINFORCEMENT PLAN
SCALE 1/4" = 1'-0"

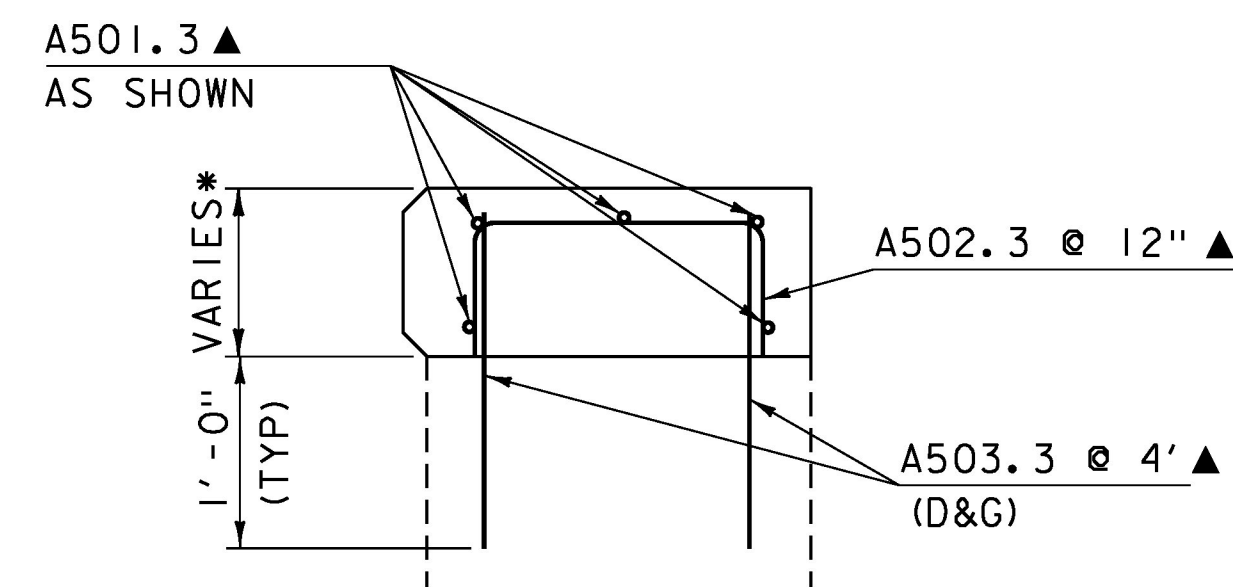

BRIDGE END DETAIL SECTION A-A
NORMAL TO CL BEARING
SCALE 1" = 1'-0"

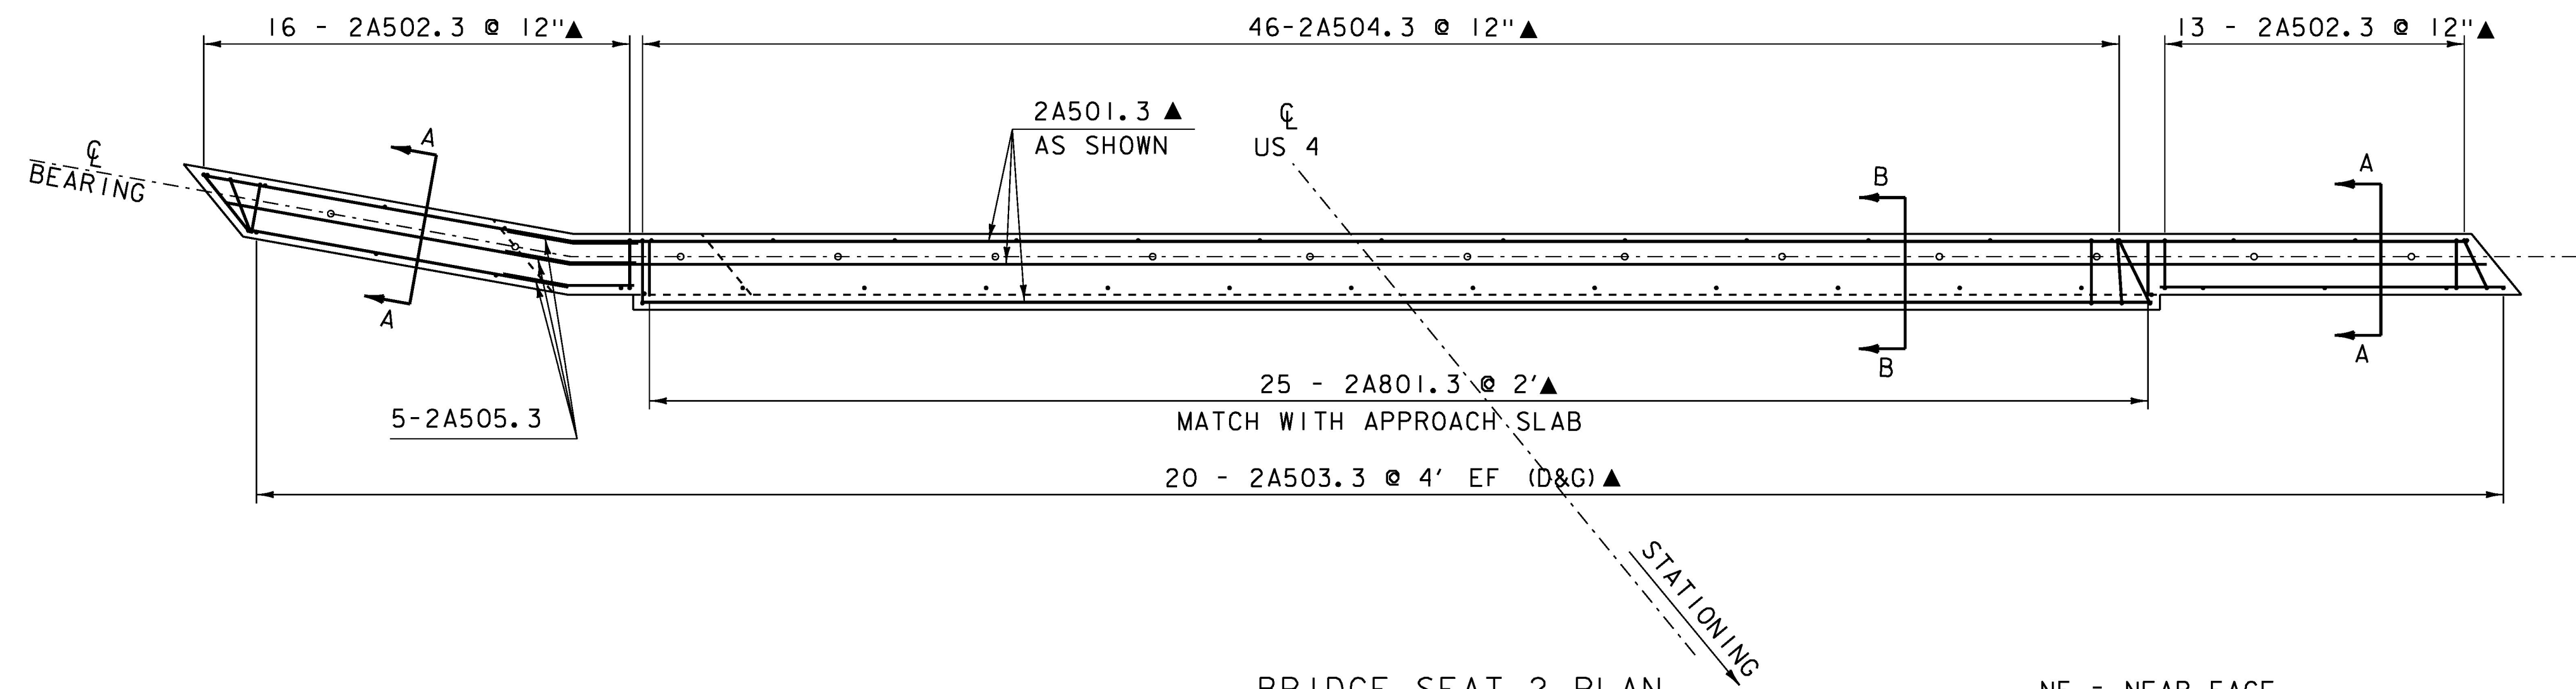

BRIDGE SEAT 2 PLAN
SCALE 1/4" = 1'-0"

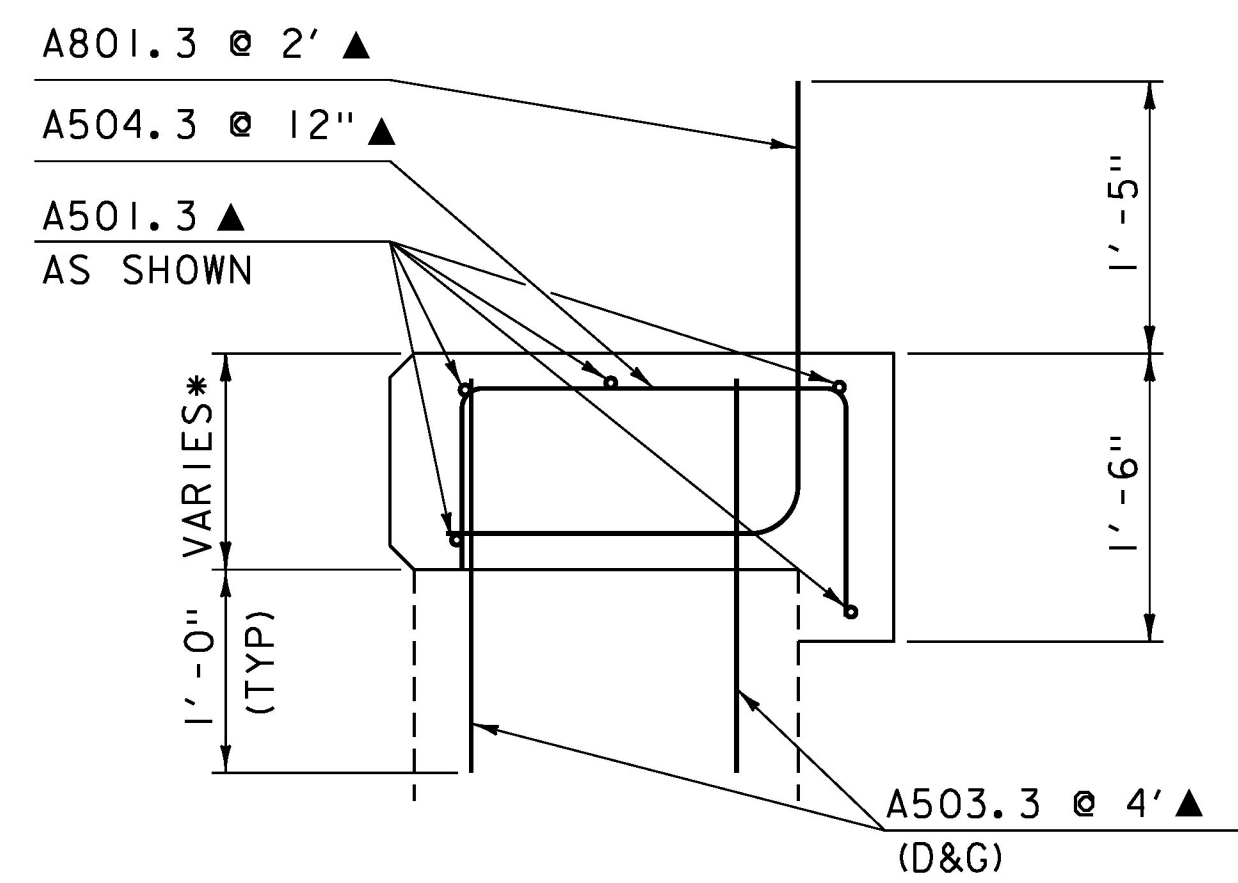

BRIDGE END DETAIL SECTION B-B
NORMAL TO CL BEARING
SCALE 1" = 1'-0"

NF = NEAR FACE
FF = FAR FACE
EF = EACH FACE
(D&G) = DRILL AND GROUT
▲ = CUT FIT IN FIELD
1/2" CLEAR, UNLESS OTHERWISE SPECIFIED ON PLANS.
3" CLEAR ON DRILLED AND GROUTED BARS
2'-2" BAR LAP UNLESS OTHERWISE SPECIFIED ON THE PLANS.

NOTES:

* CUT EXISTING ABUTMENT AS REQUIRED TO MEET THE MINIMUM DEPTH REQUIREMENTS FOR THE BRIDGE SEAT. DEPTH OF NEW BRIDGE SEAT VARIES DEPENDING ON ELEVATION OF EXISTING BRIDGE SEAT.

PROJECT NAME: WOODSTOCK VILLAGE
PROJECT NUMBER: BF 020-2(43)

FILE NAME: s13j280sub.dgn
PROJECT LEADER: R. YOUNG
DESIGNED BY: S. COLEY
BRIDGE SEAT REINFORCEMENT

PLOT DATE: 18-JUL-2017
DRAWN BY: S. COLEY
CHECKED BY: W. LAMMER
SHEET 27 OF 53