
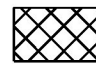



BRIDGE TYPICAL SECTION

SCALE 3/8" = 1'-0"

-  BITUMINOUS CONCRETE PAVEMENT
-  HIGH PERFORMANCE RAPID SET CONCRETE
-  1" OVERPOUR ON SOLID SLABS

PROJECT NAME: WOODSTOCK VILLAGE	
PROJECT NUMBER: BF 020-2(43)	
FILE NAME: sl3j280sup.dgn	PLOT DATE: 18-JUL-2017
PROJECT LEADER: R. YOUNG	DRAWN BY: S. COLEY
DESIGNED BY: S. COLEY	CHECKED BY: W. LAMMER
SOLID SLAB TYPICAL SECTION	SHEET 32 OF 53