




335+00 MATCH INTO EXISTING
SIDEWALK STA 335+05.0 RT

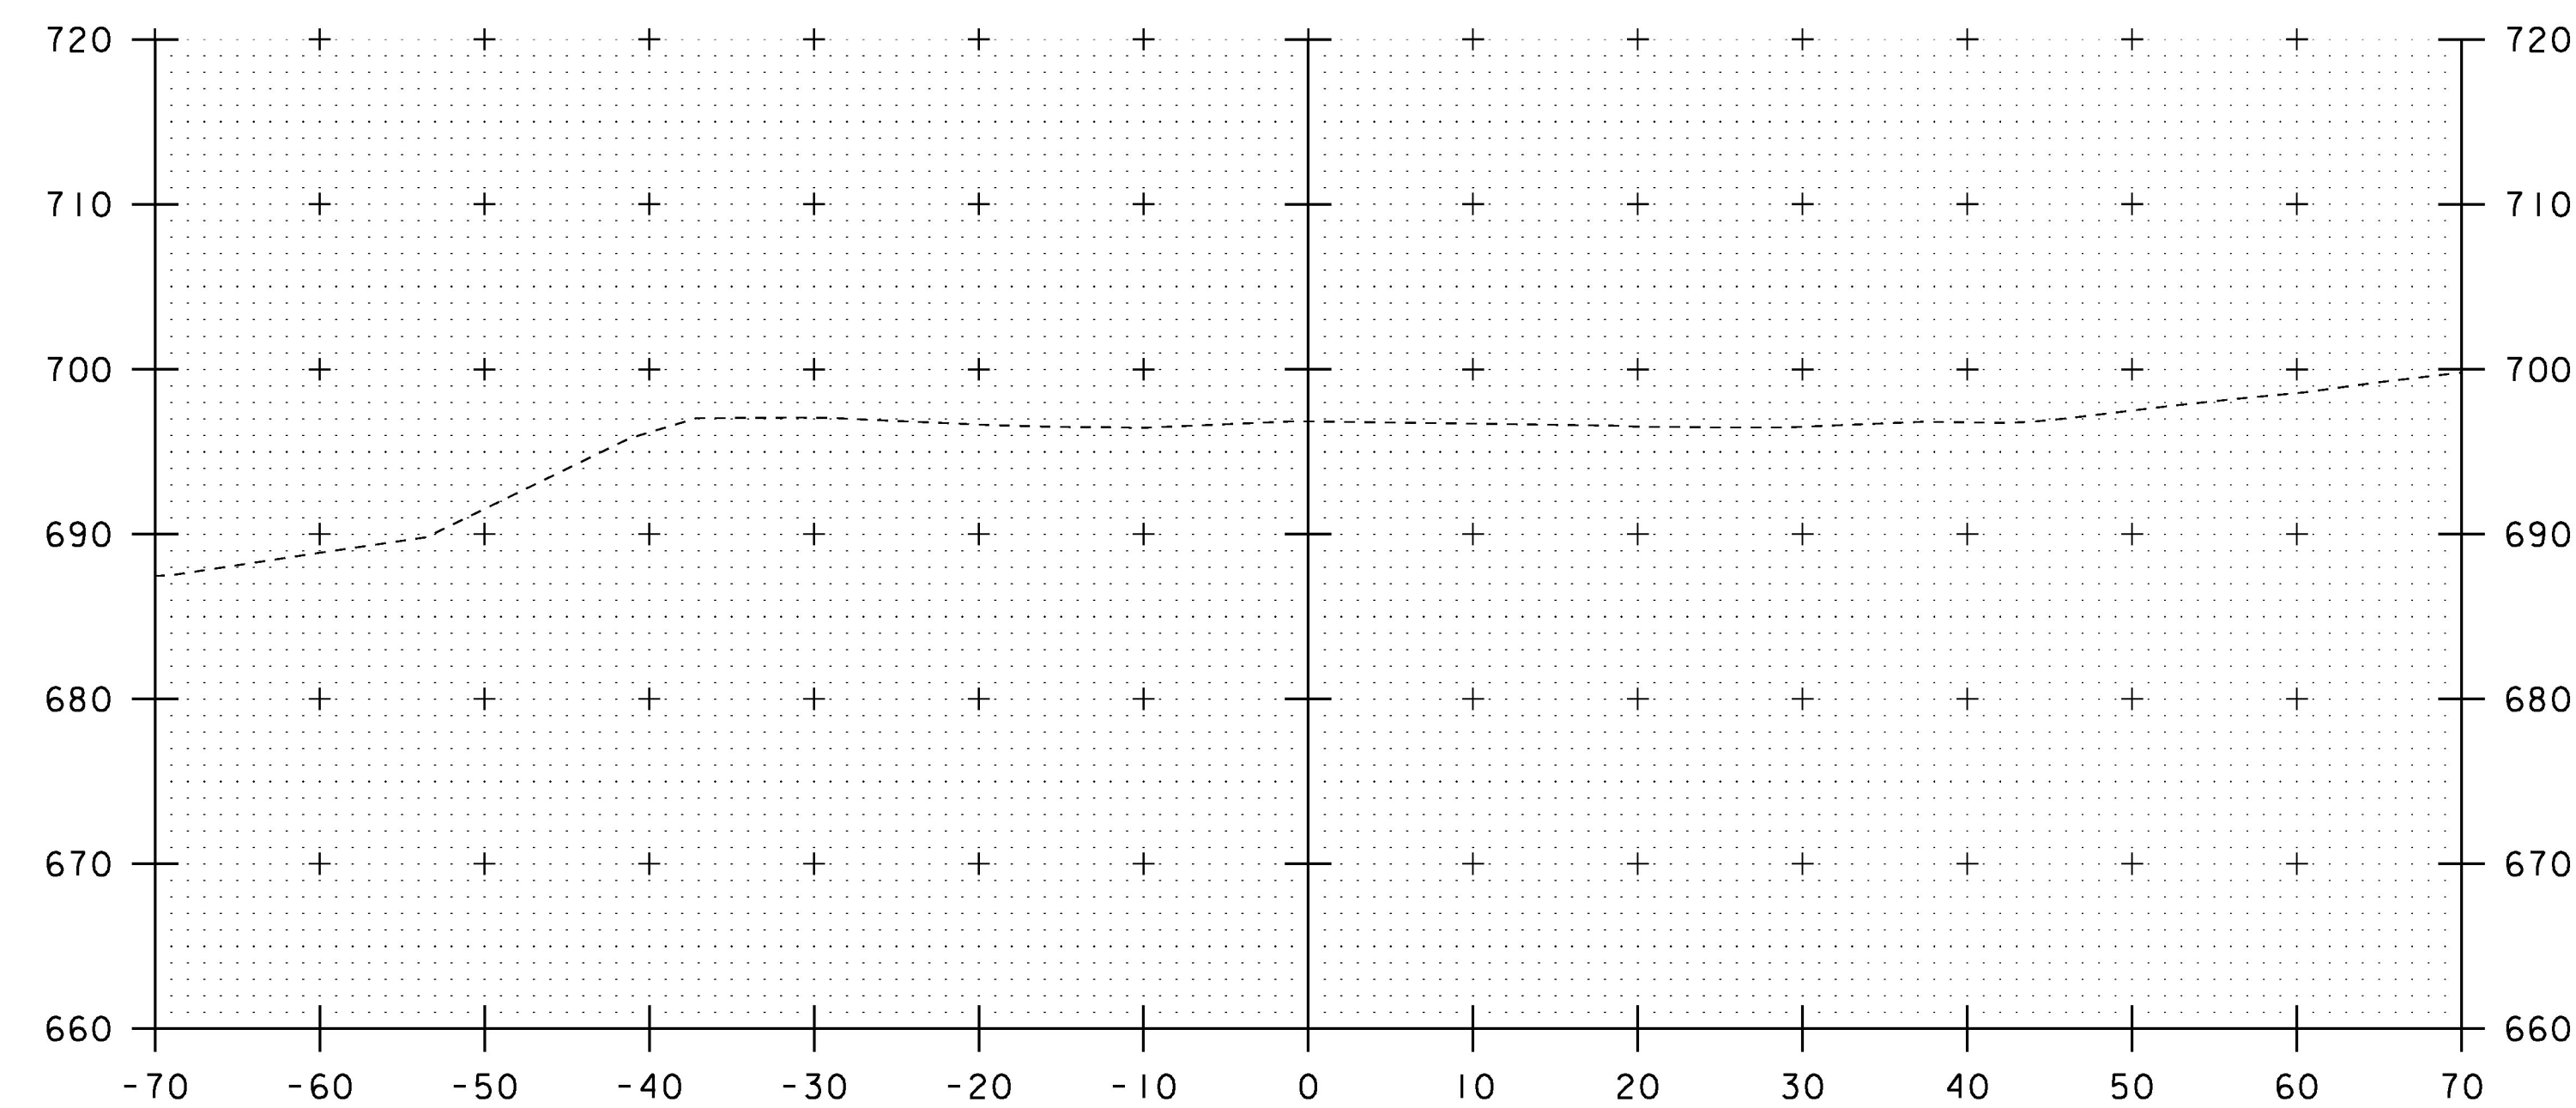

335+50

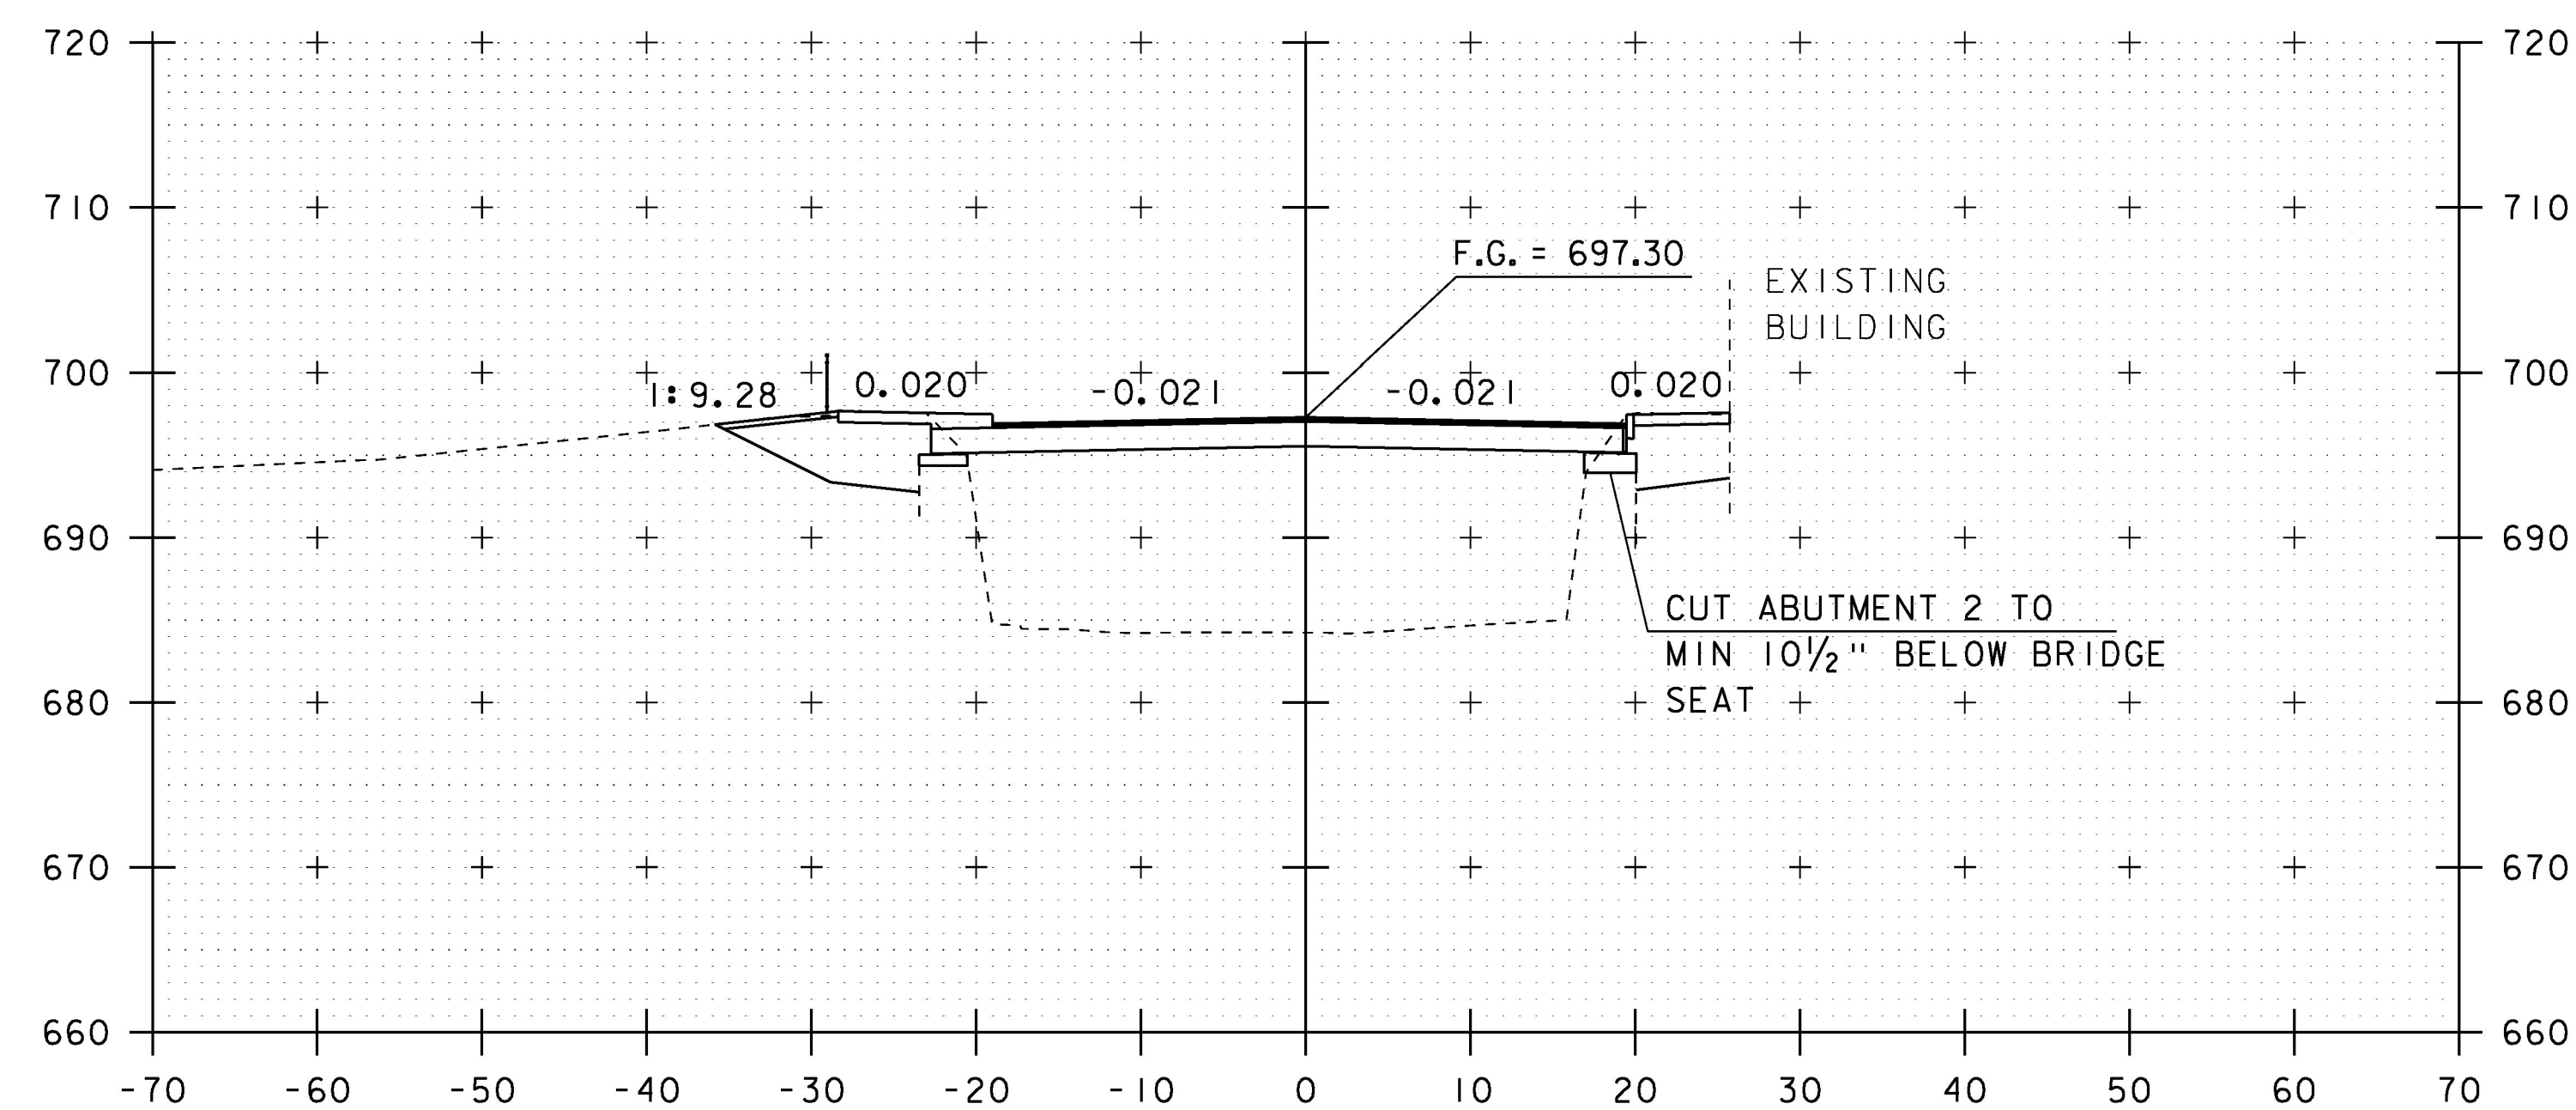

334+75
STA 334+90.79
END BRIDGE/PROJECT

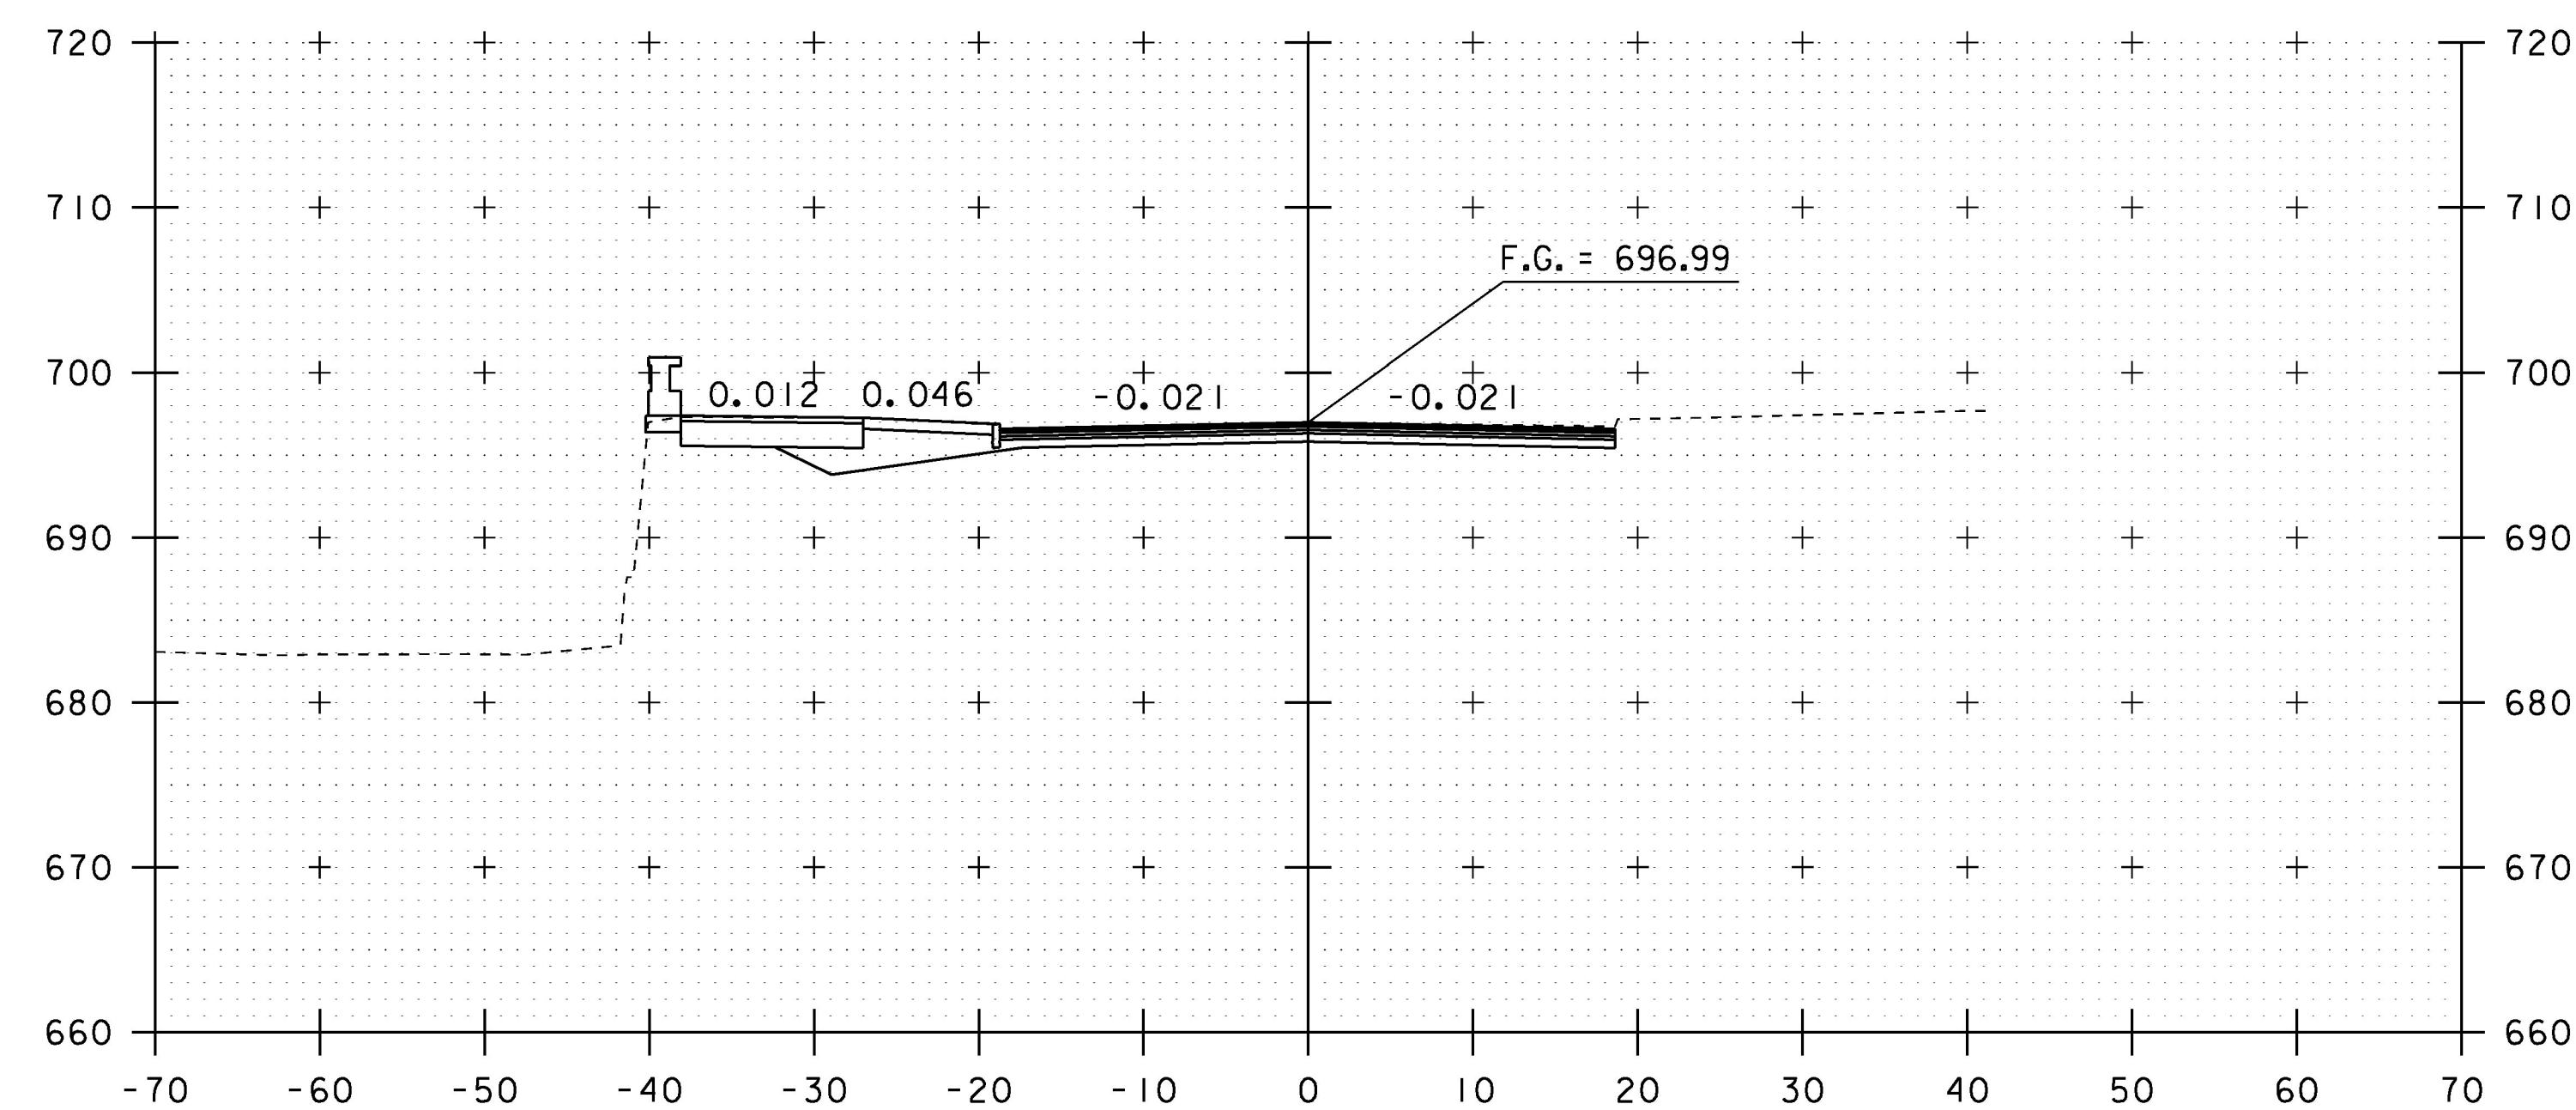

MATCH INTO EXISTING
SIDEWALK STA 335+35.4 LT
335+25
STA 335+40.00 MATCH EXISTING
END APPROACH

STA. 334+75 TO STA. 335+50

PROJECT NAME:	WOODSTOCK VILLAGE
PROJECT NUMBER:	BF 020-2(43)
FILE NAME: si3j280xs.dgn	PLOT DATE: 18-JUL-2017
PROJECT LEADER: R. YOUNG	DRAWN BY: S. COLEY
DESIGNED BY: S. COLEY	CHECKED BY: W. LAMMER
MAINLINE CROSS SECTIONS 2	SHEET 43 OF 53