




50+30

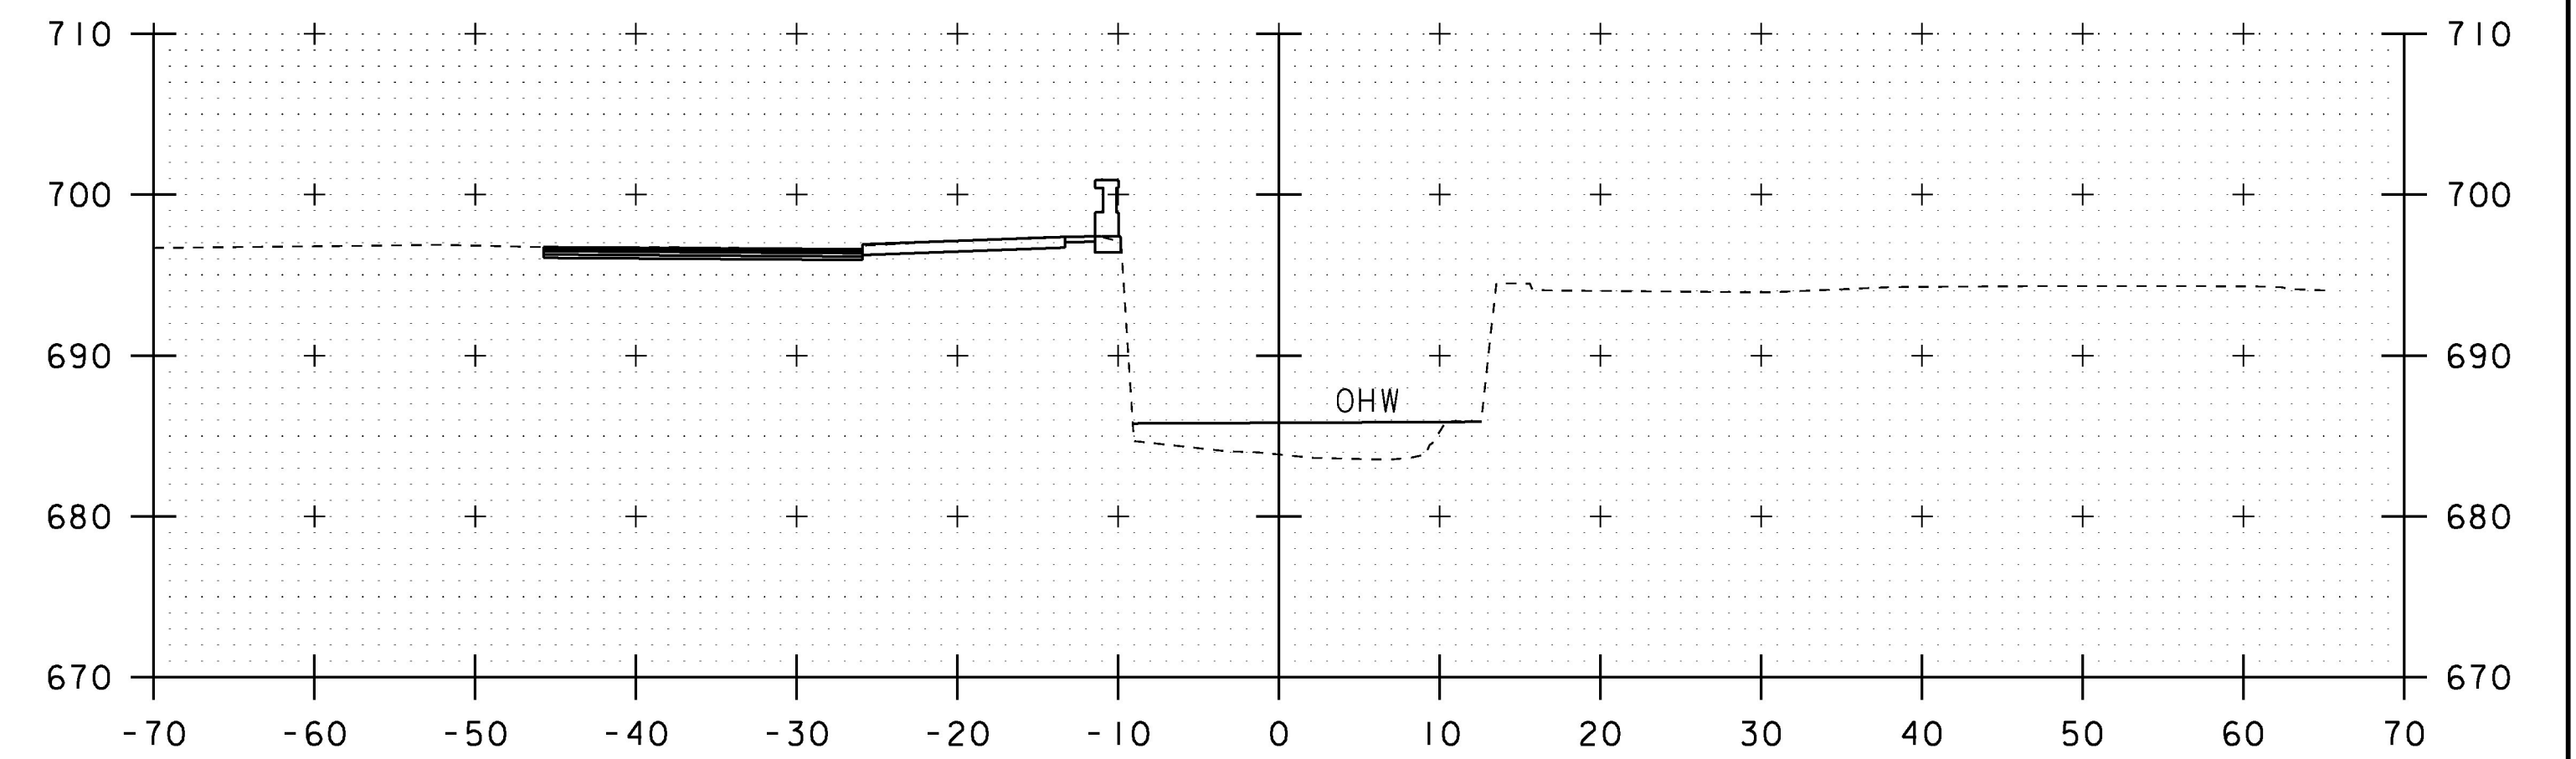

50+50

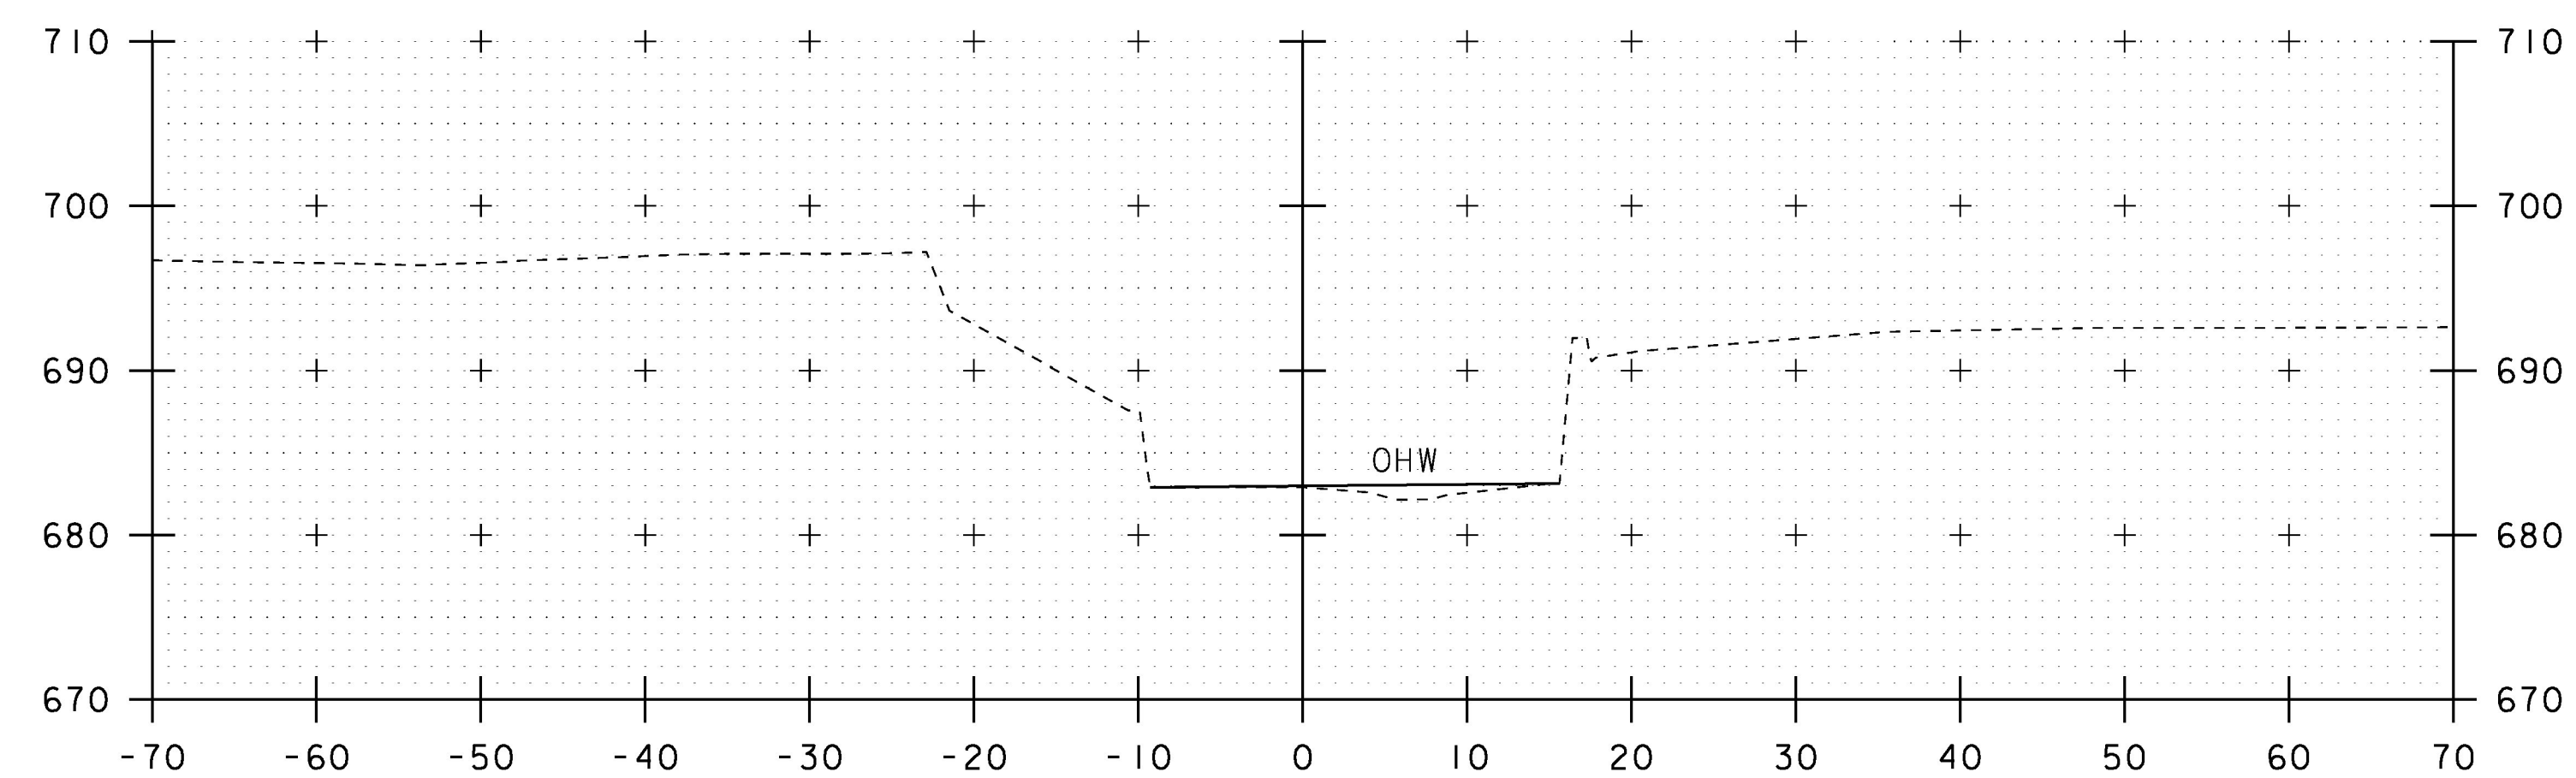

50+25

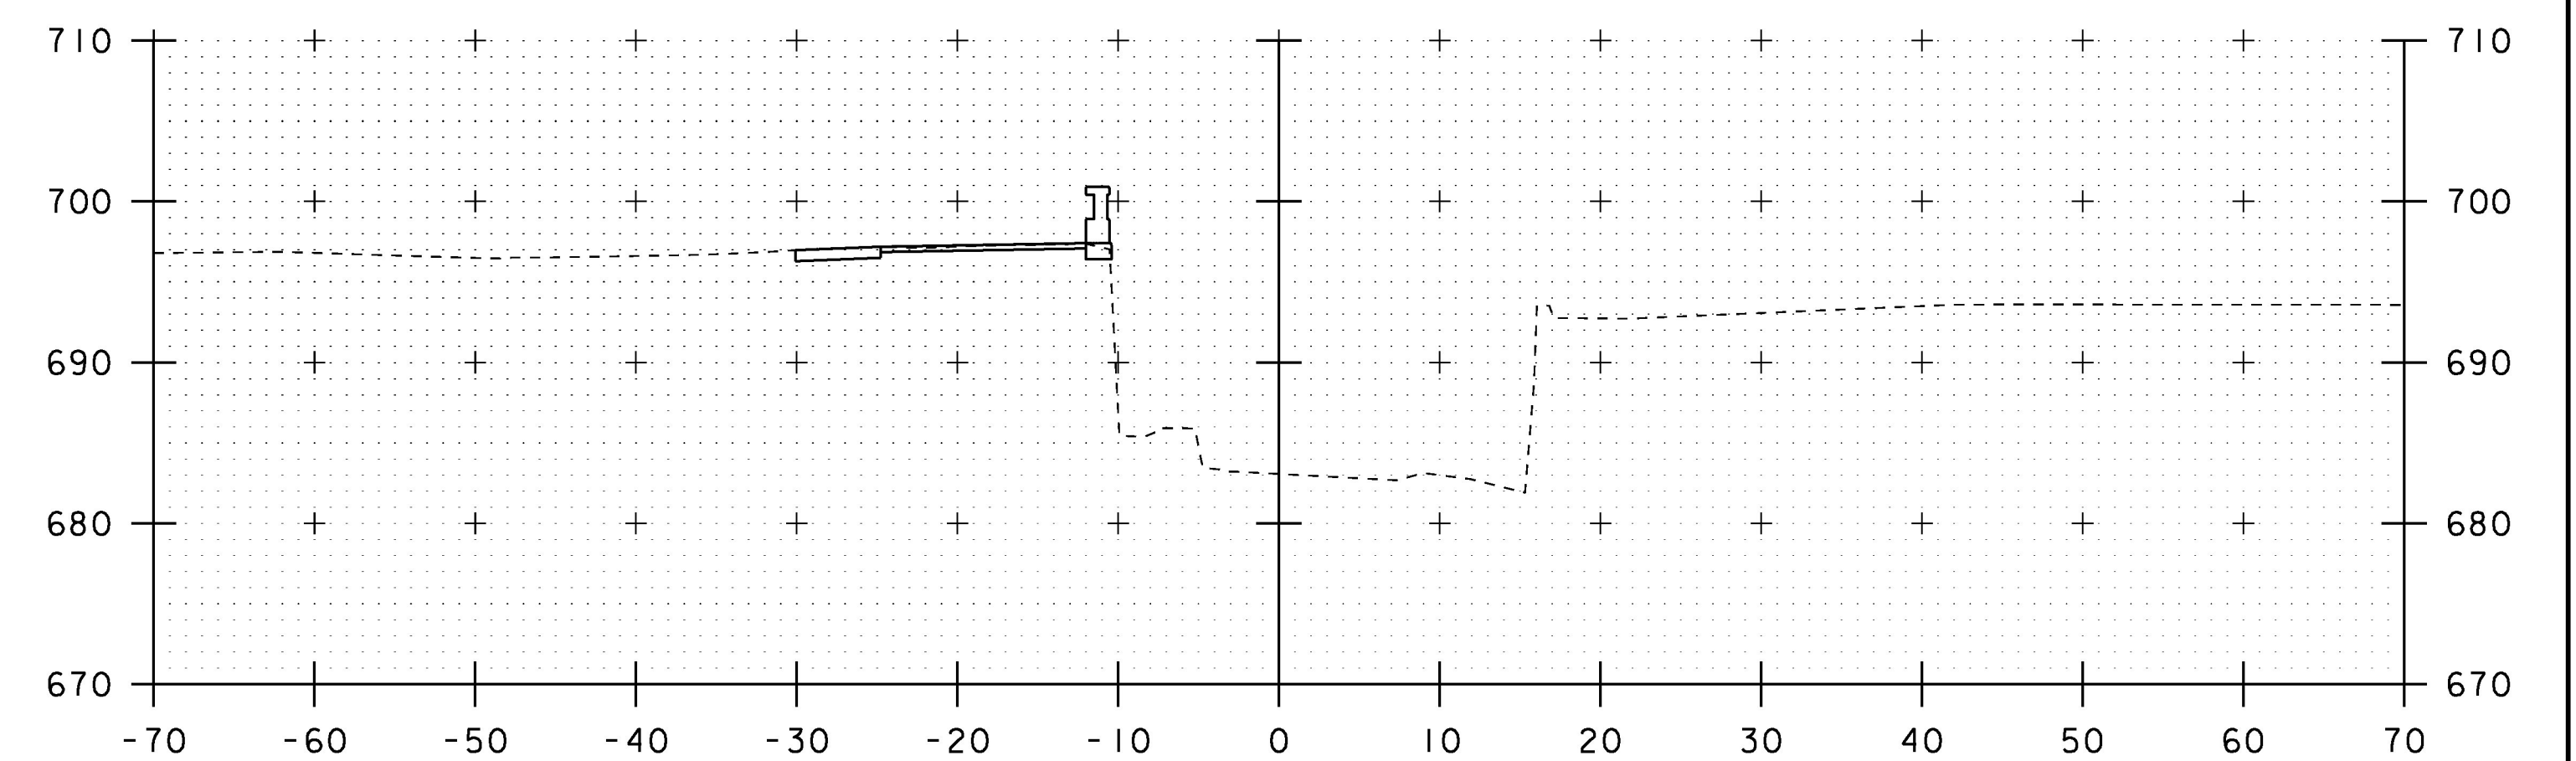

50+40

STA. 50+25 TO STA. 50+50

PROJECT NAME:	WOODSTOCK VILLAGE
PROJECT NUMBER:	BF 020-2(43)
FILE NAME:	sl3j280xs.dgn
PROJECT LEADER:	R. YOUNG
DESIGNED BY:	S. COLEY
CHANNEL CROSS SECTIONS I	
PLOT DATE:	18-JUL-2017
DRAWN BY:	S. COLEY
CHECKED BY:	W. LAMMER
SHEET	44 OF 53