




50+70

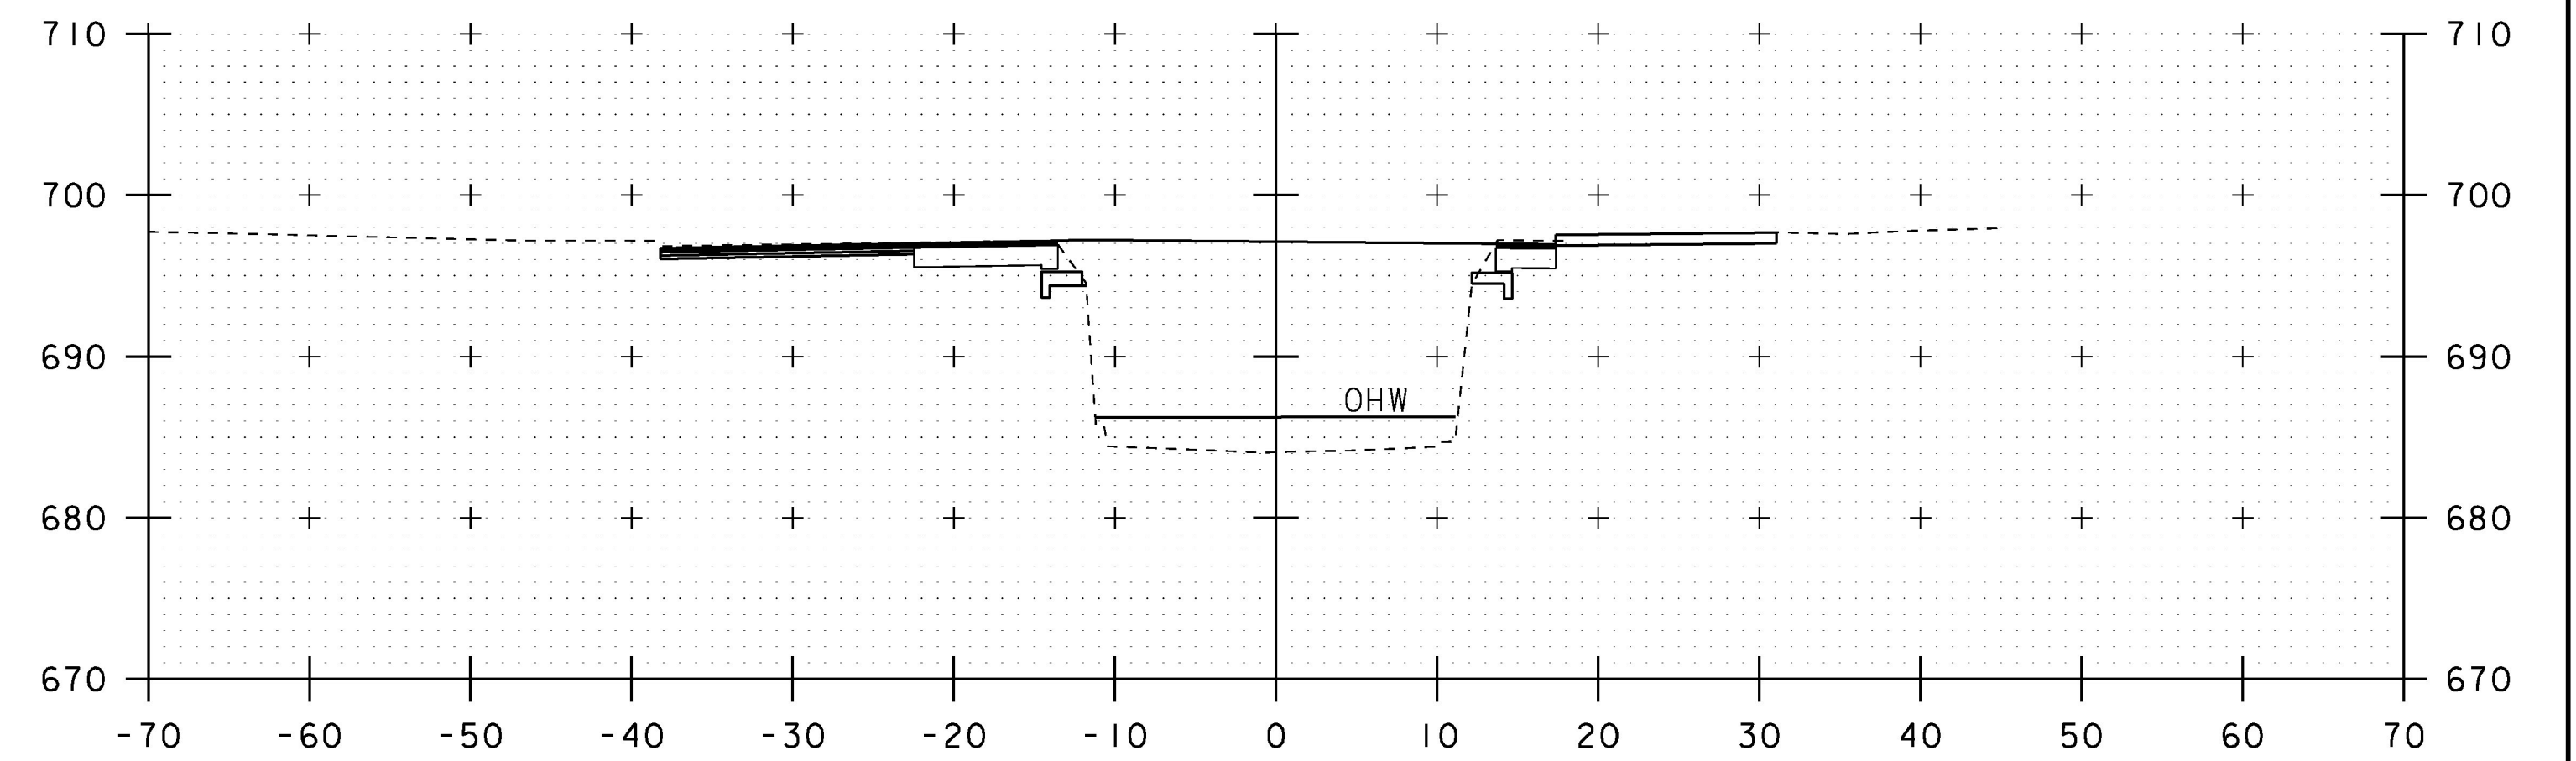

50+90

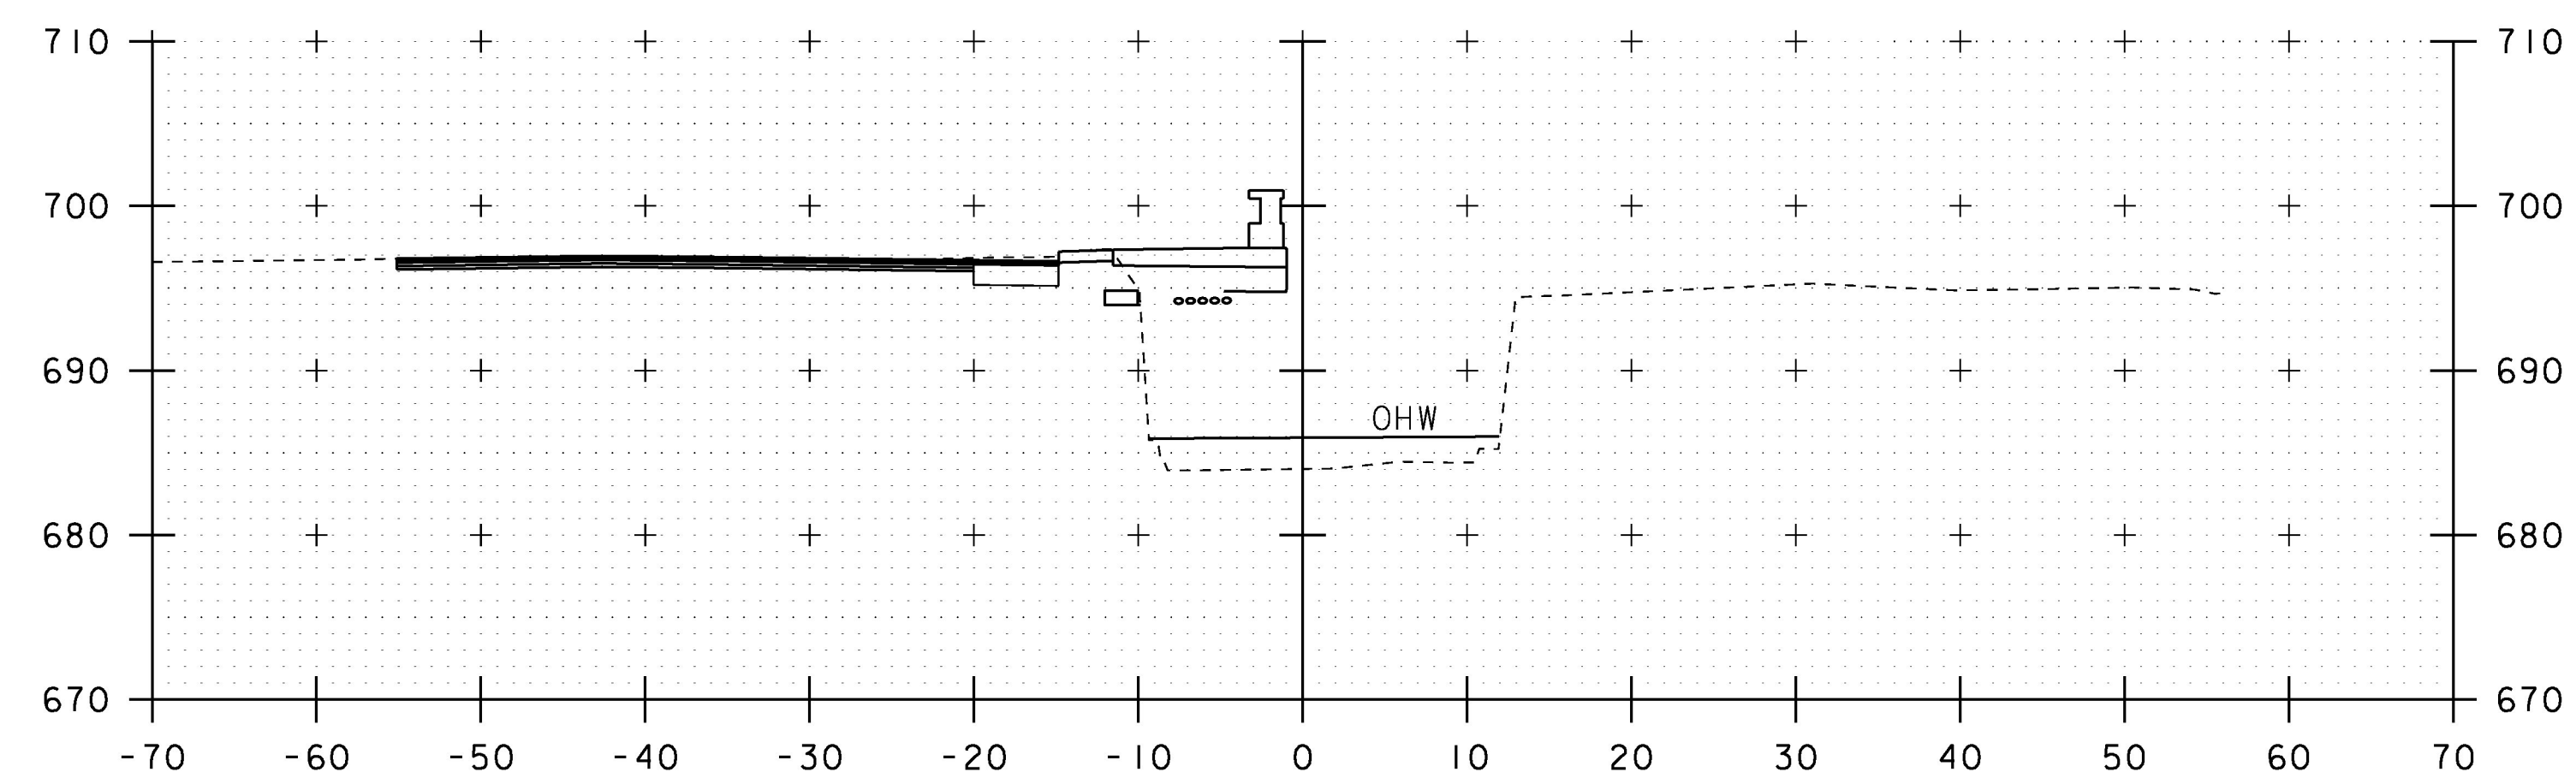

50+60

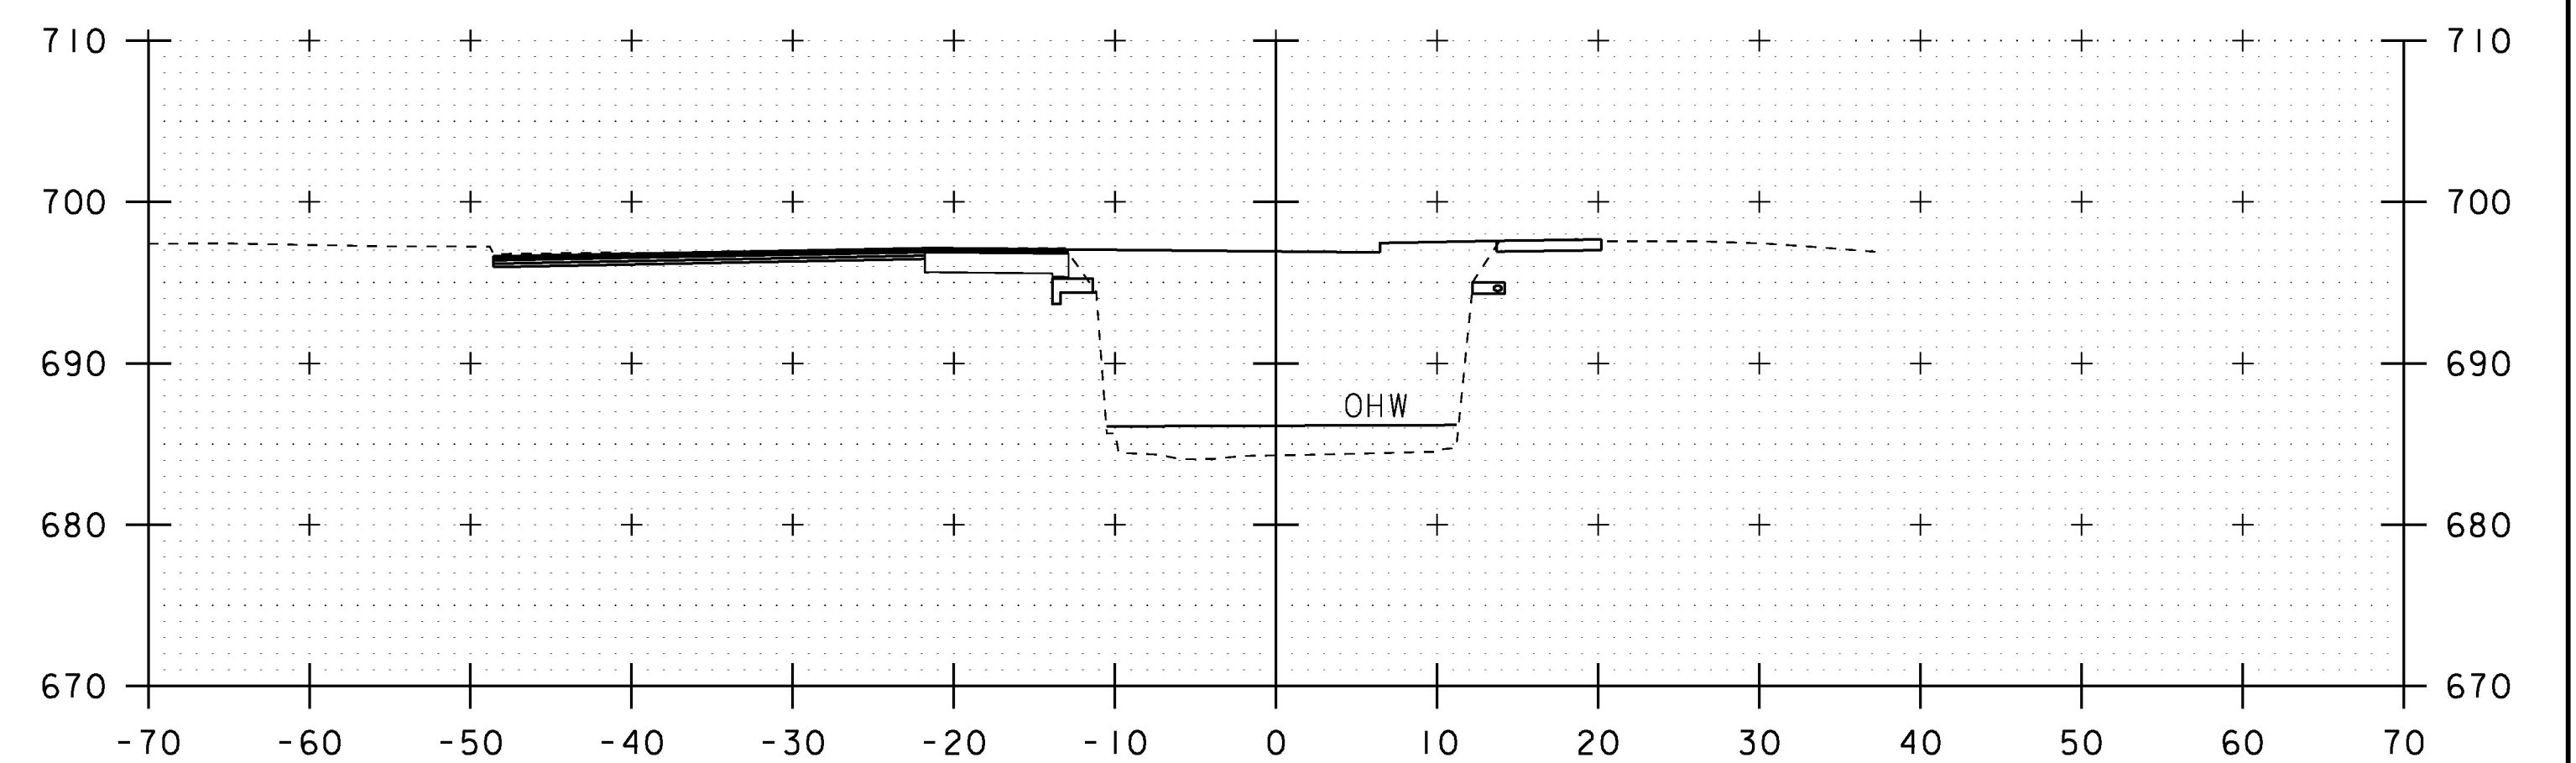

50+80

STA. 50+60 TO STA. 50+90

PROJECT NAME:	WOODSTOCK VILLAGE
PROJECT NUMBER:	BF 020-2(43)
FILE NAME:	sl3j280xs.dgn
PROJECT LEADER:	R. YOUNG
DESIGNED BY:	S. COLEY
CHANNEL CROSS SECTIONS 2	
PLOT DATE:	18-JUL-2017
DRAWN BY:	S. COLEY
CHECKED BY:	W. LAMMER
SHEET	45 OF 53