




51+50

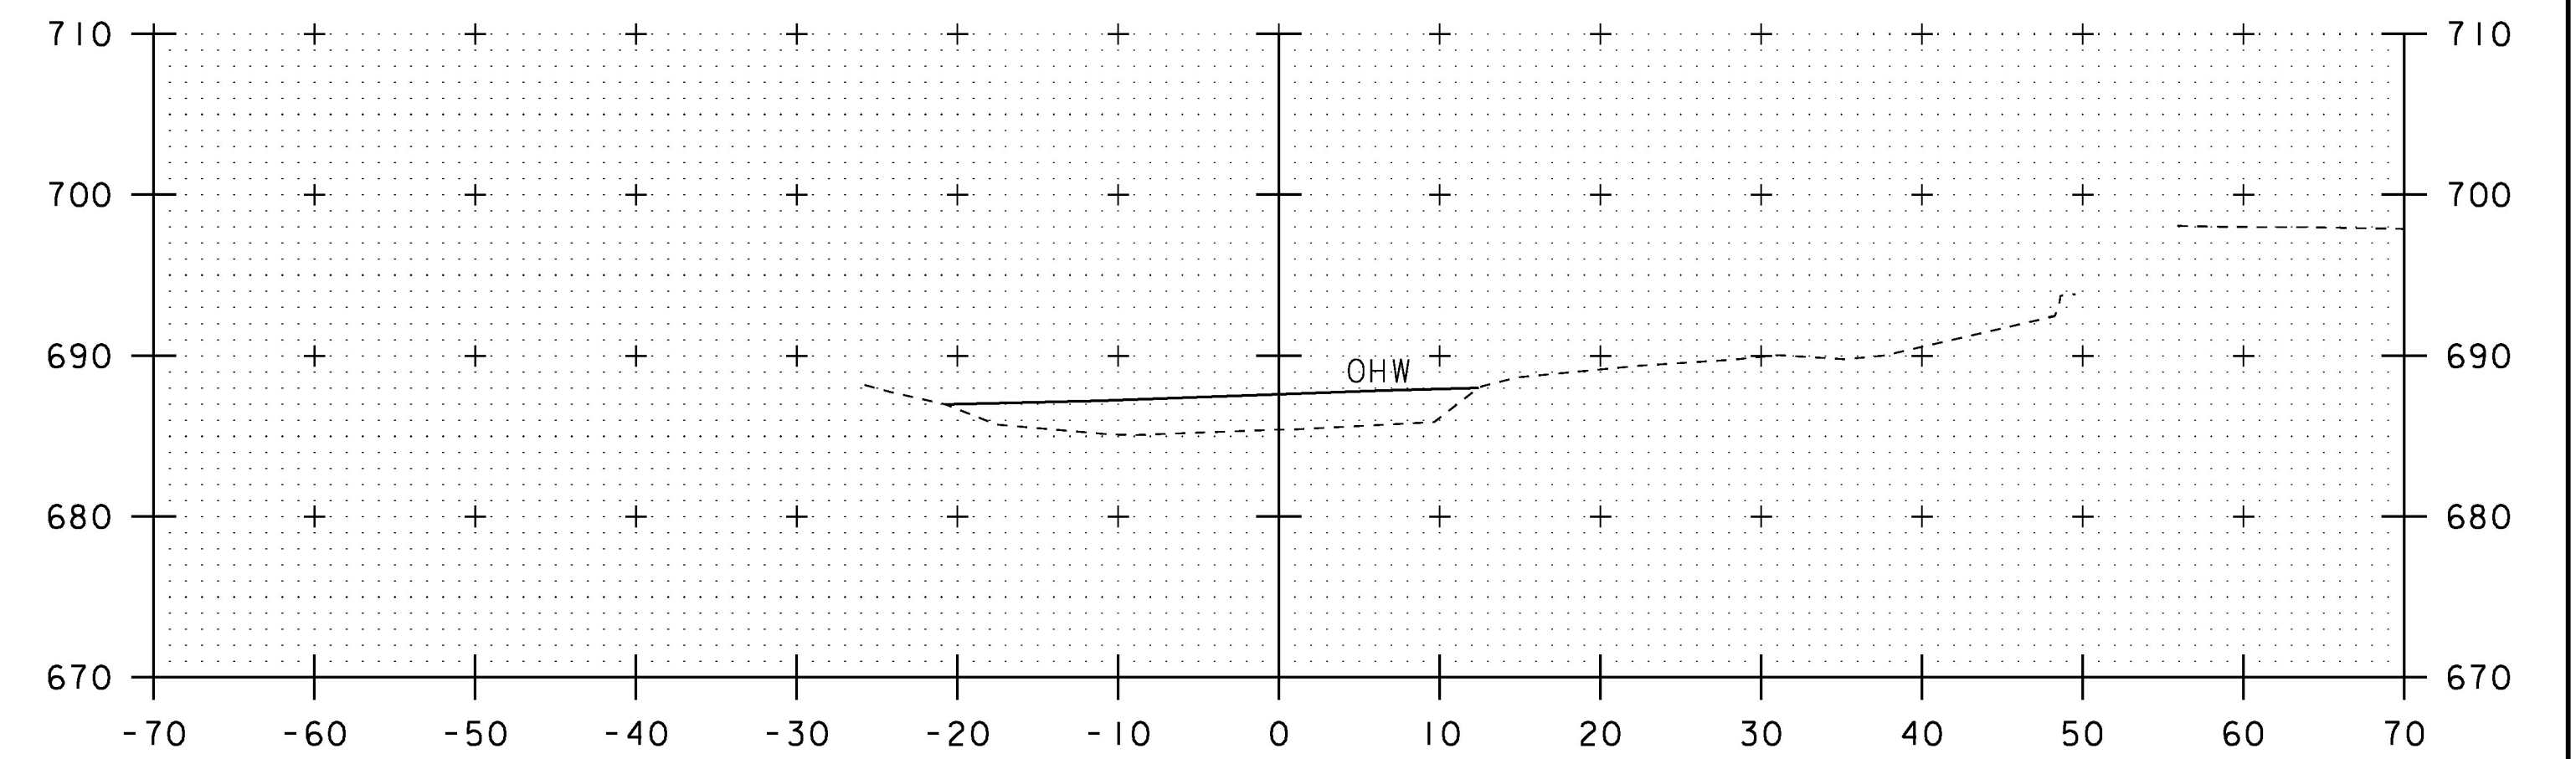

52+00

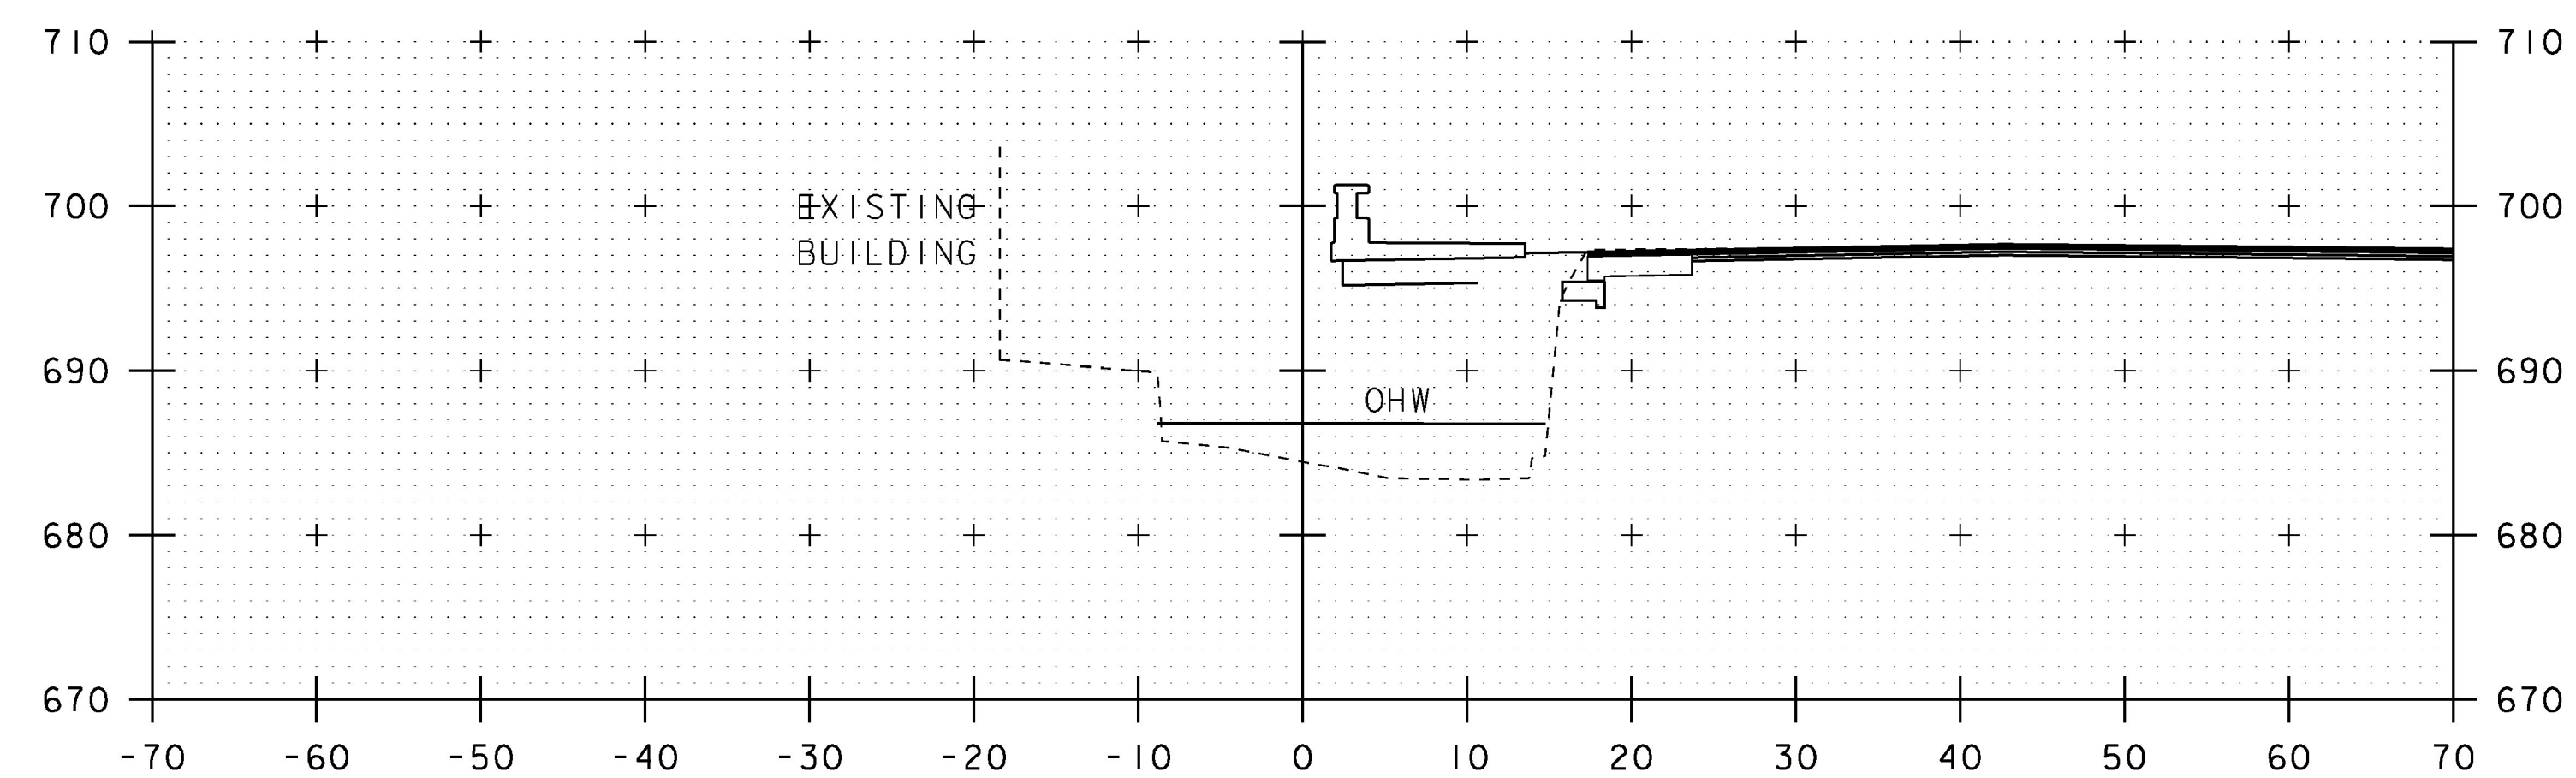

51+40

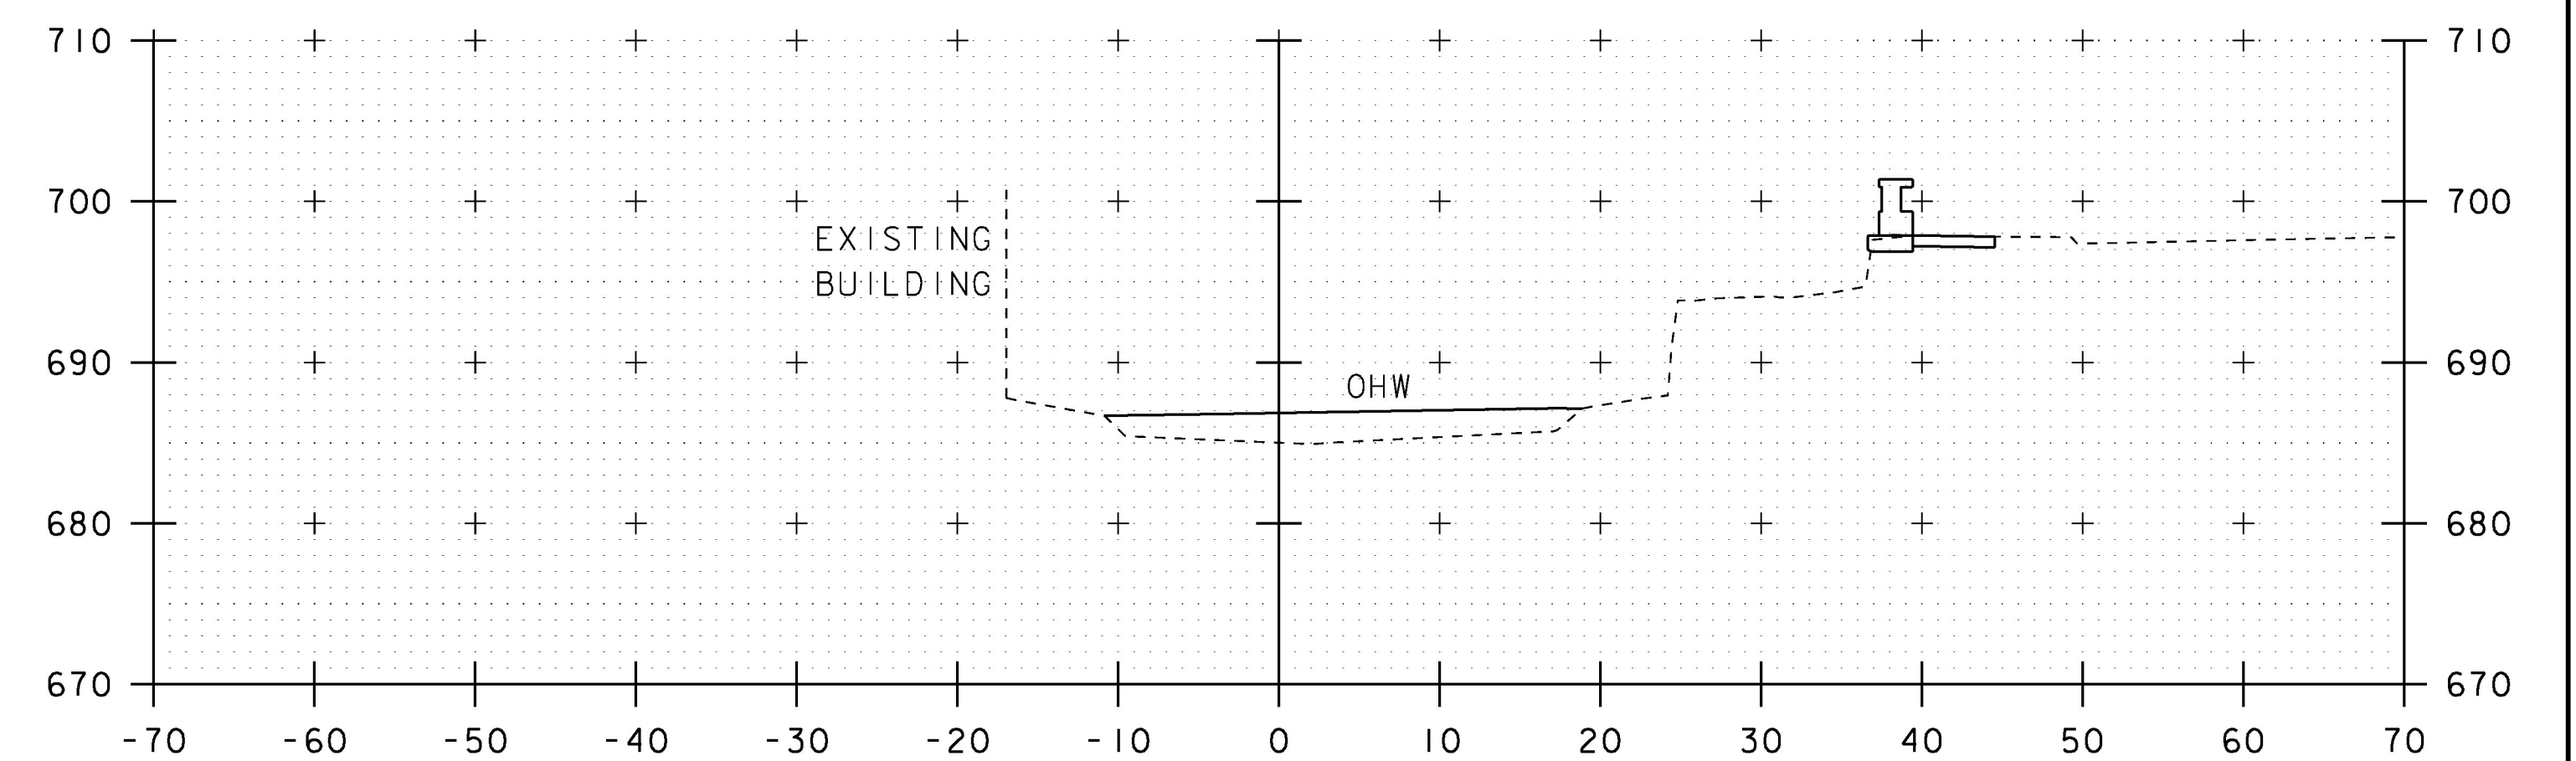

51+75

STA. 51+40 TO STA. 52+00

PROJECT NAME:	WOODSTOCK VILLAGE
PROJECT NUMBER:	BF 020-2(43)
FILE NAME:	sl3j280xs.dgn
PROJECT LEADER:	R. YOUNG
DESIGNED BY:	S. COLEY
CHANNEL CROSS SECTIONS	4
PLOT DATE:	18-JUL-2017
DRAWN BY:	S. COLEY
CHECKED BY:	W. LAMMER
SHEET	47 OF 53