



Vermont Agency of Transportation
RECEIVED

CK'D BY Stephen Coley OK'D BY Rob Young


February 13, 2017

RESUBMIT No Approved

BY Rob Young DATE 02/13/2017

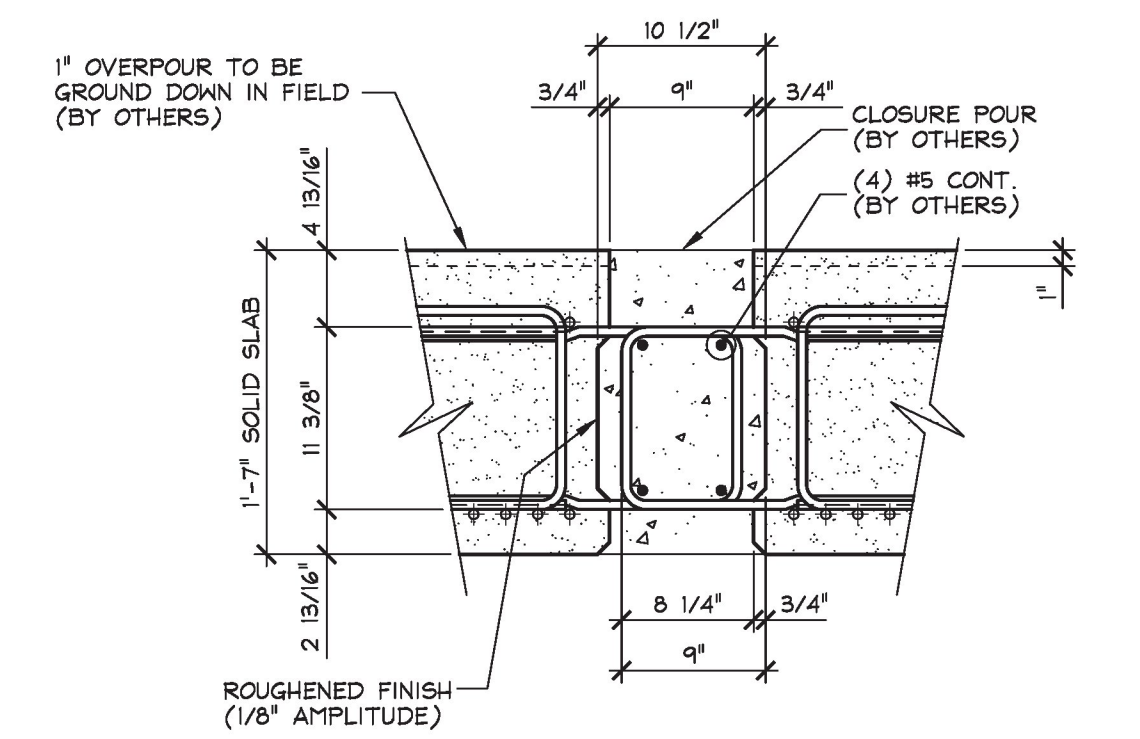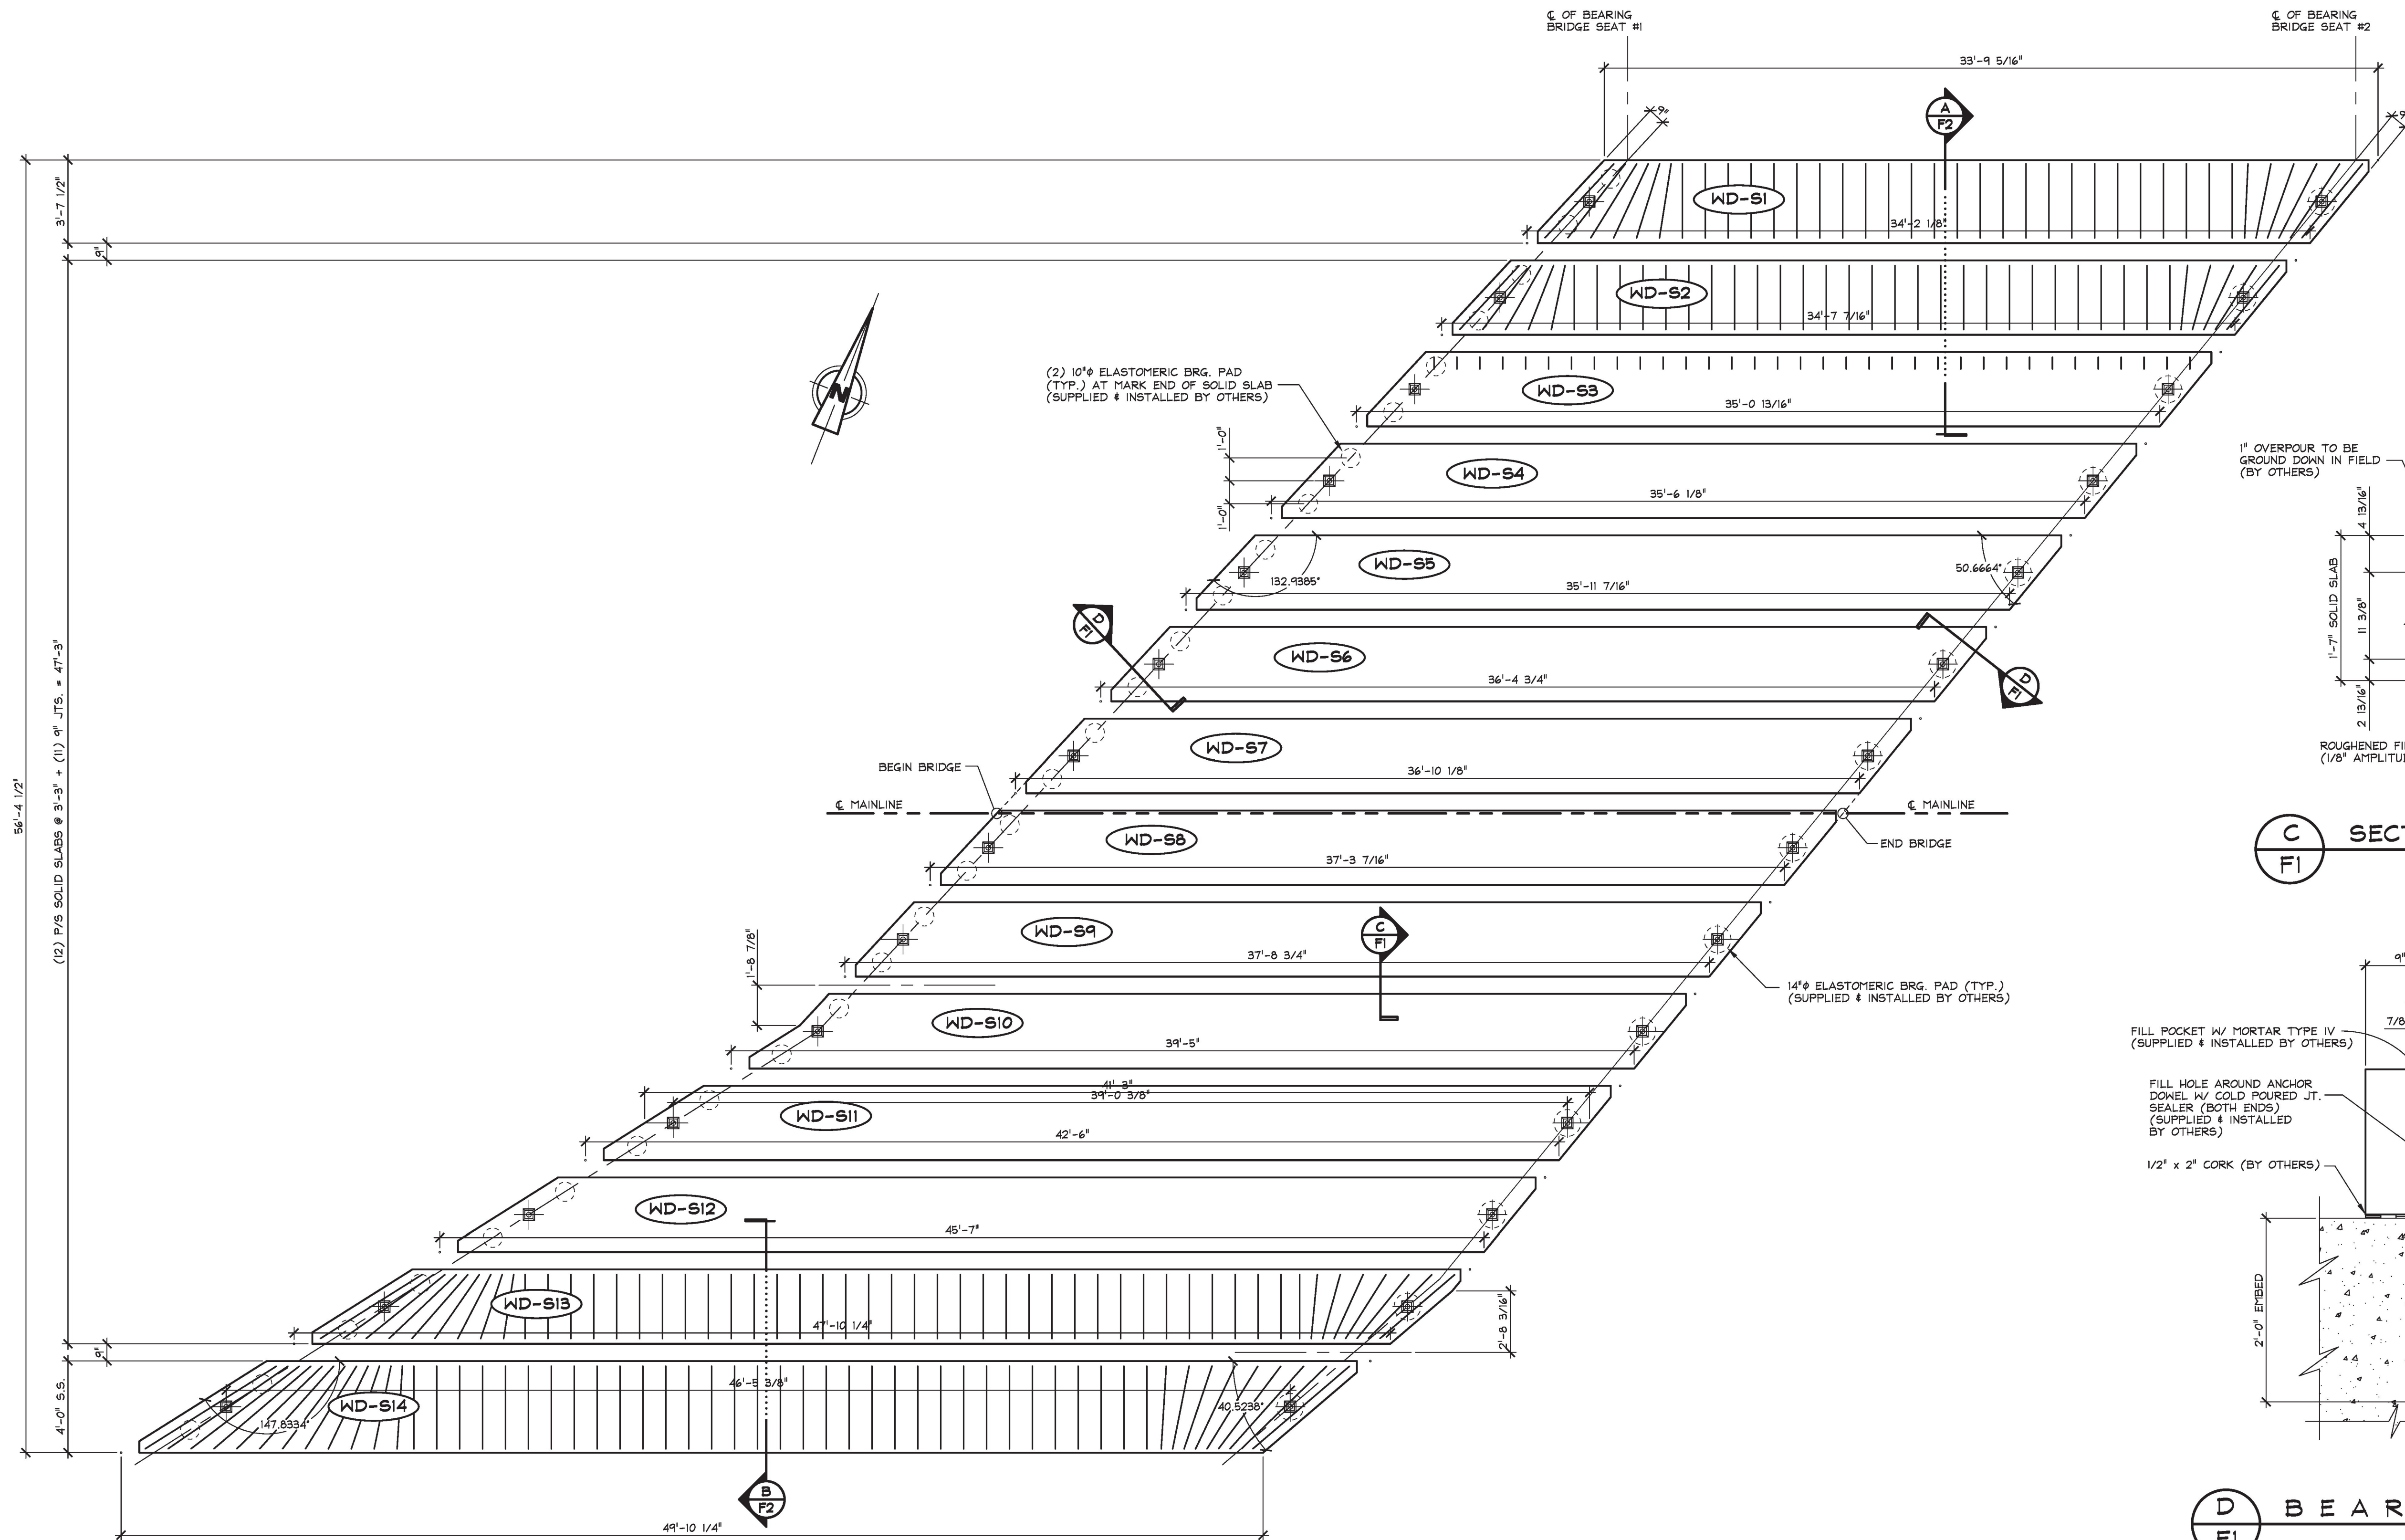

C
FI SECTION AT CLOSURE POUR
1" = 1'-0"

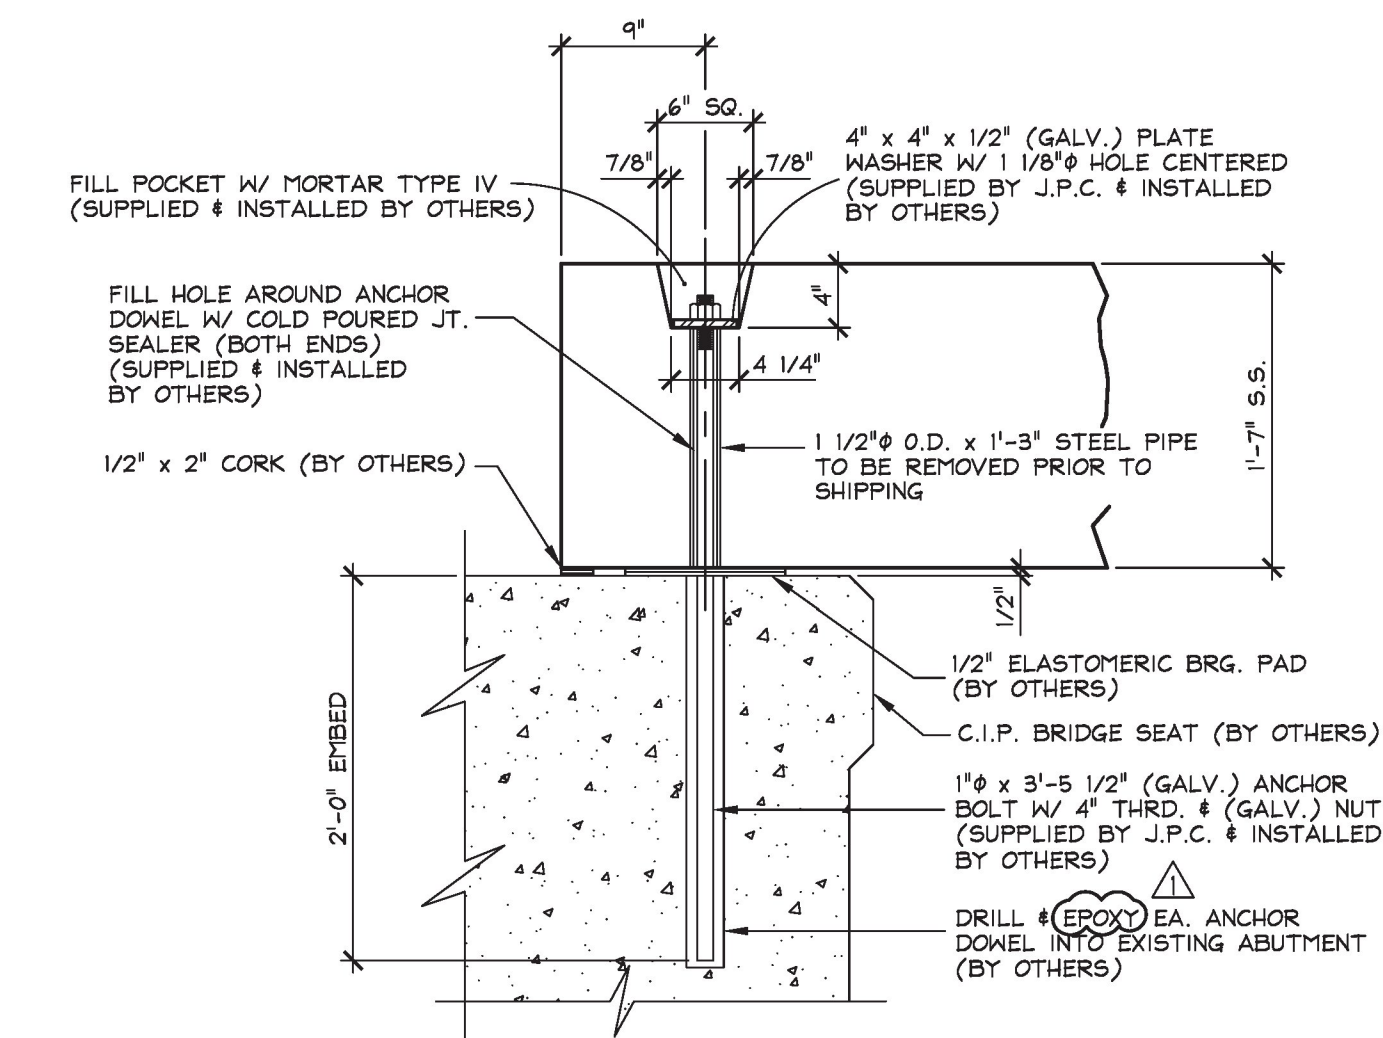

D
FI BEARING SECTION
1" = 1'-0"

I
FI PRESTRESSED SOLID SLAB LAYOUT
1/4" = 1'-0"

DESIGN LIVE LOAD: HL-93

Production/Record Set
2.13.18
J.P. CARRARA & SONS, INC.
MIDDLEBURY, VT 05753

2/12/18 REVISED AS PER ENGINEERS COMM. T.D.

APPROVAL STAMP:	J.P. CARRARA & SONS INC. Precast & Prestress Manufacturer 2454 CASE ST., MIDDLEBURY, VERMONT 05753 Phone:(802)388-6361 Fax:(802)388-9010		Cold River Bridges CONTRACTOR Walpole, New Hampshire
	STATE OF VERMONT AGENCY OF TRANSPORTATION COUNTY OF WINDSOR		DATE: JAN. 18, 2018 SCALE: NOTED
	WOODSTOCK VILLAGE TH 1/US 4 (CLASS 1) VILLAGE PRINCIPAL ARTERIAL BRIDGE NO.: 51 PROJECT NO.: BF 020-2 (43)		CHKD: A.S. DFTM: T.D. JOB NO: 23522-017
	P/S SOLID SLAB FRAMING PLAN		DWG. NO: F1