



A
S10 SOLID SLAB PLAN IN FORM
1/2" = 1'-0"

SHOP NOTE. SEE SHEET S10.1 FOR REINFORCING LAYOUT

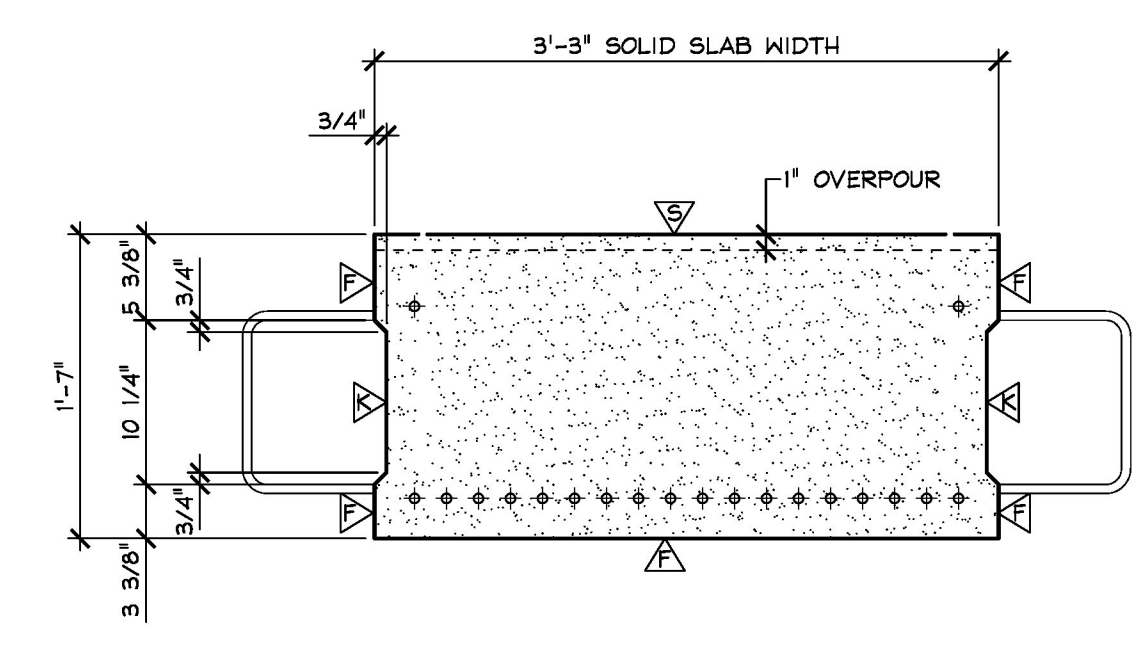


B
S10 DIMENSIONAL SECTION
1" = 1'-0"


- △ - SMOOTH SCREED FINISH
- △ - FORM FINISH
- △ - ROUGHENED FINISH (1/8" AMPLITUDE)

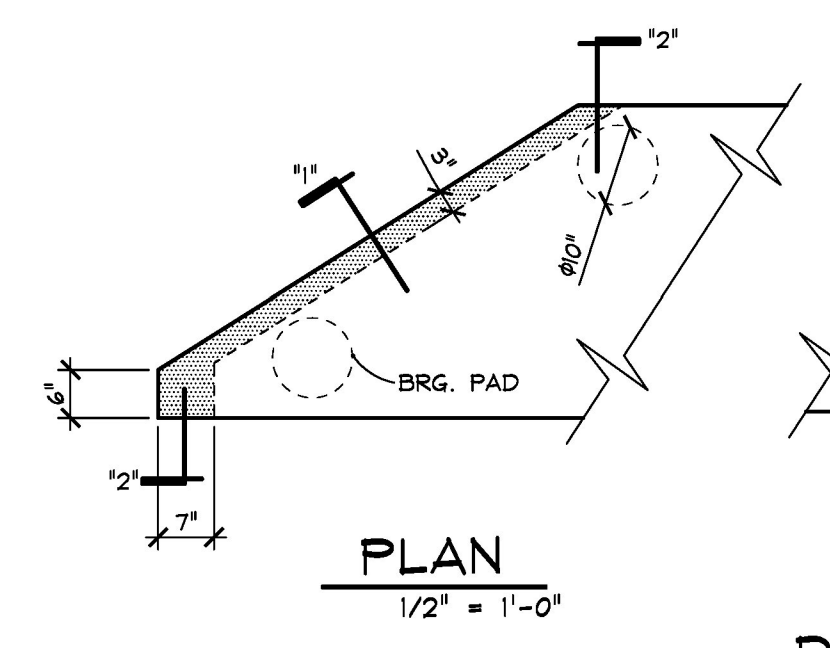


DETAIL - \"/>

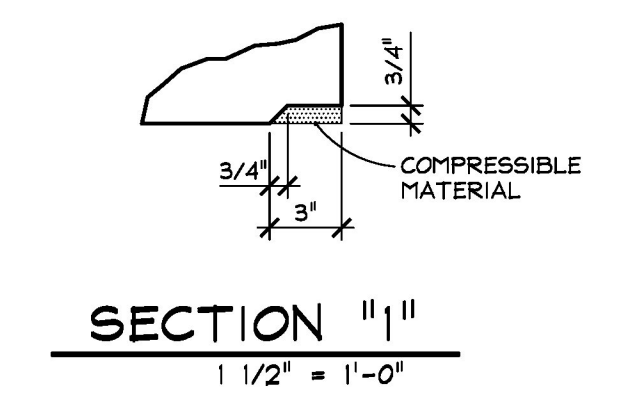


SECTION \"/>

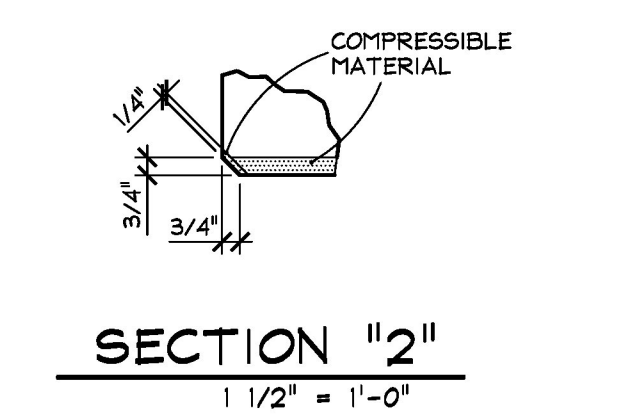


SECTION \"/>

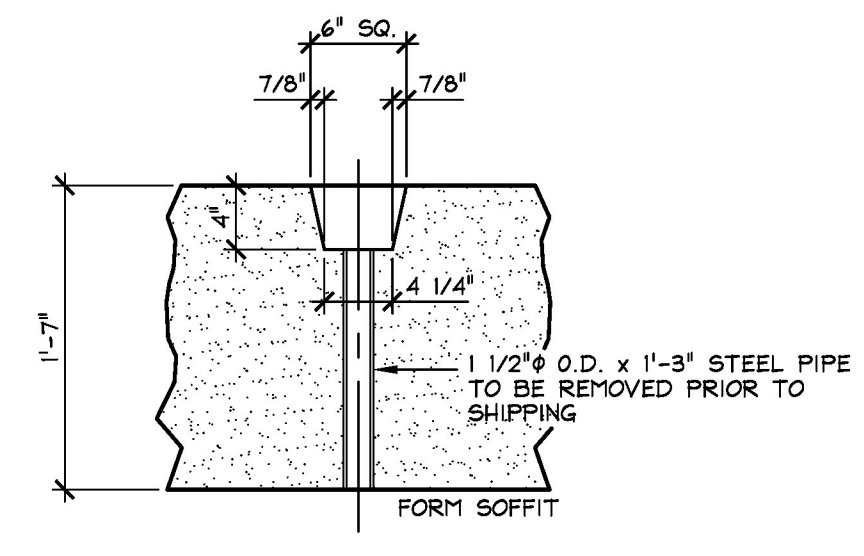

DETAIL - \"/>

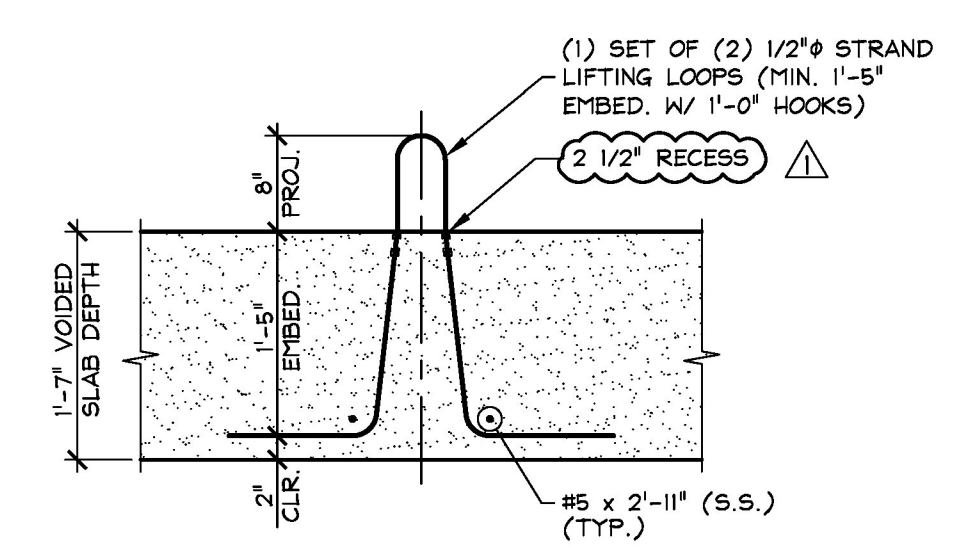

LIFT LOOP DETAIL
3/4" = 1'-0"

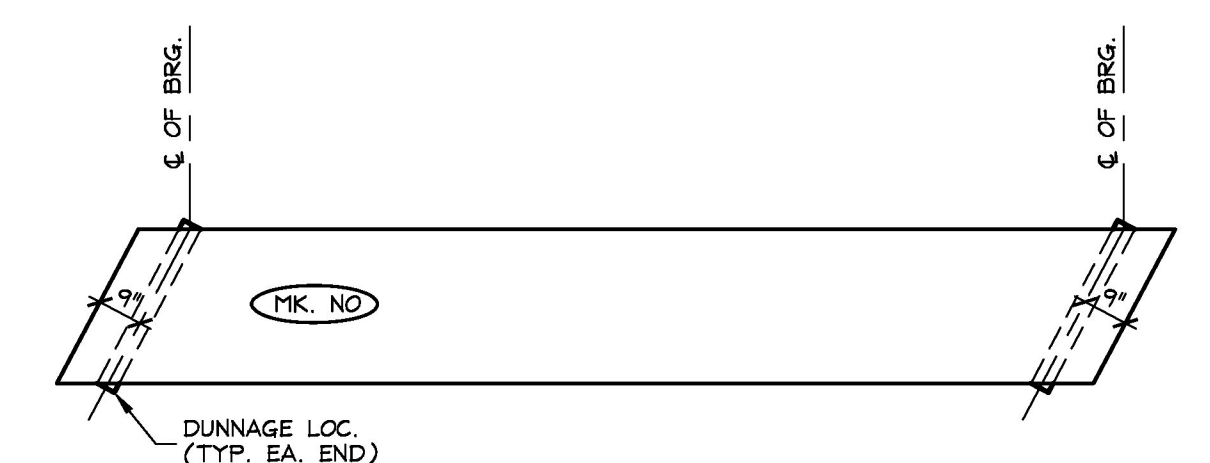

DUNNAGE LOCATION DETAIL
N.T.S.

Production/Record Set
2.13.18
J.P. CARRARA & SONS, INC.
MIDDLEBURY, VT 05753

2/12/18 REVISED AS PER ENGINEERS COMM. T.D.

Vermont Agency of Transportation
RECEIVED
CK'D BY Stephen Coley OK'D BY Rob Young
February 13, 2017
RESUBMIT No Approved
BY Rob Young DATE 02/13/2017

SHOP NOTE:
F_c = 8,000 PSI
F_{ci} = 5,500 PSI
MIX #430M1 ROCK

MARK: WD-S10 QTY.: 1 WT.: 14.40 T VOL.: 7.11 cy			
MATERIAL LIST / P/S SOLID SLAB			
ITEM	MARK	DESCRIPTION	WD-S10 QTY.
1			
2			
14		#5 x 2'-11" (STAINLESS STEEL)	4
15			
16			
29		1 1/2" O.D. x 1'-3" STEEL PIPE	2
30		(2) 1/2" # 270 KSI STRAND LIFT LOOPS	4
31			
32			

APPROVAL STAMP:	J.P. CARRARA & SONS INC. Precast & Prestress Manufacturer 2464 CASE ST., MIDDLEBURY, VERMONT 05753 Phone:(802)388-6361 Fax:(802)388-9010		Cold River Bridges CONTRACTOR WALPOLE, NEW HAMPSHIRE	
	STATE OF VERMONT AGENCY OF TRANSPORTATION COUNTY OF WINDSOR		DATE: JAN. 18, 2018 SCALE: NOTED	
	WOODSTOCK VILLAGE VT. ROUTE 4 (CLASS 1), VILLAGE PRINCIPAL ARTERIAL BRIDGE NO.: 51 PROJECT NO.: BF 020-2 (43)		CHKD: A.S. DFTM: T.D. JOB NO: 23522-017	
	SOLID SLAB DETAILS		DWG. NO: S10	