




SOLID SLAB MATERIAL: WD-S11, WD-S12, WD-S13

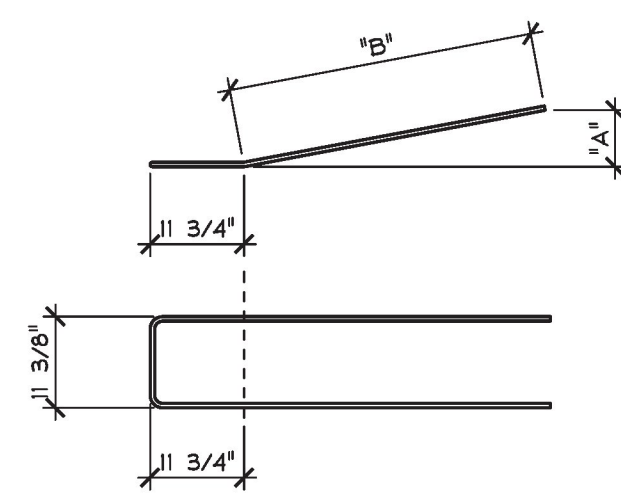

#4 MODIFIED HAIRPIN
STAINLESS STEEL
USE 2# PIN

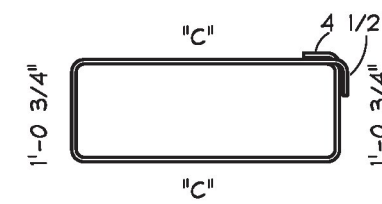

#4 STIRRUP
STAINLESS STEEL
USE 2# PIN

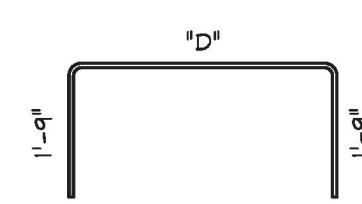


#4 STIRRUP
STAINLESS STEEL
USE 2# PIN


MARK	QTY.	A DIM.	B DIM.
WD410S	50	2'-3 1/2"	3'-7 3/8"
WD428S	6	2'-4 1/4"	3'-7 3/4"
WD429S	3	2'-1 1/4"	3'-5 7/8"
WD430S	6	1'-10 1/4"	3'-4 1/4"
WD431S	3	1'-7 1/4"	3'-0 5/8"
WD432S	6	1'-4 1/4"	3'-1 1/4"
WD433S	3	1'-1 1/4"	3'-0"
WD434S	6	10 1/4"	2'-11"
WD435S	3	7 1/4"	2'-10 1/4"
WD436S	6	4 1/4"	2'-9 3/4"
WD437S	3	2'-0 1/2"	3'-5 1/2"
WD438S	6	1'-9 1/2"	3'-3 3/4"
WD439S	3	1'-6 1/2"	3'-2 1/4"
WD440S	6	1'-3 1/2"	3'-0 7/8"
WD441S	3	1'-0 1/2"	2'-11 3/4"
WD442S	6	9 1/2"	2'-10 3/4"
WD443S	3	6 1/2"	2'-10 1/8"
WD444S	6	3 1/2"	2'-9 3/4"
WD4017S	72	4'-5 1/4"	5'-3"
WD4018S	3	2'-5 3/4"	3'-8 3/4"
WD4019S	6	2'-8 3/4"	3'-10 7/8"
WD4020S	3	2'-11 3/4"	4'-1"
WD4021S	6	3'-2 3/4"	4'-3 1/4"
WD4022S	3	3'-5 1/2"	4'-5 1/4"
WD4023S	6	3'-8 3/4"	4'-8"
WD4024S	3	3'-11 3/4"	4'-10 3/8"
WD4034S	24	3'-3 1/4"	4'-3 1/2"
WD4039S	2	2'-3 1/4"	3'-7 1/8"
WD4040S	1	2'-6 1/4"	3'-9 1/8"
WD4041S	2	2'-5 3/4"	3'-8 3/4"
WD4042S	1	3'-0 1/4"	4'-1 3/8"

MARK	QTY.	C DIM.
WD401S	130	2'-9 1/2"
WD4015S	75	3'-9 3/4"
WD408S	50	3'-7 3/8"
WD411S	3	2'-9 3/4"
WD412S	3	2'-10 1/4"
WD413S	3	2'-11"
WD414S	3	3'-0"
WD415S	3	3'-1 1/4"
WD416S	3	3'-2 5/8"
WD417S	3	3'-4 1/4"
WD418S	3	3'-5 7/8"
WD419S	3	3'-7 3/4"
WD420S	3	2'-9 3/4"
WD421S	3	2'-10 1/8"
WD422S	3	2'-10 3/4"
WD423S	3	2'-11 3/4"
WD424S	3	3'-0 7/8"
WD425S	3	3'-2 1/4"
WD426S	3	3'-3 1/4"
WD427S	3	3'-5 1/2"
WD4025S	3	2'-9 1/2"
WD4026S	3	3'-10 1/2"
WD4027S	3	4'-0 5/8"
WD4028S	3	4'-2 7/8"
WD4029S	3	4'-5 1/8"
WD4030S	3	4'-7 1/2"
WD4031S	3	4'-10"
WD4032S	3	5'-0 3/8"
WD4033S	23	4'-3 1/2"
WD4035S	1	3'-7 1/8"
WD4036S	1	3'-9 1/8"
WD4037S	1	3'-11 1/4"
WD4038S	1	4'-1 3/8"


MARK	QTY.	D DIM.
WD4043S	35	2'-9 1/2"
WD4044S	1	5'-3"
WD4045S	1	4'-10"
WD4046S	1	4'-5 1/8"
WD4047S	1	4'-0 5/8"
WD4048S	1	3'-8 1/2"
WD4049S	1	3'-4 3/4"
WD4050S	1	3'-1 3/4"
WD4051S	1	2'-11 1/4"
WD4052S	1	2'-10"
WD4053S	1	2'-9 5/8"
WD4054S	1	2'-10 3/4"
WD4055S	1	3'-0 3/4"
WD4056S	1	3'-5 5/8"
WD4057S	1	3'-7 1/8"
WD4058S	1	3'-11 1/4"
WD4059S	1	4'-3 1/2"

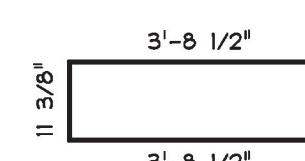


WD402S
#4 BENT BAR
STAINLESS STEEL
USE 2# PIN
(25) REQ'D.

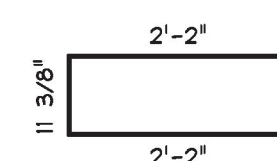

WD501S
#5 BENT BAR
STAINLESS STEEL
USE 2 1/2# PIN
(36) REQ'D.

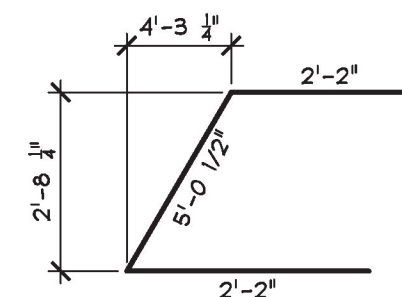


WD506S
#5 BENT BAR
STAINLESS STEEL
USE 2 1/2# PIN
(9) REQ'D.

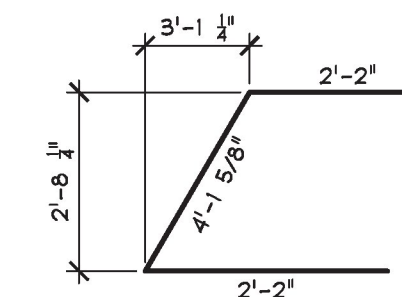


WD507S
#5 BENT BAR
STAINLESS STEEL
USE 2 1/2# PIN
(3) REQ'D.

MISCELLANEOUS MATERIALS			PIER CAP	
ITEM	MARK	QTY.	DESCRIPTION	REMARKS
1		6	1 1/2" O.D. x 1'-3" STEEL SLEEVE	
2		12	#5 x 2'-11" (STAINLESS STEEL)	
3		6	#5 x 5'-3" (STAINLESS STEEL)	
4		4	#5 x 3'-10" (STAINLESS STEEL)	
5		2	#5 x 4'-3" (STAINLESS STEEL)	
6		12	(2) 1/2" 270 KSI STRAND LIFT LOOPS	SEE DETAIL


SOLID SLAB MATERIAL: WD-S14

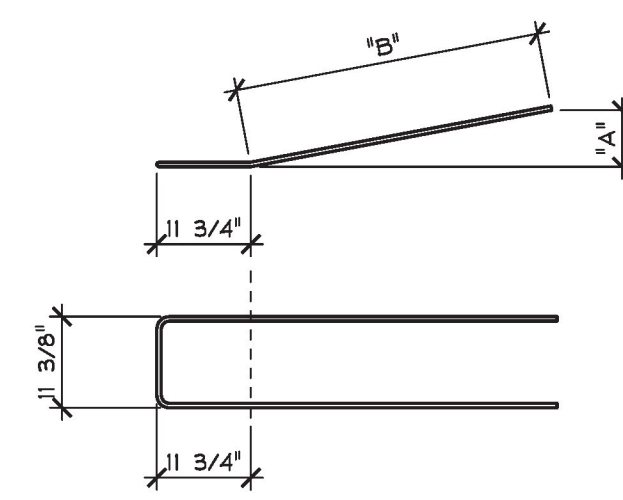

#4 MODIFIED HAIRPIN
STAINLESS STEEL
USE 2# PIN

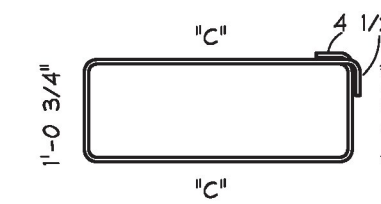

#4 STIRRUP
STAINLESS STEEL
USE 2# PIN

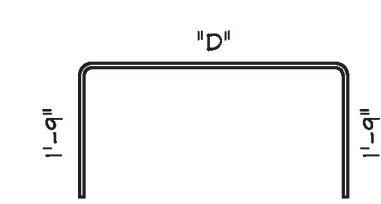


#4 STIRRUP
STAINLESS STEEL
USE 2# PIN


MARK	QTY.	A DIM.	B DIM.
WD4063S	12	5'-8 3/4"	3'-7 3/8"
WD4064S	1	5'-2 5/8"	3'-7 3/4"
WD4065S	1	4'-8 1/2"	3'-5 7/8"
WD4066S	1	4'-2 1/4"	3'-4 1/4"
WD4067S	1	3'-8 1/4"	3'-2 5/8"
WD4068S	1	3'-2"	3'-1 1/4"
WD4069S	1	2'-8"	3'-0"
WD4070S	1	2'-1 3/4"	2'-11"
WD4071S	1	1'-7 5/8"	2'-10 1/4"
WD4072S	1	1'-1 1/2"	2'-9 3/4"
WD4073S	1	7 3/8"	3'-5 1/2"
WD4074S	1	4 1/8"	3'-3 3/4"
WD4075S	1	8"	3'-2 1/4"
WD4076S	1	12"	3'-0 7/8"
WD4077S	1	1'-3 3/4"	2'-11 3/4"
WD4078S	1	1'-7 3/4"	2'-10 3/4"
WD4079S	1	1'-11 1/2"	2'-10 1/8"
WD4080S	1	2'-3 1/2"	2'-9 3/4"
WD4081S	1	2'-7 3/8"	5'-3"
WD4082S	1	2'-11 1/4"	3'-8 3/4"
WD4083S	1	3'-3 1/8"	3'-10 7/8"
WD4084S	1	3'-7"	4'-1"
WD4085S	1	3'-10 7/8"	4'-3 1/4"
WD4086S	1	4'-2 3/4"	4'-5 1/4"
WD4087S	1	4'-2 3/4"	4'-5 1/4"
WD4088S	1	5'-4"	
WD4089S	1	5'-6 3/8"	
WD4090S	1	5'-8 3/4"	
WD4091S	1	5'-11 1/8"	
WD4092S	1	6'-1 5/8"	
WD4093S	1	6'-4 1/8"	
WD4094S	1	6'-6 5/8"	
WD4095S	25	5'-6 3/4"	
WD4100S	1	3'-7 5/8"	
WD4111S	1	3'-8 1/8"	
WD4112S	1	3'-9"	
WD4113S	1	3'-10 1/4"	
WD4114S	1	3'-11 3/4"	
WD4115S	1	4'-1 3/8"	
WD4116S	1	4'-3 3/8"	
WD4117S	1	4'-5 1/2"	
WD4118S	1	4'-8"	
WD4119S	1	4'-10 1/2"	
WD4120S	1	5'-1 1/8"	
WD4121S	1	5'-3 7/8"	

MARK	QTY.	C DIM.
WD4060S	48	3'-7 1/4"
WD4061S	25	6'-9 1/4"
WD4062S	1	6'-7 1/4"
WD4074S	1	3'-7 1/2"
WD4075S	1	3'-7 7/8"
WD4076S	1	3'-8 1/2"
WD4077S	1	3'-9 1/4"
WD4078S	1	3'-10 1/4"
WD4079S	1	3'-11 1/2"
WD4080S	1	4'-0 7/8"
WD4081S	1	4'-2 3/8"
WD4082S	1	4'-4"
WD4083S	1	4'-5 3/4"
WD4084S	1	4'-7 5/8"
WD4085S	1	4'-9 5/8"
WD4086S	1	4'-11 3/4"
WD4087S	1	5'-1 3/4"
WD4088S	1	5'-4"
WD4089S	1	5'-6 3/8"
WD4090S	1	5'-8 3/4"
WD4091S	1	5'-11 1/8"
WD4092S	1	6'-1 5/8"
WD4093S	1	6'-4 1/8"
WD4094S	1	6'-6 5/8"
WD4108S	1	3'-7 5/8"
WD4111S	1	3'-8 1/8"
WD4112S	1	3'-9"
WD4113S	1	3'-10 1/4"
WD4114S	1	3'-11 3/4"
WD4115S	1	4'-1 3/8"
WD4116S	1	4'-3 3/8"
WD4117S	1	4'-5 1/2"
WD4118S	1	4'-8"
WD4119S	1	4'-10 1/2"
WD4120S	1	5'-1 1/8"
WD4121S	1	5'-3 7/8"


MARK	QTY.	D DIM.
WD4122S	35	3'-7 1/4"
WD4123S	1	6'-9 1/4"
WD4124S	1	6'-4 1/4"
WD4125S	1	5'-11 3/8"
WD4126S	1	5'-6 3/4"
WD4127S	1	5'-2 1/4"
WD4128S	1	4'-10"
WD4129S	1	4'-6 1/4"
WD4130S	1	4'-2 7/8"
WD4131S	1	4'-0"
WD4132S	1	3'-9 3/4"
WD4133S	1	3'-8 1/8"
WD4134S	1	3'-7 3/8"
WD4135S	1	3'-8 1/8"
WD4136S	1	3'-9 5/8"
WD4137S	1	3'-11 7/8"
WD4138S	1	4'-2 3/4"
WD4140S	1	4'-10"
WD4141S	1	5'-2 1/8"
WD4142S	1	5'-6 1/2"

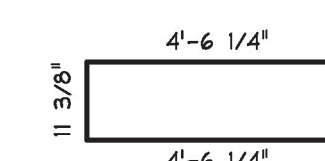


WD4096S
#4 BENT BAR
STAINLESS STEEL
USE 2# PIN
(47) REQ'D.

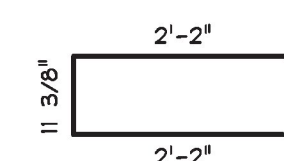

WD501S
#5 BENT BAR
STAINLESS STEEL
USE 2 1/2# PIN
(14) REQ'D.

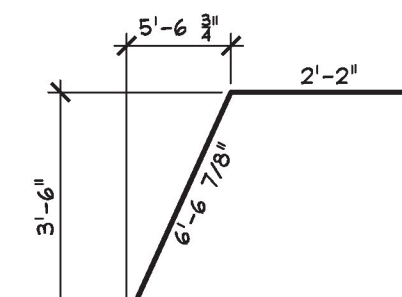

WD506S
#5 BENT BAR
STAINLESS STEEL
USE 2 1/2# PIN
(3) REQ'D.

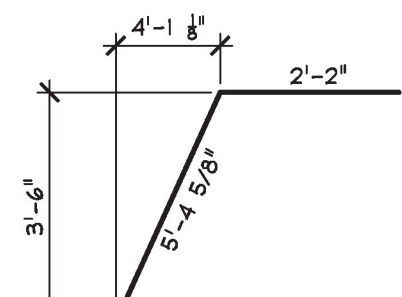

WD509S
#5 BENT BAR
STAINLESS STEEL
USE 2 1/2# PIN
(3) REQ'D.

MISCELLANEOUS MATERIALS			PIER CAP	
ITEM	MARK	QTY.	DESCRIPTION	REMARKS
1		6	1 1/2" O.D. x 1'-3" STEEL SLEEVE	
2		17	1/2" x 4" B-16 COIL LOOP INSERT (GALV.)	
3		4	#5 x 3'-8" (STAINLESS STEEL)	
4		2	#5 x 6'-9" (STAINLESS STEEL)	
5		2	#5 x 5'-7" (STAINLESS STEEL)	
6		4	(2) 1/2" 270 KSI STRAND LIFT LOOPS	SEE DETAIL

Production/Record Set
2.13.18
J.P. CARRARA & SONS, INC.
MIDDLEBURY, VT 05753

2-12-18 REVISED AS PER ENGINEERS COMM. T.D.

Vermont Agency of Transportation
RECEIVED

CK'D BY Stephen Coley OK'D BY Rob Young

February 13, 2017

RESUBMIT No Approved
BY Rob Young DATE 02/13/2017

APPROVAL STAMP:	J.P. CARRARA & SONS INC. Precast & Prestress Manufacturer 2464 CASE ST., MIDDLEBURY, VERMONT 05753 Phone:(802)388-6361 Fax:(802)388-9010		Cold River Bridges CONTRACTOR WALPOLE, NEW HAMPSHIRE
	STATE OF VERMONT AGENCY OF TRANSPORTATION COUNTY OF WINDSOR		DATE: JAN. 18, 2018 SCALE: NOTED
	WOODSTOCK VILLAGE VT. ROUTE 4 (CLASS 1), VILLAGE PRINCIPAL ARTERIAL BRIDGE NO.: 51 PROJECT NO.: BF 020-2 (43)		CHKD: A.S. DFTM: T.D. JOB NO: 23522-017
	MATERIAL LIST		DWG. NO: M2