


4" DIA SLEEVES WILL BE LAYED OUT USING THE FOLLOWING PROCEDURE

1. DURING PRE-CAST CONSTRUCTION SLEEVES WILL BE LAID OUT FROM THE MARKET CONTROL POINT.
2. APPROACH SLABS WILL BE PRE-ASSEMBLED IN YARD
3. DIMENSION WILL BE VERIFIED.
4. SURVEY WILL BE USED TO LAY OUT CONTROL POINTS IN FIELD TO LOCATE DOWELS IN THE FIELD

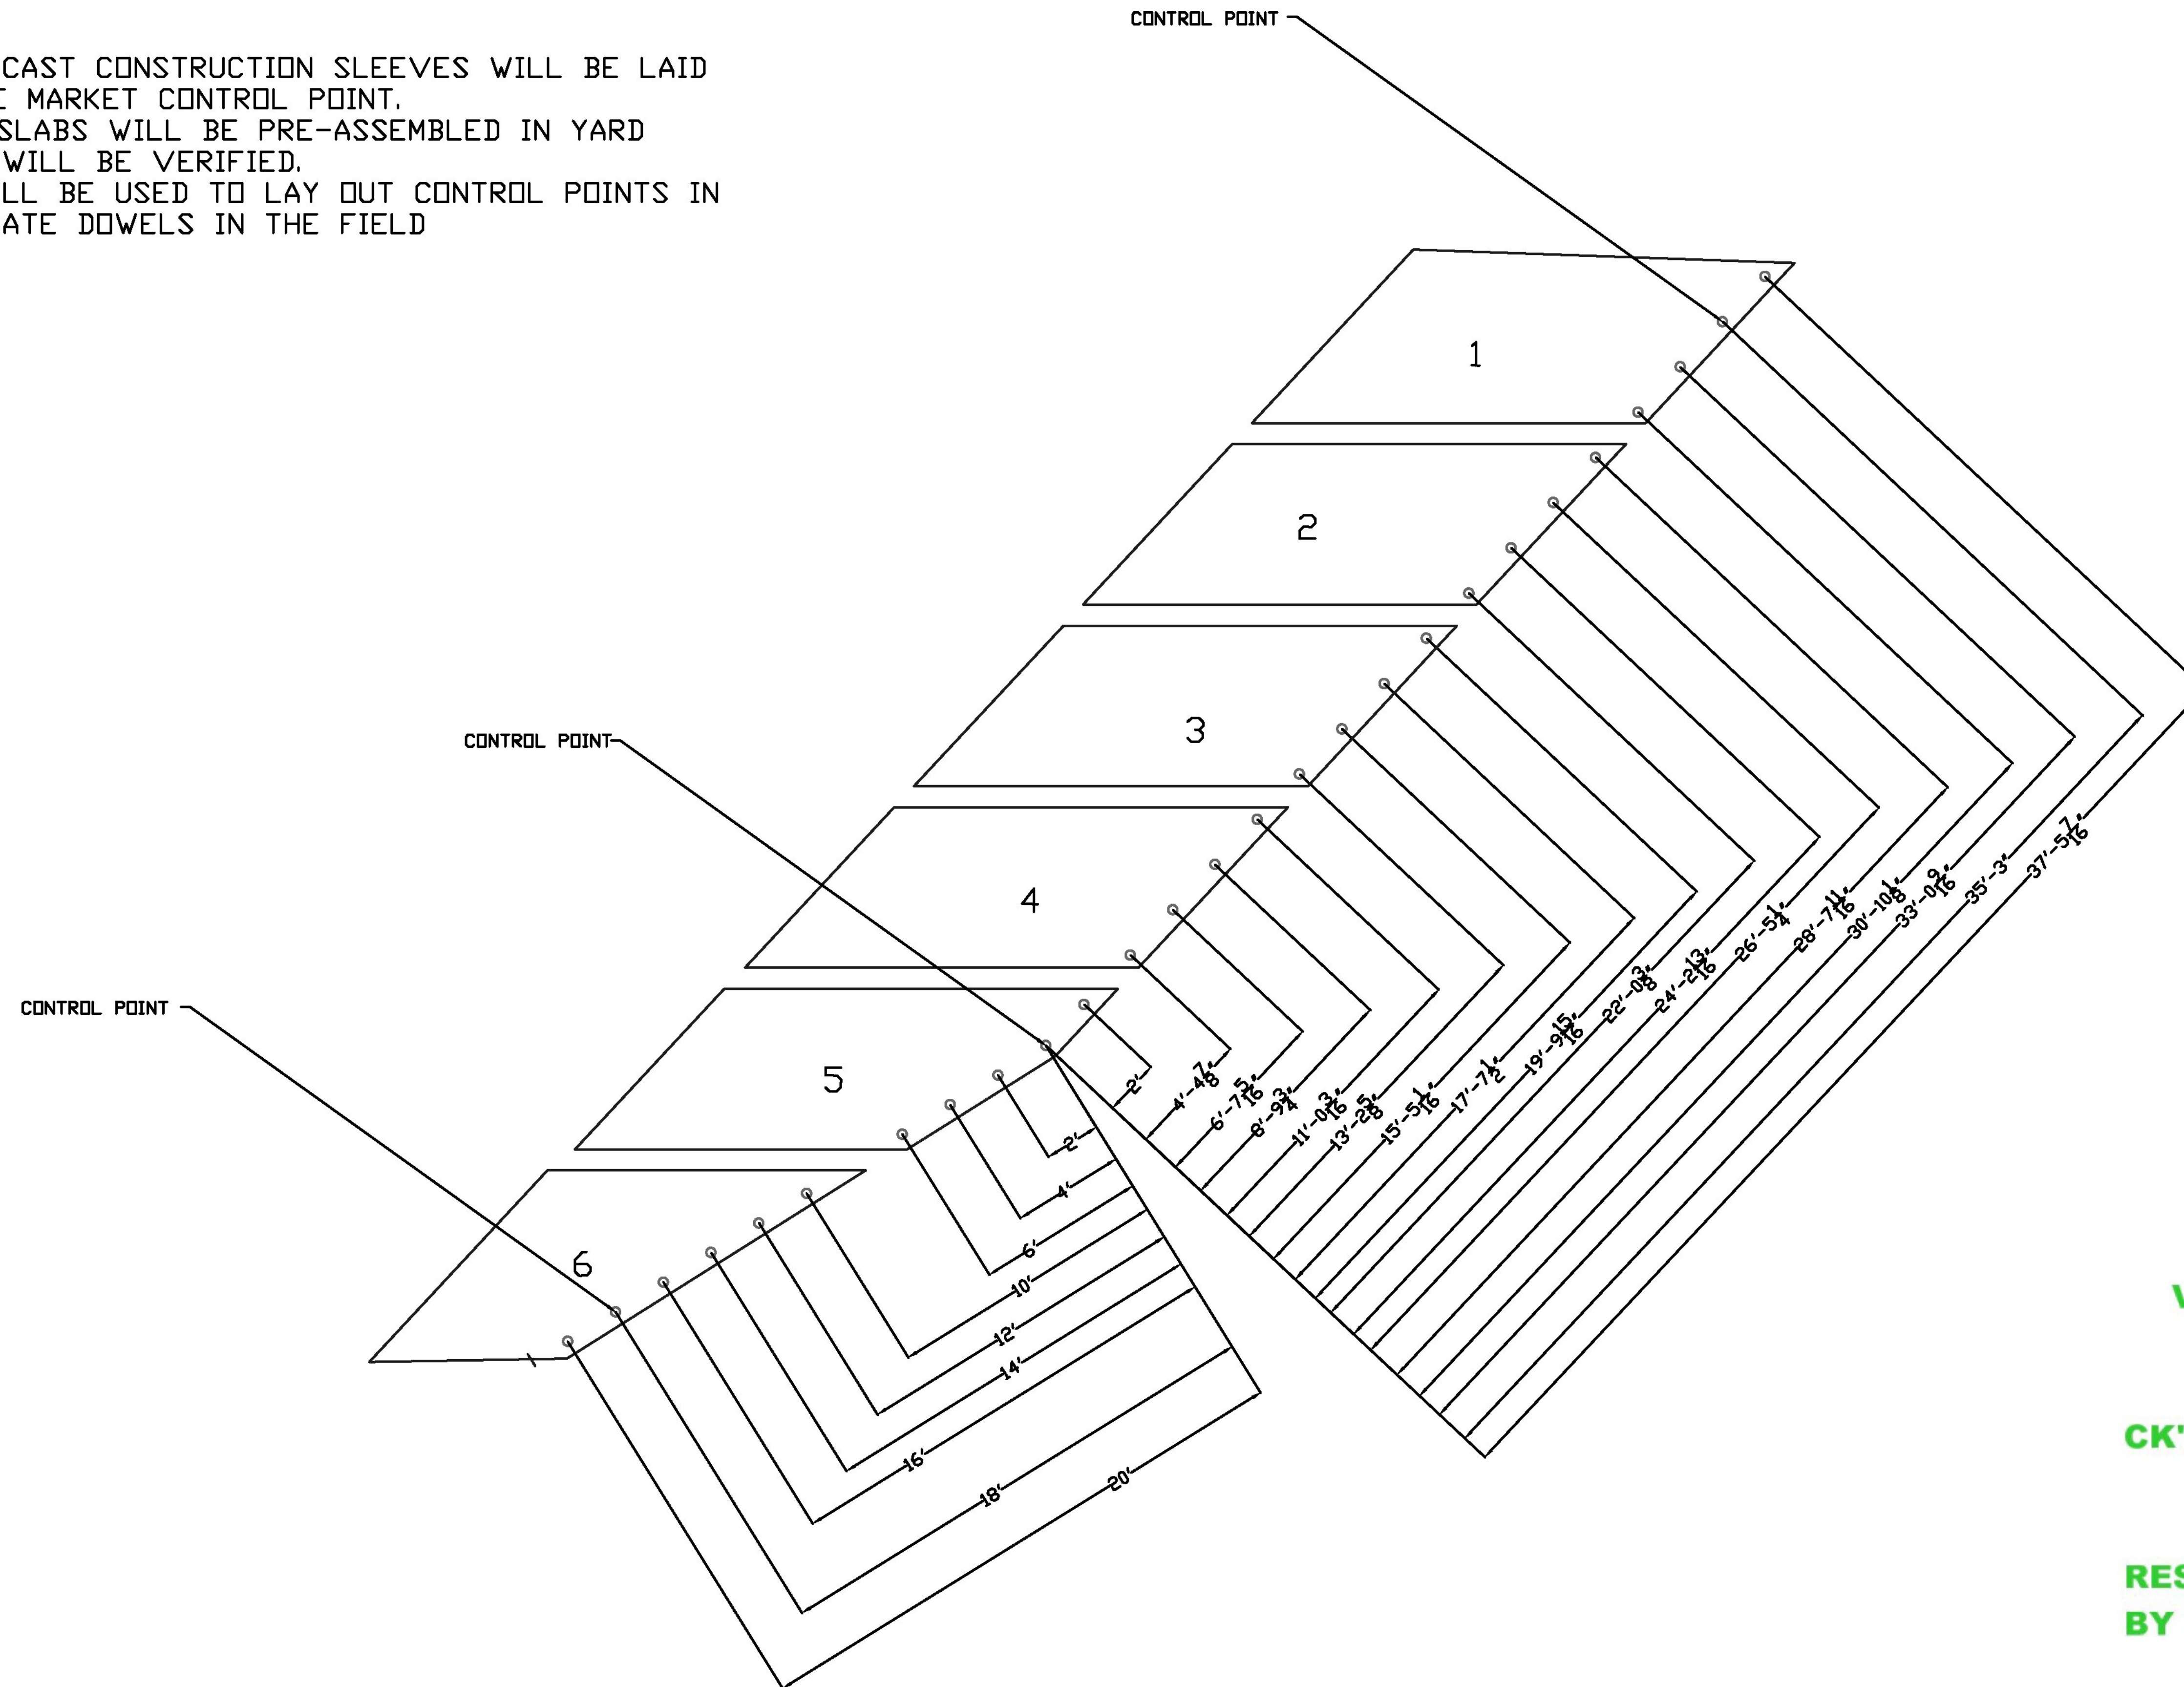

Vermont Agency of Transportation
RECEIVED

CK'D BY Stephen Coley OK'D BY Rob Young

January 26, 2018

RESUBMIT No **Approved**
 BY Rob Young **DATE** 02-06-2018

COLD RIVER BRIDGES, LLC 10 LANBRO LANE WALPOLE, NH TEL 603-756-9800 FAX 603-756-9803	
PRE-CAST APPROACH SLABS WOODSTOCK VILLAGE BF 020-2 (43)	
ABUT 1-SLEAVES REVISION #1 1/26/18	SHEET NUMBER 6
DATE: 12/22/17	