


4" DIA SLEEVES WILL BE LAYED OUT USING THE FOLLOWING PROCEDURE

1. DURING PRE-CAST CONSTRUCTION SLEEVES WILL BE LAID OUT FROM THE MARKET CONTROL POINT.
2. APPROACH SLABS WILL BE PRE-ASSEMBLED IN YARD
3. DIMENSION WILL BE VERIFIED.
4. SURVEY WILL BE USED TO LAY OUT CONTROL POINTS IN FIELD TO LOCATE DOWELS IN THE FIELD

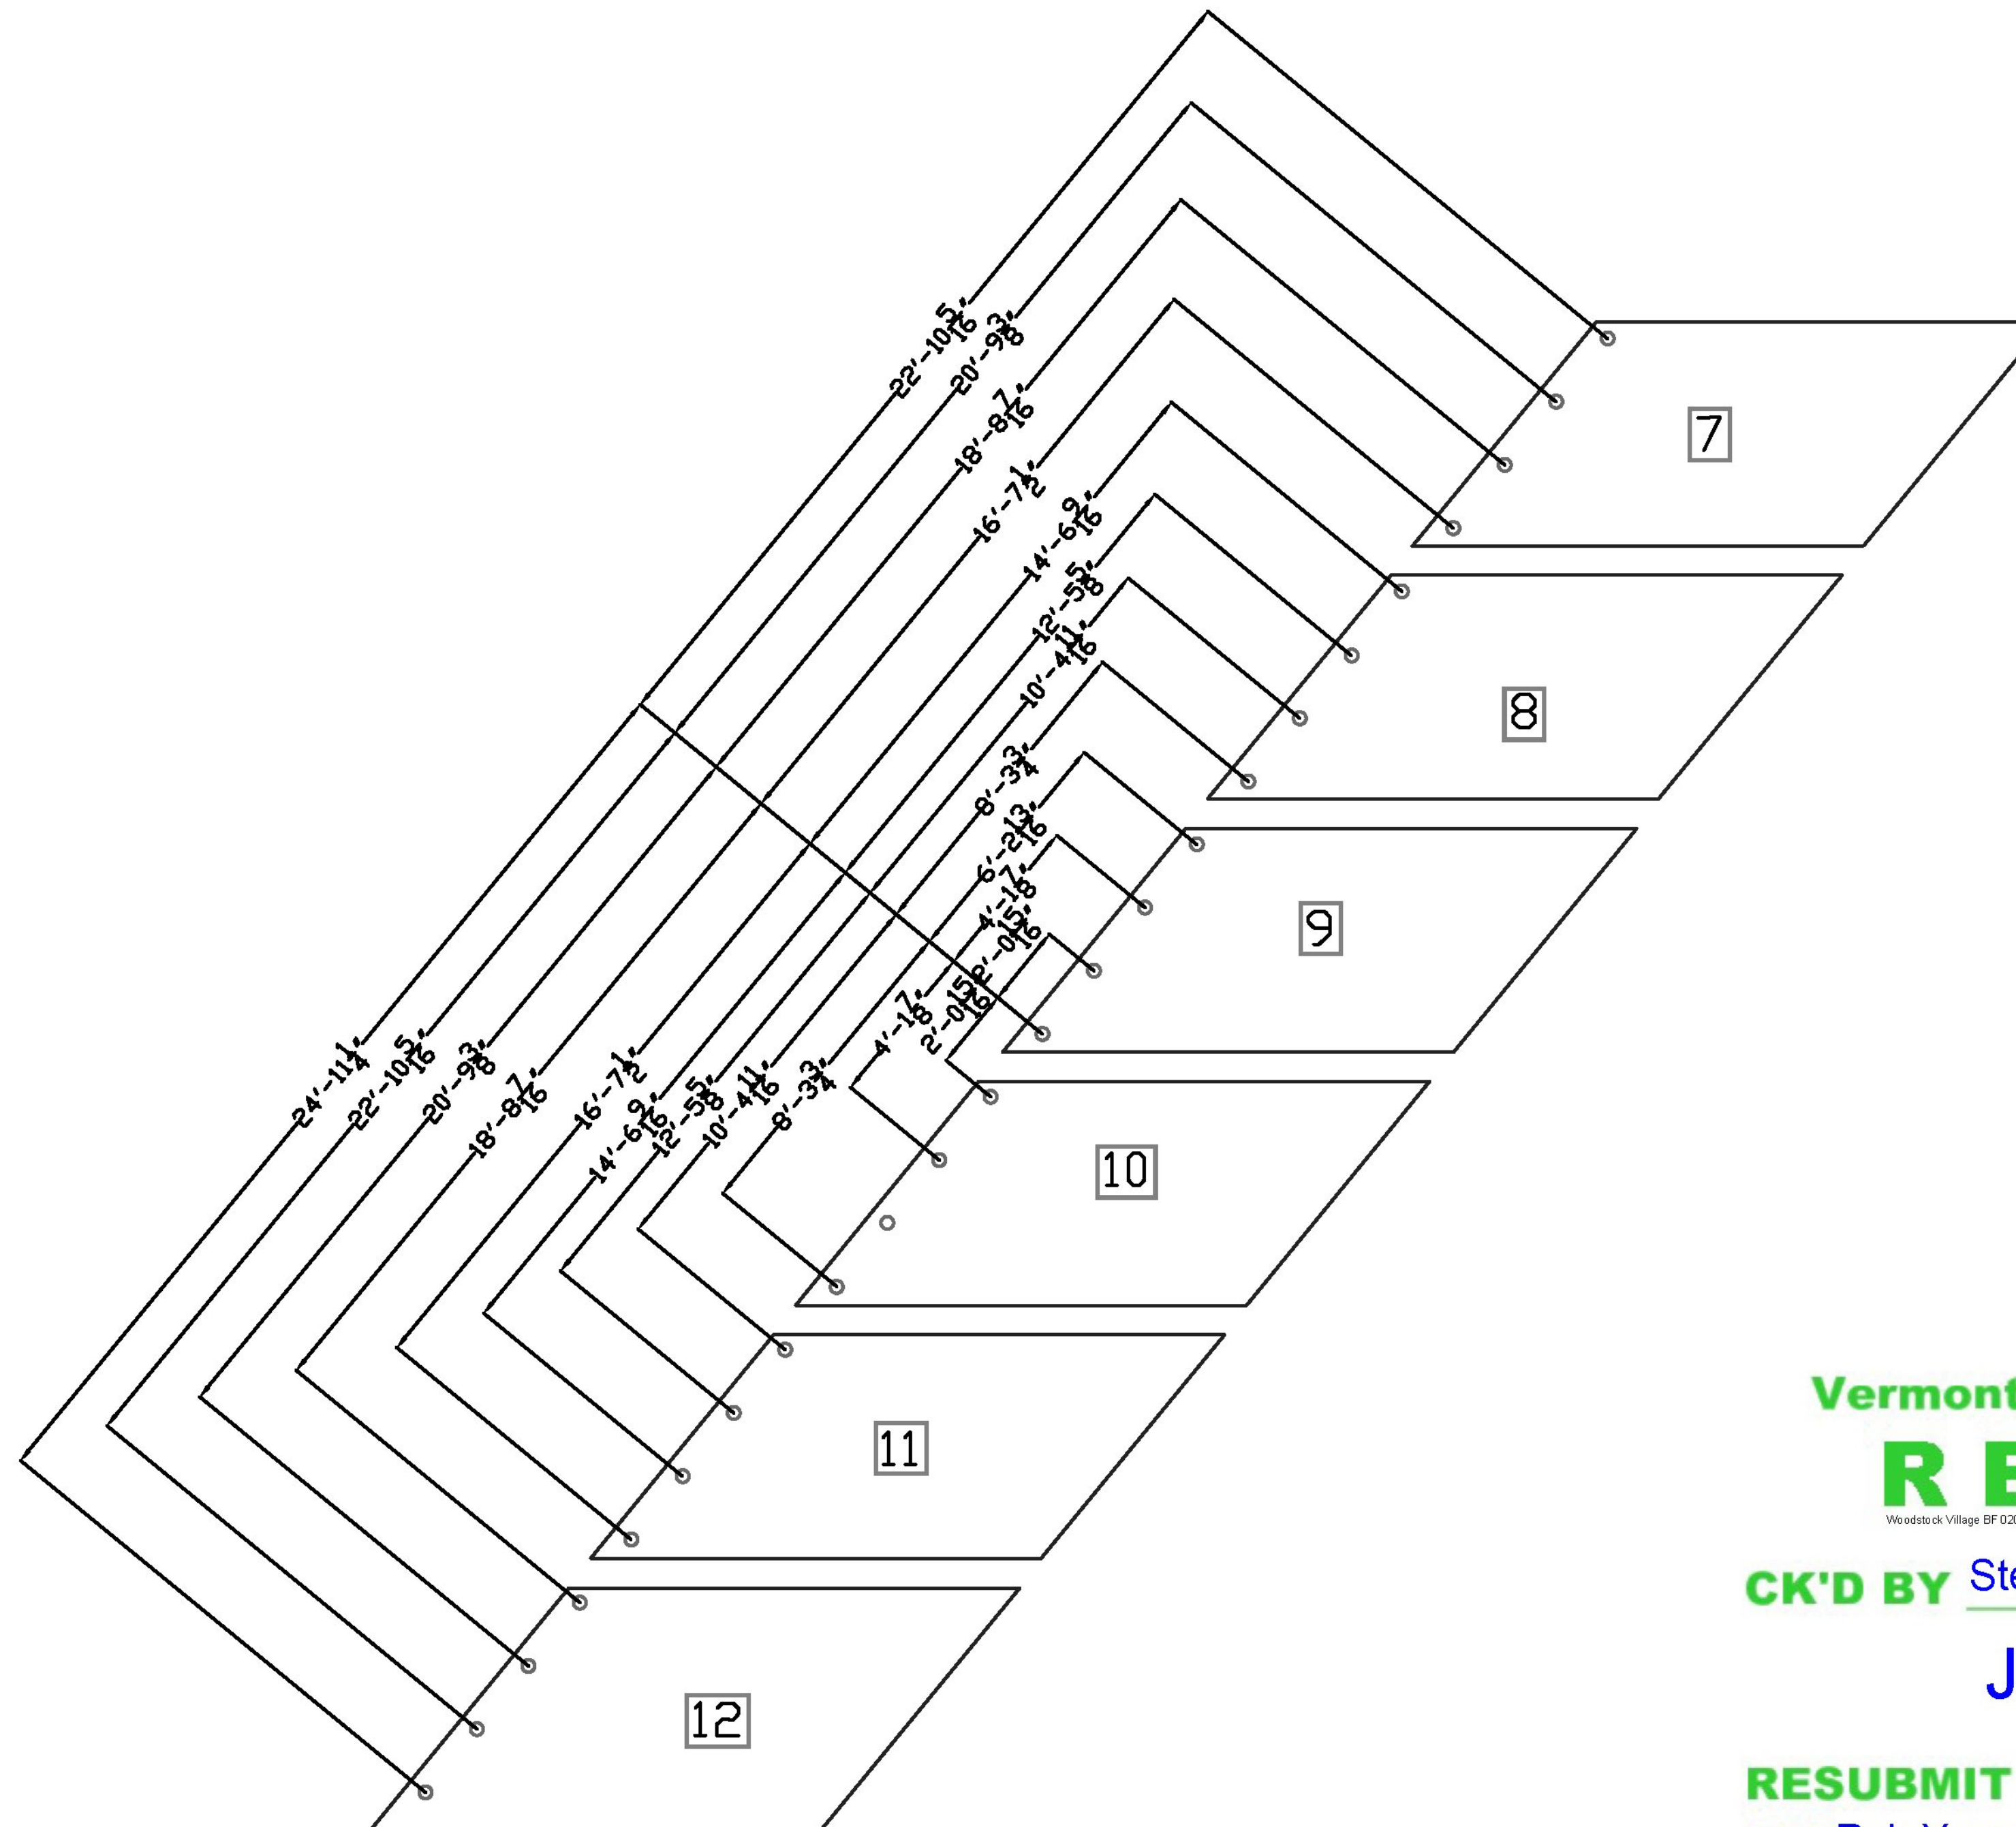

Vermont Agency of Transportation  
**RECEIVED**

CK'D BY Stephen Coley OK'D BY Rob Young

January 26, 2018

RESUBMIT No **Approved**  
 BY Rob Young DATE 02-06-2018

COLD RIVER BRIDGES, LLC	
10 LANBRO LANE	
TEL 603-756-9800	WALPOLE, NH FAX 603-756-9803
PRE-CAST APPROACH SLABS	
WOODSTOCK VILLAGE BF 020-2 (43)	
ABUT 2-SLEAVES	SHEET NUMBER
REVISION #1 1/26/18	7
DATE: 12/22/17	