


ALL REINF. STAINLESS STEEL

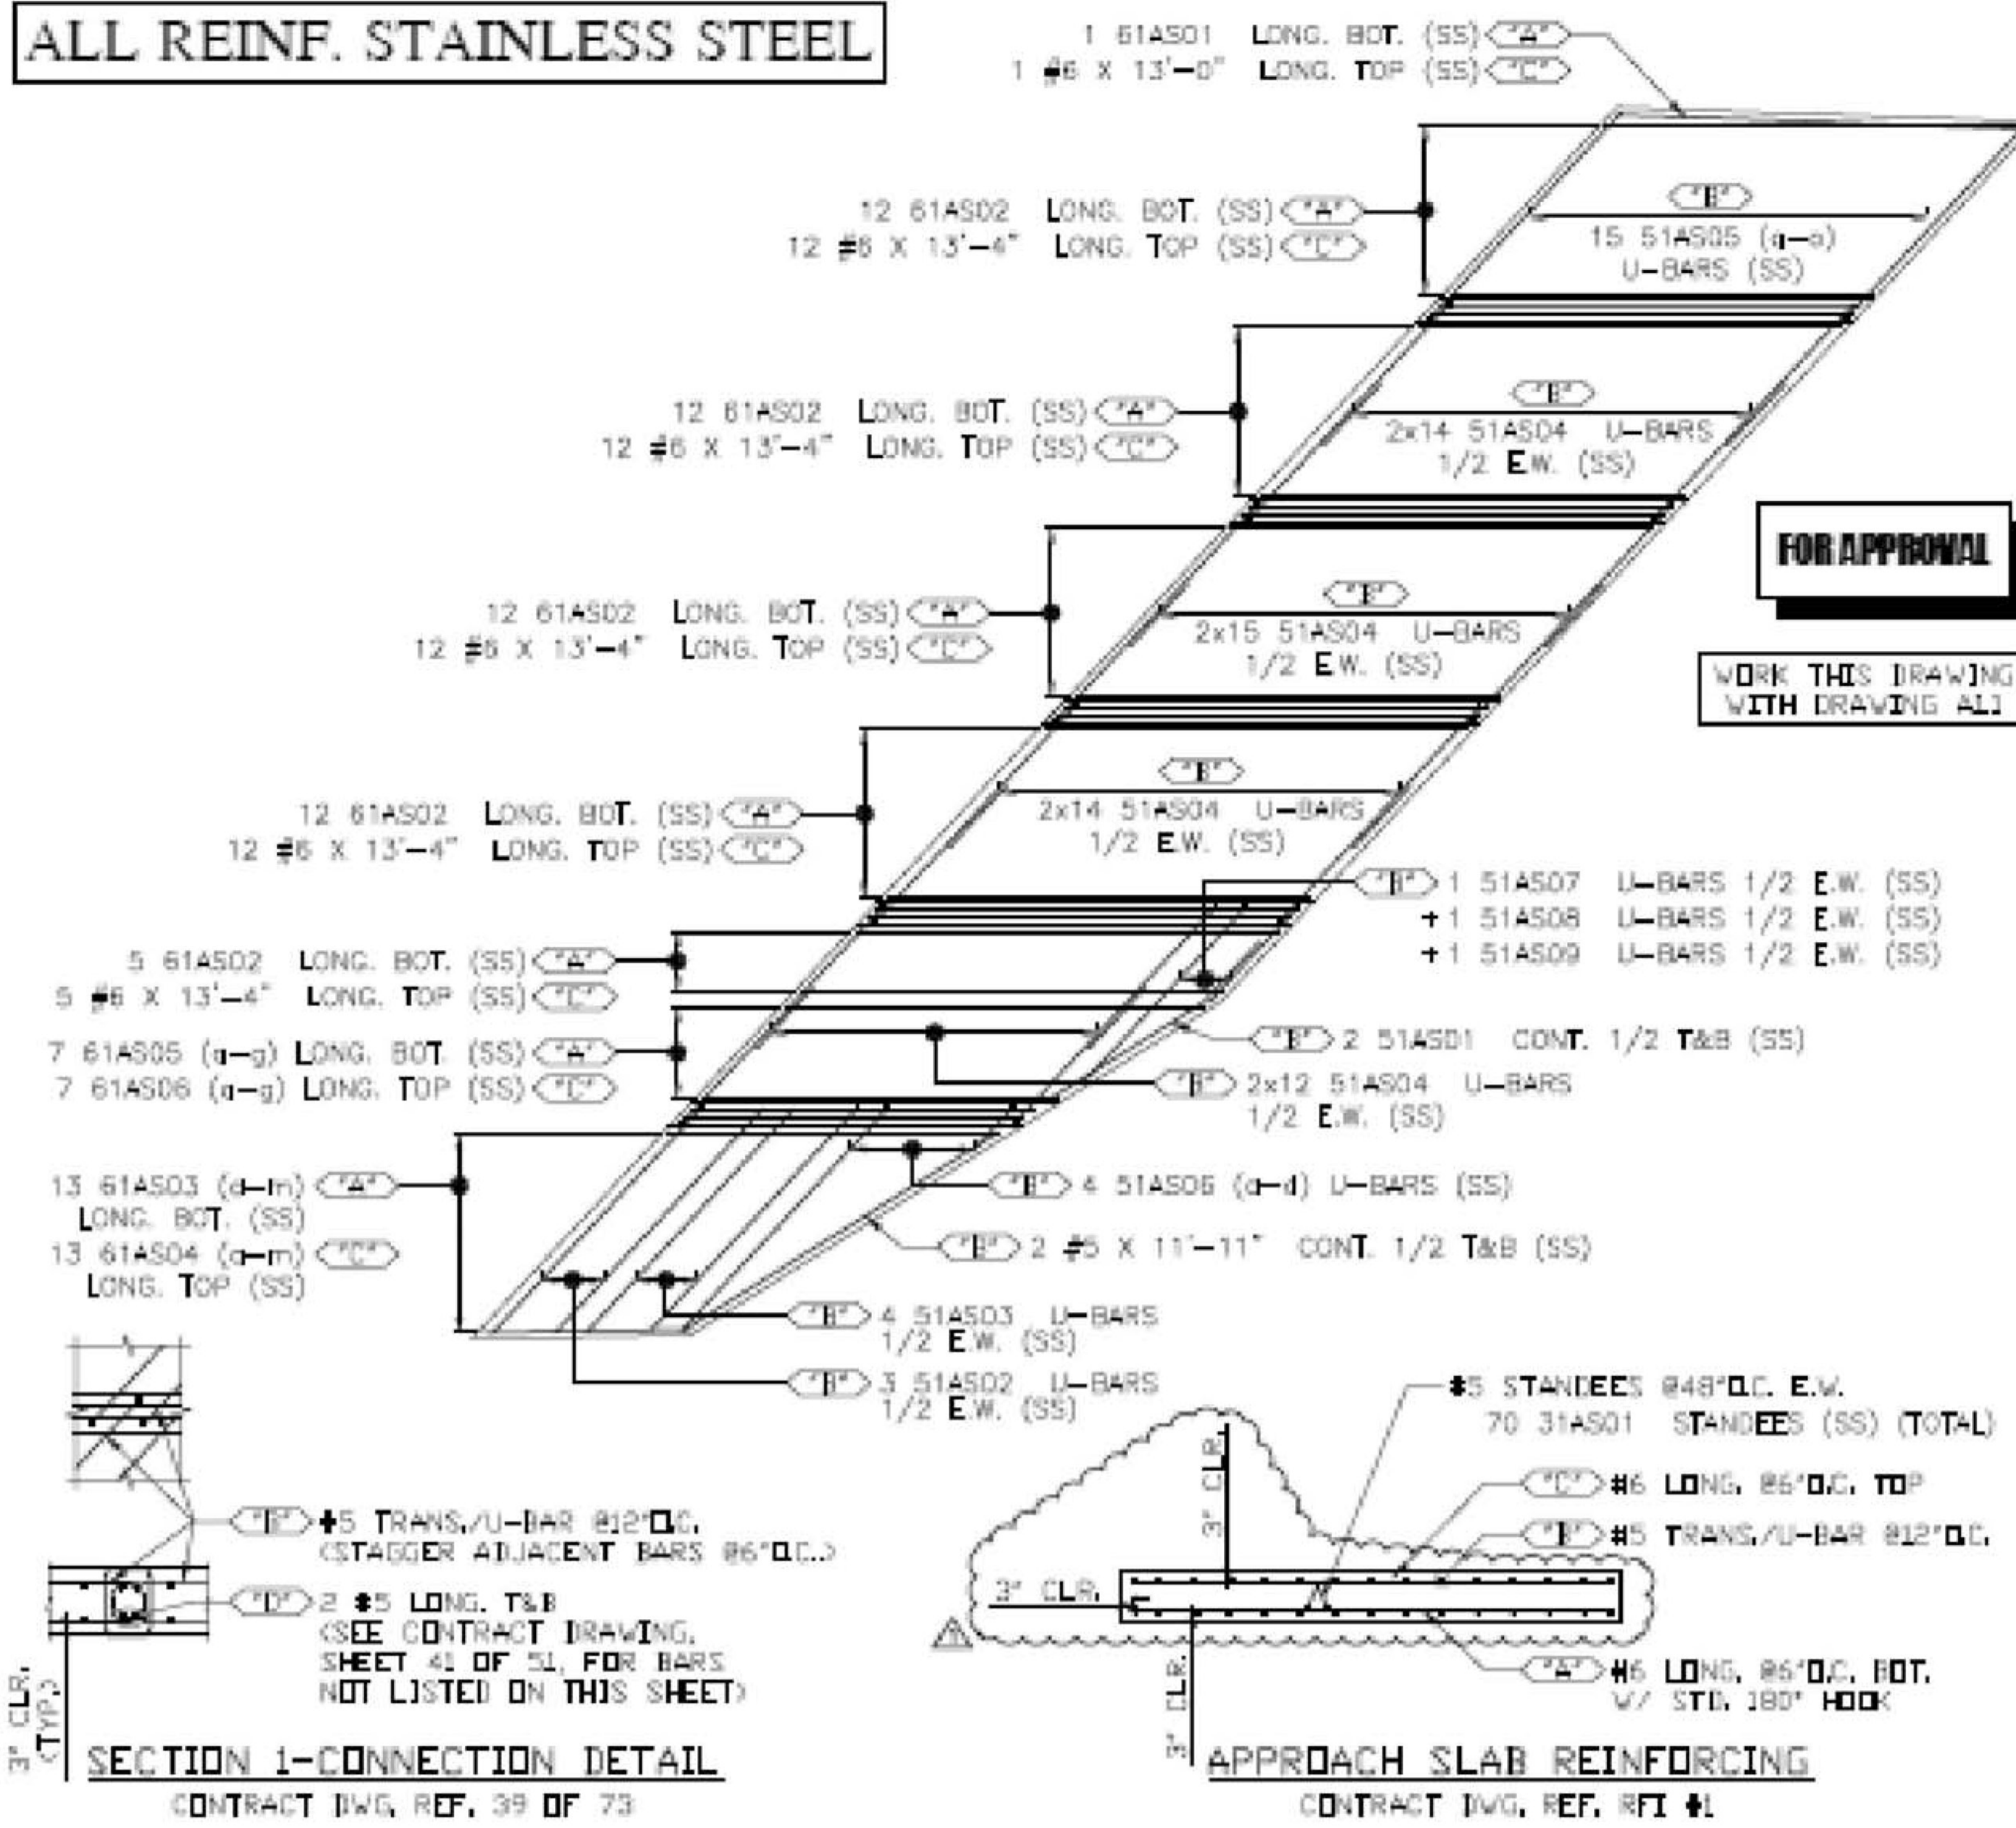

LEGEND:

CONT.-CONTINUOUS	E.E.-EACH END
TRANS.-TRANSVERSE	E.F.-EACH FACE
DWLS.-DOWELS	F.F.-FRONT FACE
VERTS.-VERTICAL	R.F.-REAR FACE
HORIZ.-HORIZONTAL	E.W.-EACH WAY
T&B -TOP & BOTTOM	O.C.-ON CENTER
IF.-INNER FACE	L.W.-LONG WAY
OF.-OUTER FACE	S.W.-SHORT WAY

ELEVATIONS & DIMENSIONS SHOWN ON THIS DWG. ARE FOR REINF. DETAILING PURPOSES ONLY AND ARE NOT INTENDED FOR DIMENSIONAL CONSTRUCTION.

REINF. BARS ASTM A615 GRADE 60

VERIFICATION OF UNCLEAR INFORMATION MAY BE REQUESTED ON THIS DRAWING. SHOULD VERIFICATION BE LEFT UN-ADDRESSED IT WILL REMAIN AS SHOWN AND ASSUME TO BE CORRECT.

NO.	DATE	REV.#	REV'D FOR
2	1/16/18	▲	REVIEWED AS NOTED/FOR APPROVAL
1	12/5/17	-	FOR APPROVAL

DIMENSION
DIMENSION FABRICATORS INC.
2000 7th Street
SOUTH, N.E. 13000
PH: (308) 274-8100
FAX: (308) 274-8100
www.DimensionFabricators.com

PROJECT	VTACT WOODSTOCK BF 020-2(43)		
LOCATION	US RTE 4 (CENTRAL AVE) OVER MEDRON BROOK WOODSTOCK, VT		
ARCHIT	VHB		
OWNER	COLD RIVER BRIDGES, LLC		
DRAWN BY	DATE	CHK BY	
SDB	12/4/17	10551	
DRAWING TITLE		DRAWING NO.	
APPROACH NO. 1		A1	

Vermont Agency of Transportation
RECEIVED

CK'D BY Stephen Coley OK'D BY Rob Young
January 26, 2018

RESUBMIT No Approved
BY Rob Young DATE 02-06-2018

COLD RIVER BRIDGES, LLC
10 LANBRO LANE
WALPOLE, NH FAX 603-756-9303
TEL 603-756-9300

PRE-CAST APPROACH SLABS
WOODSTOCK VILLAGE BF 020-2 (43)

REINFORCING STEEL APP SLAB # 1	SHEET NUMBER
REVISION #1 1/26/18	11
DATE: 12/22/17	