

Rebar Number:				BAR LIST												
Bar No.	Qty	Size	Total Length	Type	X	Y	Z	W	E	F	V	H	Y	K	W	W
△ S14301	20	#1	4'-5"	25			1'-0"	0'-8 1/2"	1'-0"	0'-8 1/2"	1'-0"	0'-8 1/2"		0'-4 1/2"		
△ S14301	3	#1	8'-9 1/2"	3			8'-2"	2'-7 1/2"				0'-8 1/2"		2'-6 1/2"	8'-8 1/2"	
△ S14302	3	#1	20'-7 1/2"	17			8'-10"	0'-11 1/2"	8'-10"							
△ S14303	4	#1	20'-5 1/2"	17			8'-9"	0'-11 1/2"	8'-9"							
△ S14304	170	#1	13'-5 1/2"	17			8'-3"	0'-11 1/2"	8'-3"							
△ S14305a	1	#1	17'-8 1/2"	17			8'-4 1/2"	0'-11 1/2"	8'-4 1/2"							
Notes To																
△ S14305a	1	#1	18'-10 1/2"	17			8'-11 1/2"	0'-11 1/2"	8'-11 1/2"							
△ S14305b	1	#1	4'-2 1/2"	17			1'-8"	0'-11 1/2"	1'-8"							
Notes To																
△ S14305d	1	#1	16'-9 1/2"	17			7'-11"	0'-11 1/2"	7'-11"							
△ S14301	1	#1	13'-8"	1			0'-8"	13'-0"					0'-6"			
△ S14302	53	#1	14'-0"	1			0'-8"	13'-4"					0'-6"			
△ S14303a	1	#1	7'-1"	1			0'-8"	8'-5"					0'-6"			
Notes To																
△ S14303b	1	#1	11'-0"	1			0'-8"	10'-4"					0'-6"			
△ S14304a	1	#1	8'-5"				8'-5"									
Notes To																
△ S14304b	1	#1	10'-4"				10'-4"									
△ S14305a	1	#1	11'-9"	1			0'-8"	11'-1"					0'-6"			
Notes To																
△ S14305b	1	#1	13'-8"	1			0'-8"	13'-0"					0'-6"			
△ S14305c	1	#1	11'-1"				11'-1"									
Notes To																
△ S14305d	1	#1	13'-0"				13'-0"									


LEGEND:

CONT.-CONTINUOUS	EE-EACH END
TRANS.-TRANSVERSE	E.F.-EACH FACE
DWLS.-DOWELS	F.F.-FRONT FACE
VERTS.-VERTICAL	R.F.-REAR FACE
HORIZ.-HORIZONTAL	E.W.-EACH WAY
T&B -TOP & BOTTOM	O.C.-ON CENTER
IF.-INNER FACE	L.W.-LONG WAY
OF.-OUTER FACE	S.W.-SHORT WAY

ELEVATIONS & DIMENSIONS SHOWN ON THIS DWG. ARE FOR REINF. DETAILING PURPOSES ONLY AND ARE NOT INTENDED FOR DIMENSIONAL CONSTRUCTION.

REINF. BARS ASTM A615 GRADE 60

VERIFICATION OF UNCLEAR INFORMATION MAY BE REQUESTED ON THIS DRAWING. SHOULD VERIFICATION BE LEFT UN-ADDRESSED IT WILL REMAIN AS SHOWN AND ASSUME TO BE CORRECT.

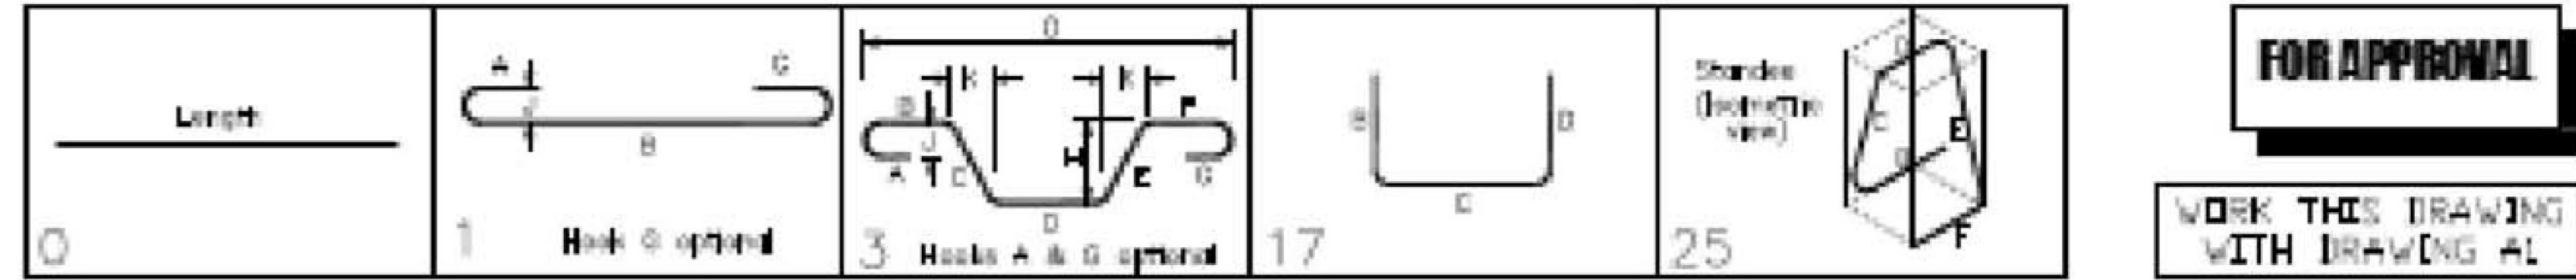

ALL REINF. STAINLESS STEEL

Vermont Agency of Transportation
RECEIVED
 CK'D BY Stephen Coley OK'D BY Rob Young
 January 26, 2018
 RESUBMIT No Approved
 BY Rob Young DATE 02-06-2018

6			
5			
4			
3			
2	1/18/18	△	REVISED AS NOTED/FOR APPROVAL
1	12/5/17	-	FOR APPROVAL
	DATE	REV#	SENT FOR
DIMENSION DIMENSION FABRICATORS INC. 2000 YORK STREET SOUTH, N.E. 15000 WA. 10100 204-4000 MO. (314) 204-4800 www.dimensionfabricators.com			
STRUCTURE	VTADT WOODSTOCK BF 020-2(43)		
LOCATION	US RTE 4 (CENTRAL AVE) OVER KEDRON BROOK WOODSTOCK, VT		
ARCHIT			
ENGINEER	VHB		
OWNER	COLD RIVER BRIDGES, LLC		
DRAWN BY	DATE	CR #	
SDB	12/4/17	10551	
DRAWING CODE		DRAWING #	
APPROACH NO. 1		A1.1	

COLD RIVER BRIDGES, LLC	
10 LANBRO LANE WALPOLE, NH FAX 603-756-9803	
PRE-CAST APPROACH SLABS	
WOODSTOCK VILLAGE BF 020-2 (43)	
REINFORCING STEEL APP SLAB # 1	SHEET NUMBER
SCHEDULE	12
REVISION #1 1/26/18	
DATE: 12/22/17	