


Release Number:		BAR LIST														
Bar Mark	Qty	Size	Total Length	Type	'A'	'B'	'C'	'D'	'E'	'F'	'G'	'H'	'J'	'K'	'O'	'R'
▲ 32AS01	55	#3	4'-5"	25		1'-0"	8 ½"	1'-0"	8 ½"	1'-0"		8 ½"		4 ½"		
▲ 52AS01	14	#5	18'-1 ½"	17		8'-7"	11 ½"	8'-7"								
▲ 52AS02	100	#5	12'-9 ½"	17		5'-11"	11 ½"	5'-11"								
▲ 52AS03	13	#5	16'-9 ½"	17		7'-11"	11 ½"	7'-11"								
▲ 62AS01	73	#6	11'-6"	1	8"	10'-10"							6"			

**LEGEND:**

CONT.-CONTINUOUS	E.E.-EACH END
TRANS.-TRANSVERSE	E.F.-EACH FACE
DWLS.-DOWELS	F.F.-FRONT FACE
VERTS.-VERTICAL	R.F.-REAR FACE
HORIZ.-HORIZONTAL	E.W.-EACH WAY
T&B -TOP & BOTTOM	O.C.-ON CENTER
I.F.-INNER FACE	L.W.-LONG WAY
O.F.-OUTER FACE	S.W.-SHORT WAY

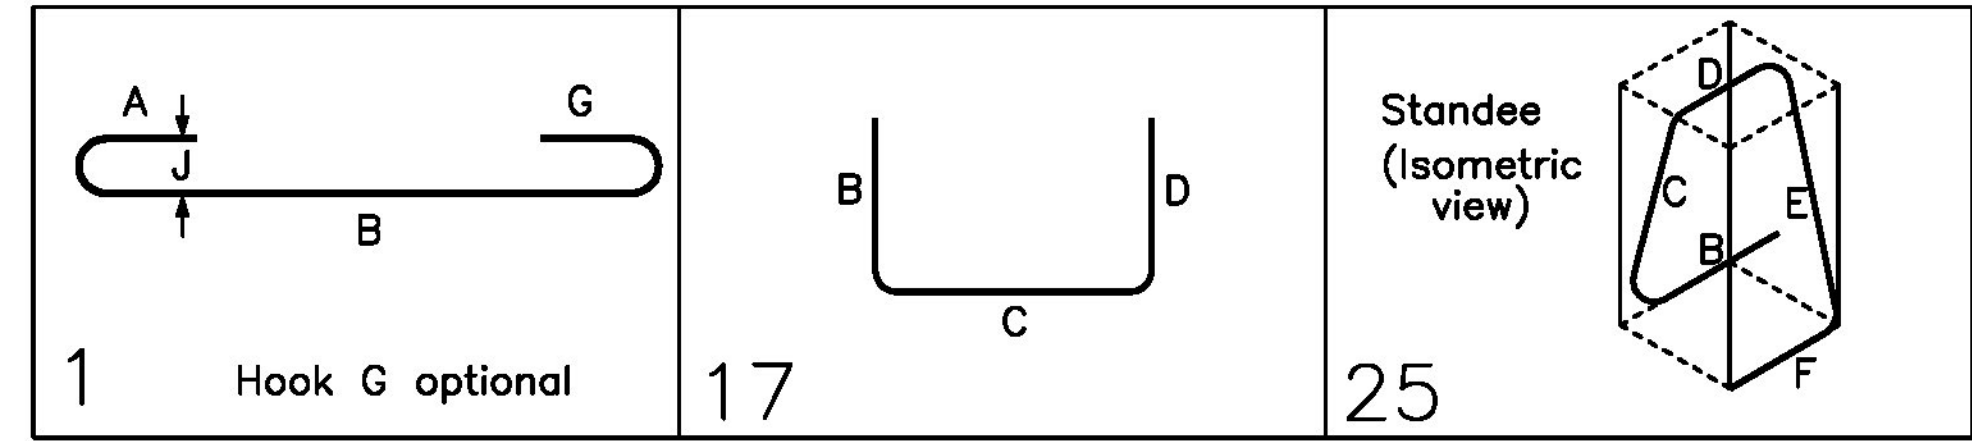

**FOR APPROVAL**

WORK THIS DRAWING WITH DRAWING A2

ELEVATIONS & DIMENSIONS SHOWN ON THIS DWG. ARE FOR REINF. DETAILING PURPOSES ONLY AND ARE NOT INTENDED FOR DIMENSIONAL CONSTRUCTION.

**ALL REINF. STAINLESS STEEL**

STAINLESS STEEL REINF. BARS ASTM A955 GRADE 60, MARKED (.3)

VERIFICATION OF UNCLEAR INFORMATION MAY BE REQUESTED ON THIS DRAWING. SHOULD VERIFICATION BE LEFT UN-ADDRESSED IT WILL REMAIN AS SHOWN AND ASSUME TO BE CORRECT.

6			
5			
4			
3			
2	1/16/18	▲	REVISED AS NOTED/FOR APPROVAL
1	12/5/17	-	FOR APPROVAL
	DATE	REV.#	SENT FOR

**DIMENSION**  
 DIMENSION FABRICATORS INC. [www.dimensionfabricators.com](http://www.dimensionfabricators.com)  
 2000 7TH STREET  
 SCOTIA, N.Y. 12302  
 PH: (518) 374-1936  
 FAX (518) 374-4830

Vermont Agency of Transportation  
**RECEIVED**  
Woodstock Village BP 020-43 contractor fabricated approach slab resubmit 1-26-18.pdf  
 CK'D BY Stephen Coley OK'D BY Rob Young  
 January 26, 2018  
 RESUBMIT No Approved  
 BY Rob Young DATE 02-06-2018

STRUCTURE	VTAOT WOODSTOCK BF 020-2(43)	
LOCATION	US RTE 4 (CENTRAL AVE) OVER KEDRON BROOK WOODSTOCK, VT	
ARCHITECT		
ENGINEER	VHB	
CUSTOMER	COLD RIVER BRIDGES, LLC	
DRAWN BY	DATE	DPI #
SDB	12/4/17	10551
DRAWING COVERS		DRAWING #
APPROACH NO. 2		A2.1