

ALL REINF. STAINLESS STEEL

Vermont Agency of Transportation

RECEIVED

CK'D BY Stephen Coley OK'D BY Rob Young

January 23, 2018

RESUBMIT No Approved
BY Rob Young DATE 01/26/2018

WORK THIS DRAWING WITH DRAWING B1


FOR APPROVAL

NOTES:

- 1 3/4" CLR. UNLESS NOTED OTHERWISE
- 2'-2" BAR LAP UNLESS NOTED OTHERWISE
- SEE CONTRACT DRAWING, SHEETS 17, 18, & 41 FOR BARS NOT LISTED ON THIS SHEET.


LEGEND:

CONT.-CONTINUOUS	E.E.-EACH END
TRANS.-TRANSVERSE	E.F.-EACH FACE
DWLS.-DOWELS	F.F.-FRONT FACE
VERTS.-VERTICAL	R.F.-REAR FACE
HORIZ.-HORIZONTAL	E.W.-EACH WAY
T&B -TOP & BOTTOM	O.C.-ON CENTER
I.F.-INNER FACE	L.W.-LONG WAY
O.F.-OUTER FACE	S.W.-SHORT WAY

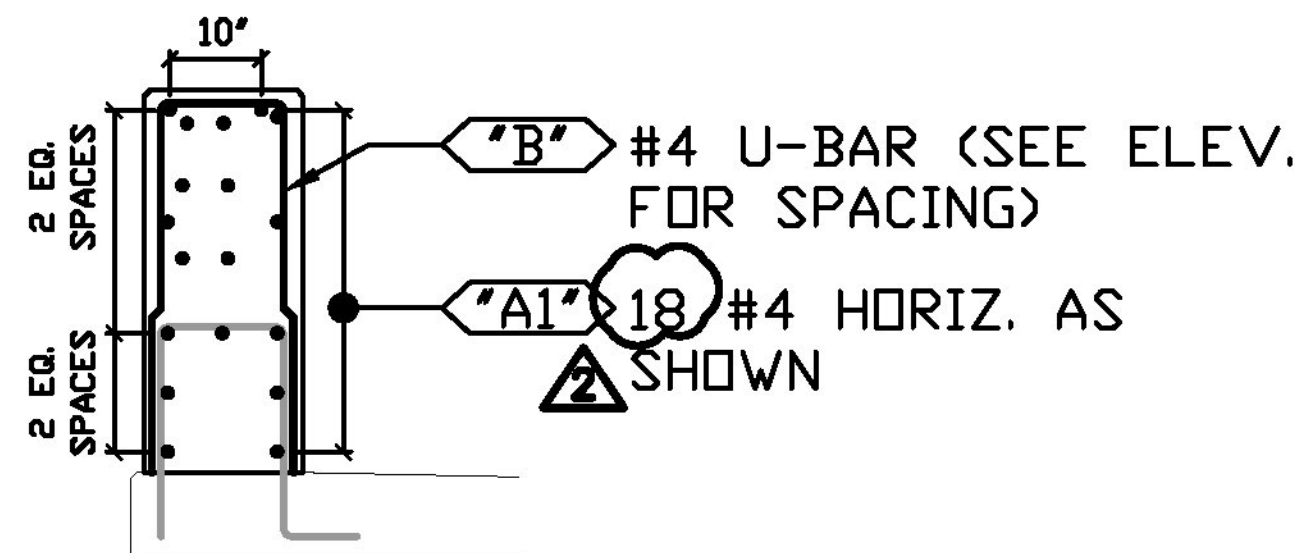


SECTION A-A

CONTRACT DWG. REF. 19 OF 53

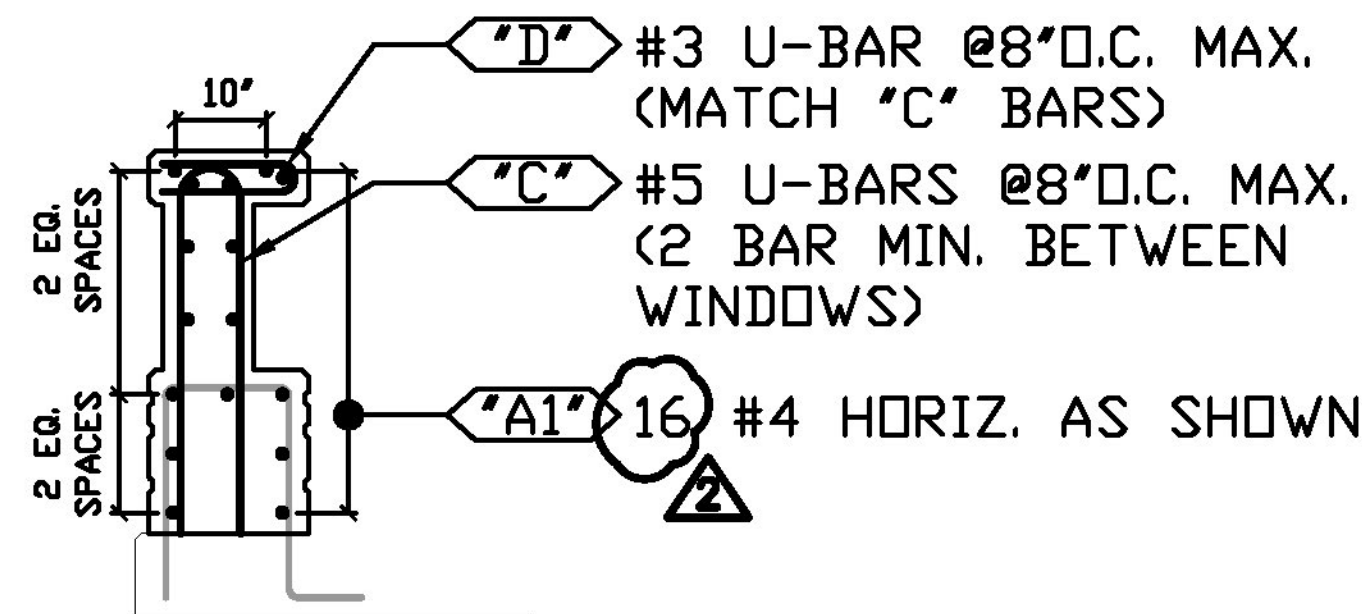


SECTION B-B

CONTRACT DWG. REF. 19 OF 53

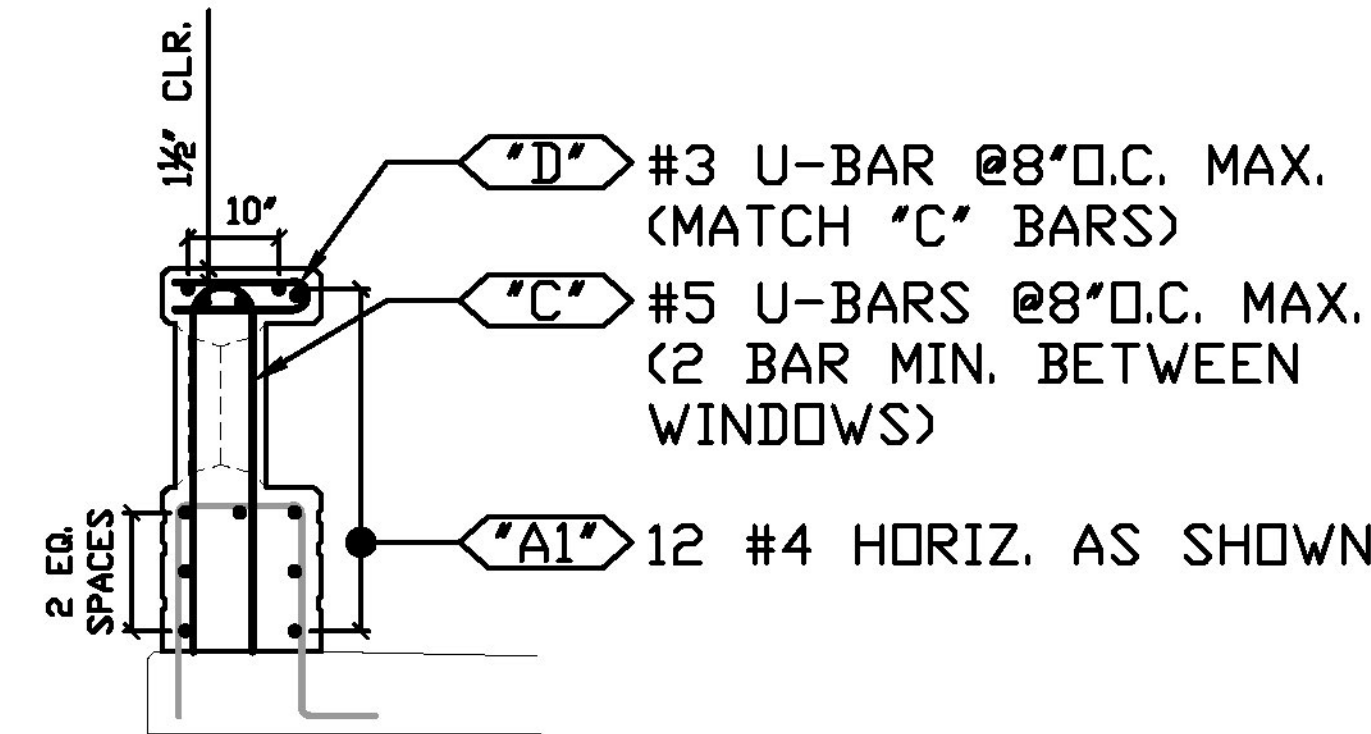


SECTION C-C

CONTRACT DWG. REF. 19 OF 53

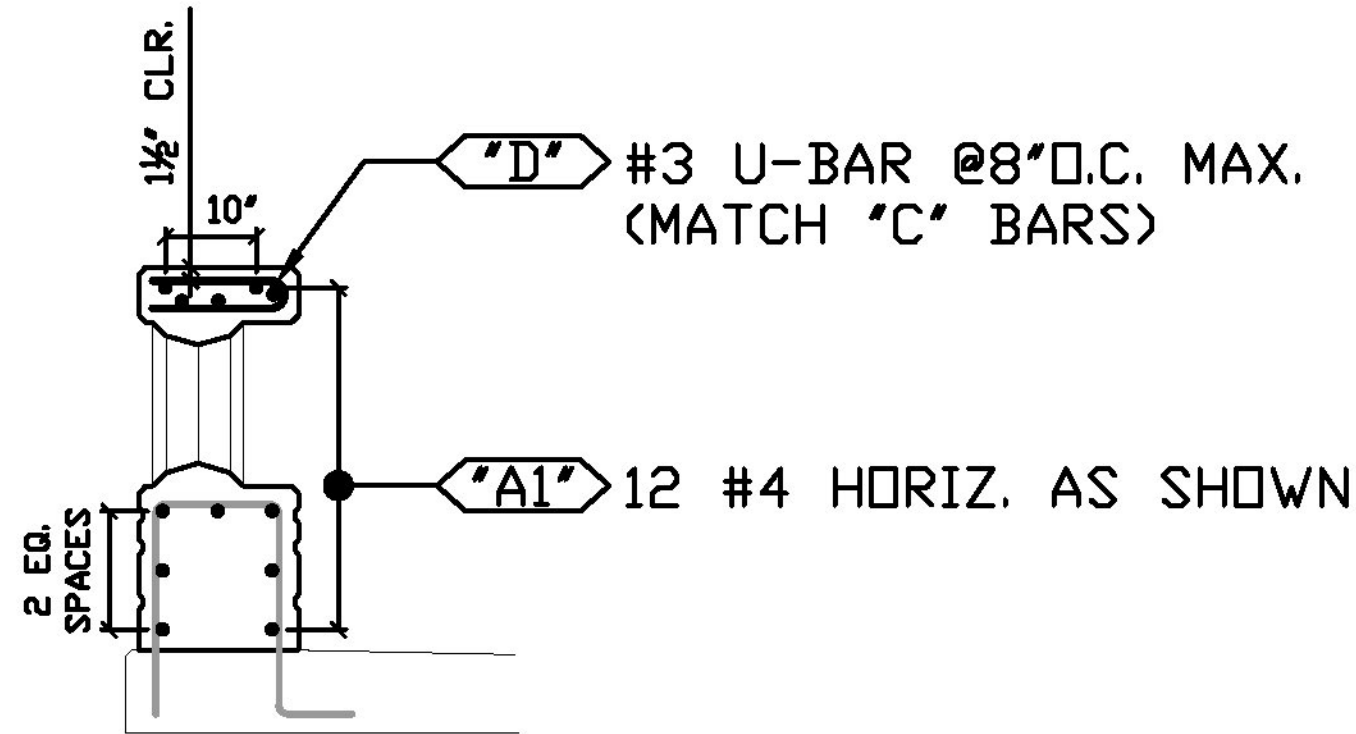


SECTION D-D

CONTRACT DWG. REF. 19 OF 53

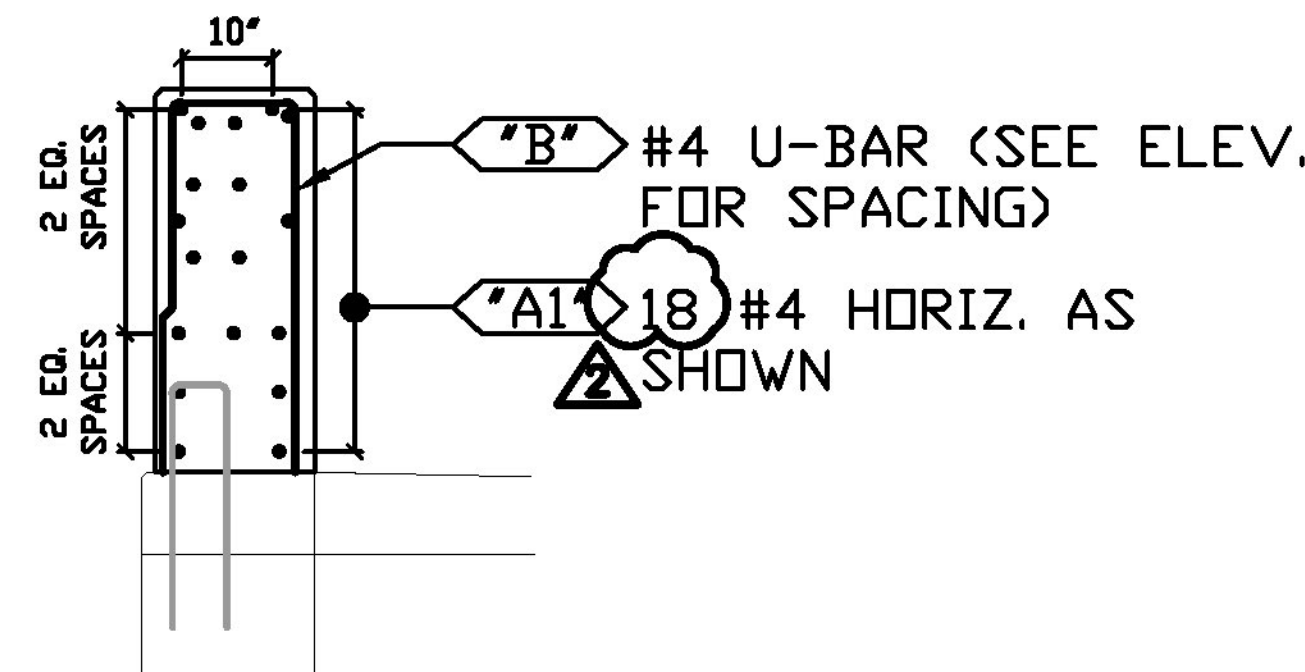


SECTION E-E

CONTRACT DWG. REF. 19 OF 53

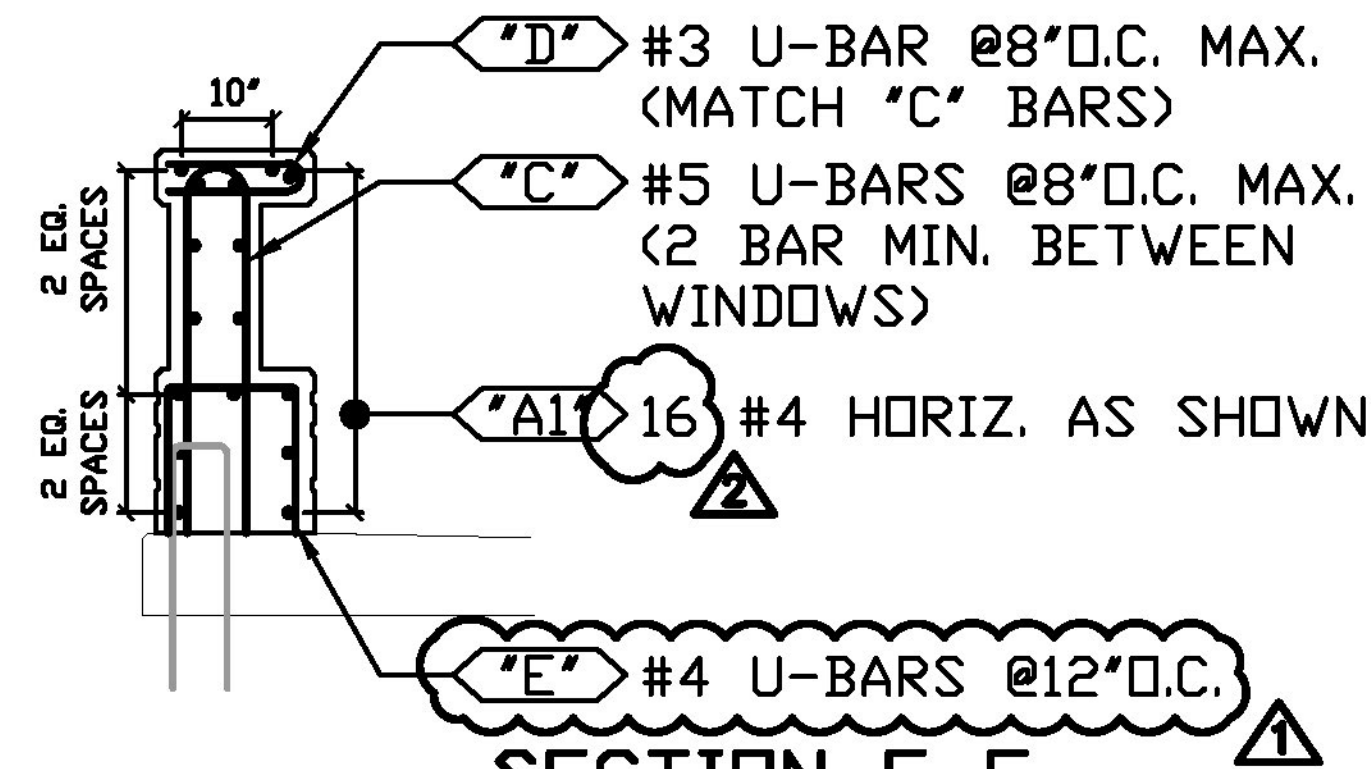


SECTION F-F

CONTRACT DWG. REF. 19 OF 53

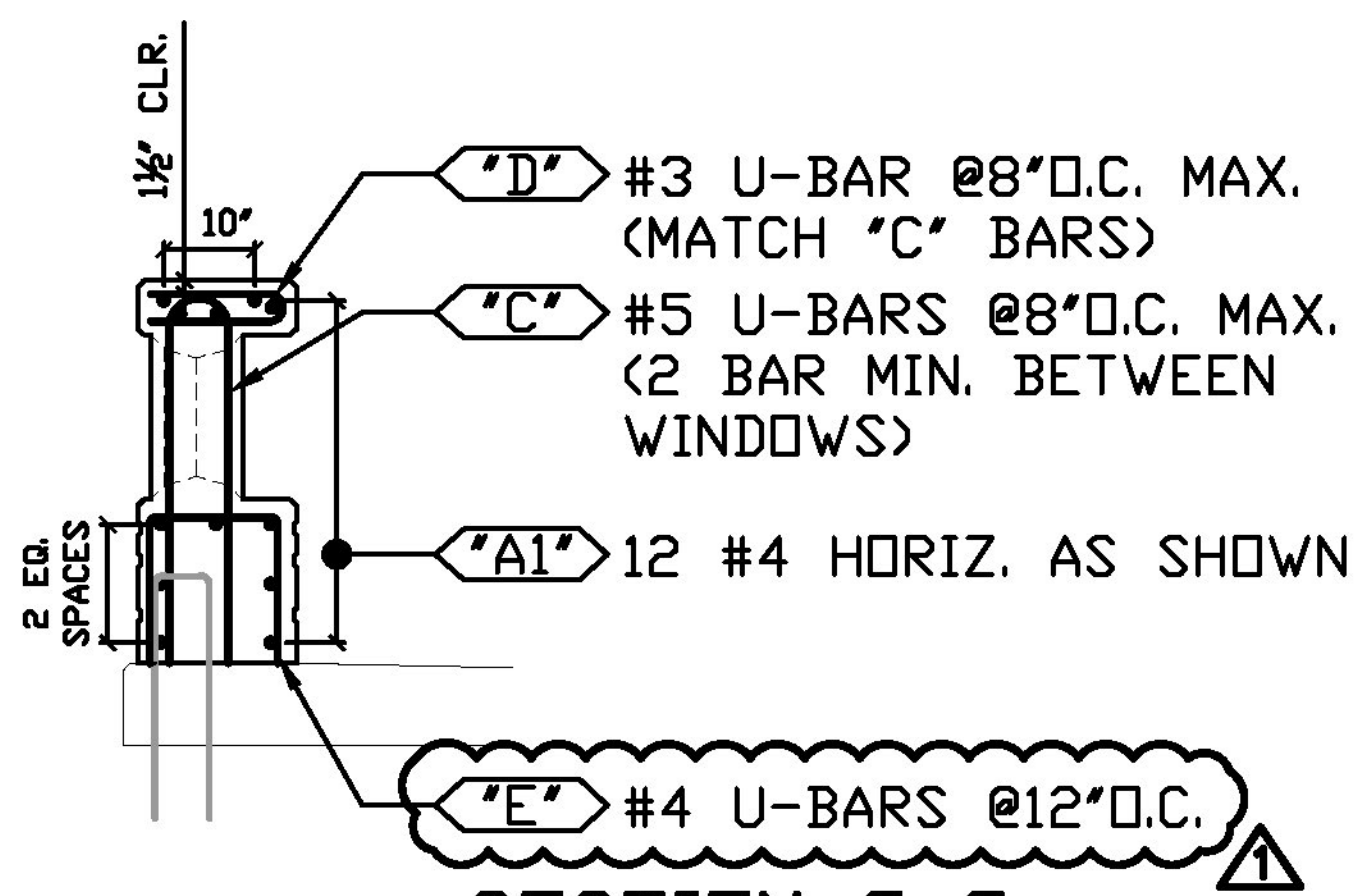

SECTION G-G

CONTRACT DWG. REF. 19 OF 53

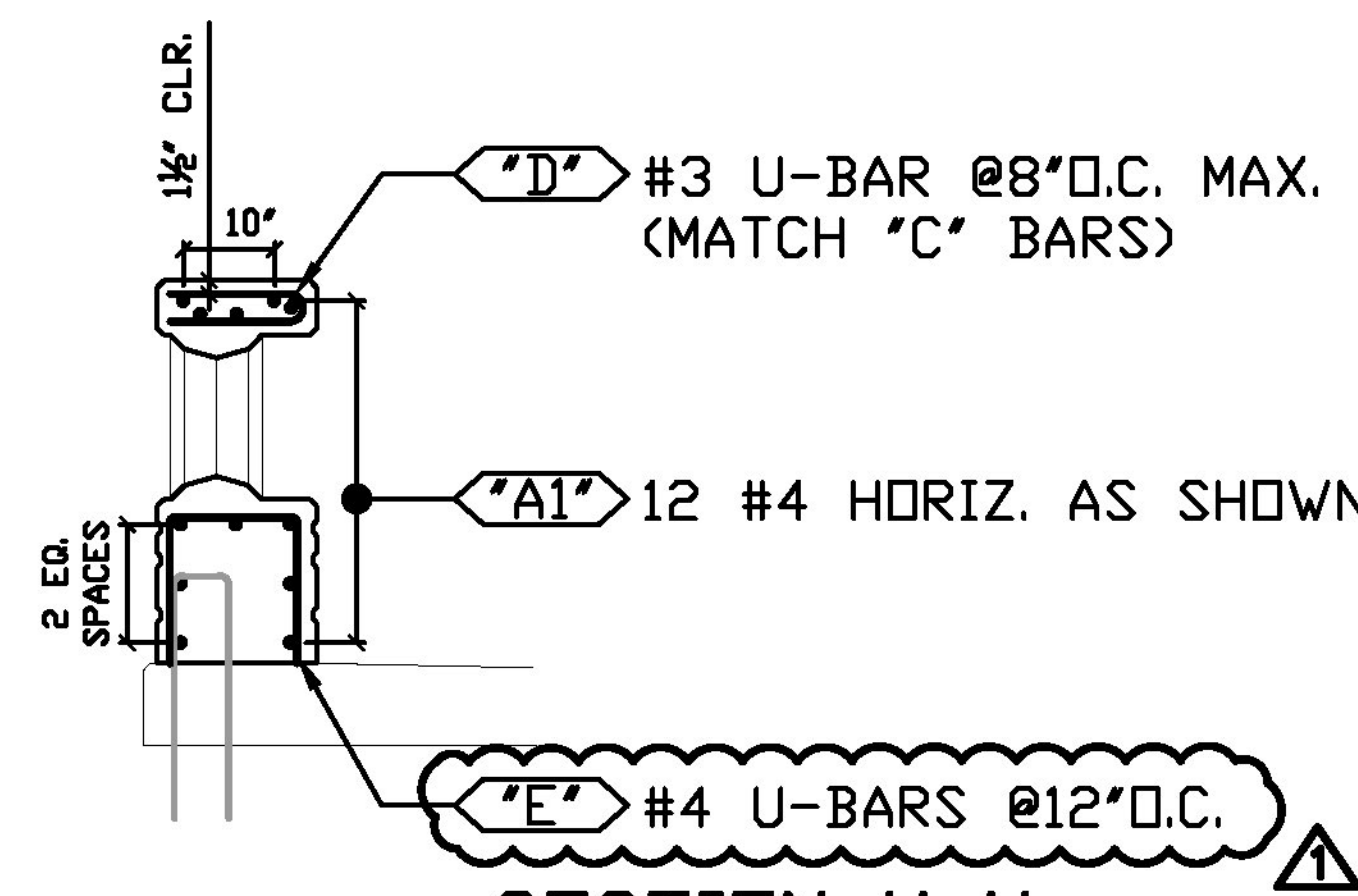

SECTION H-H

CONTRACT DWG. REF. 19 OF 53

ELEVATIONS & DIMENSIONS SHOWN ON THIS DWG. ARE FOR REINF. DETAILING PURPOSES ONLY AND ARE NOT INTENDED FOR DIMENSIONAL CONSTRUCTION.

REINF. BARS ASTM A955 GRADE 60

VERIFICATION OF UNCLEAR INFORMATION MAY BE REQUESTED ON THIS DRAWING. SHOULD VERIFICATION BE LEFT UN-ADDRESSED IT WILL REMAIN AS SHOWN AND ASSUME TO BE CORRECT.

6			
5			
4			
3	1/22/18	2	REVISED AS NOTED/FOR APPROVAL
2	1/10/18	1	REVISED AS NOTED/FOR APPROVAL
1	12/6/17	-	FOR APPROVAL
	DATE	REV.#	SENT FOR

<p>2000 7TH STREET SCOTIA, N.Y. 12302 PH: (518) 374-1936 FAX (518) 374-4830 www.dimensionfabricators.com</p>		
STRUCTURE	VTAOT WOODSTOCK BF 020-2(43)	
LOCATION	US RTE 4 (CENTRAL AVE) OVER KEDRON BROOK WOODSTOCK, VT	
ARCHITECT		
ENGINEER	VHB	
CUSTOMER	COLD RIVER BRIDGES, LLC	
DRAWN BY	DATE	DPI #
SDB	12/4/17	10551
DRAWING COVERS		DRAWING #
LEFT BRIDGE RAILING DETAILS		B1.1