

Release Number:		BAR LIST														
Bar Mark	Qty	Size	Total Length	Type	'A'	'B'	'C'	'D'	'E'	'F'	'G'	'H'	'J'	'K'	'O'	'R'
32BR01	136	#3	2'-7"	17		1'-2"	0'-3"	1'-2"								
41BR01	34	#4	3'-10"	17		1'-4"	1'-2"	1'-4"								
41BR02	4	#4	4'-2 3/4"	3		2'-9"	1'-5 1/2"					0'-7"		1'-4 1/2"	4'-1 1/2"	
42BR01	2	#4	6'-6"	17		2'-8"	1'-2"	2'-8"								
42BR02	8	#4	7'-11"	17		3'-4 1/2"	1'-2"	3'-4 1/2"								
42BR03	2	#4	7'-9"	17		3'-3 1/2"	1'-2"	3'-3 1/2"								
52BR01	95	#5	7'-2 1/2"	17		3'-4"	0'-6 1/2"	3'-4"								

**ALL REINF. STAINLESS STEEL**


Vermont Agency of Transportation  
**RECEIVED**  
 CK'D BY Stephen Coley OK'D BY Rob Young  
 January 23, 2018  
 RESUBMIT No Approved  
 BY Rob Young DATE 01/28/2018

WORK THIS DRAWING WITH DRAWING B2.1

**FOR APPROVAL**

**LEGEND:**

CONT.-CONTINUOUS	E.E.-EACH END
TRANS.-TRANSVERSE	E.F.-EACH FACE
DWLS.-DOWELS	F.F.-FRONT FACE
VERTS.-VERTICAL	R.F.-REAR FACE
HORIZ.-HORIZONTAL	E.W.-EACH WAY
T&B -TOP & BOTTOM	O.C.-ON CENTER
I.F.-INNER FACE	L.W.-LONG WAY
O.F.-OUTER FACE	S.W.-SHORT WAY

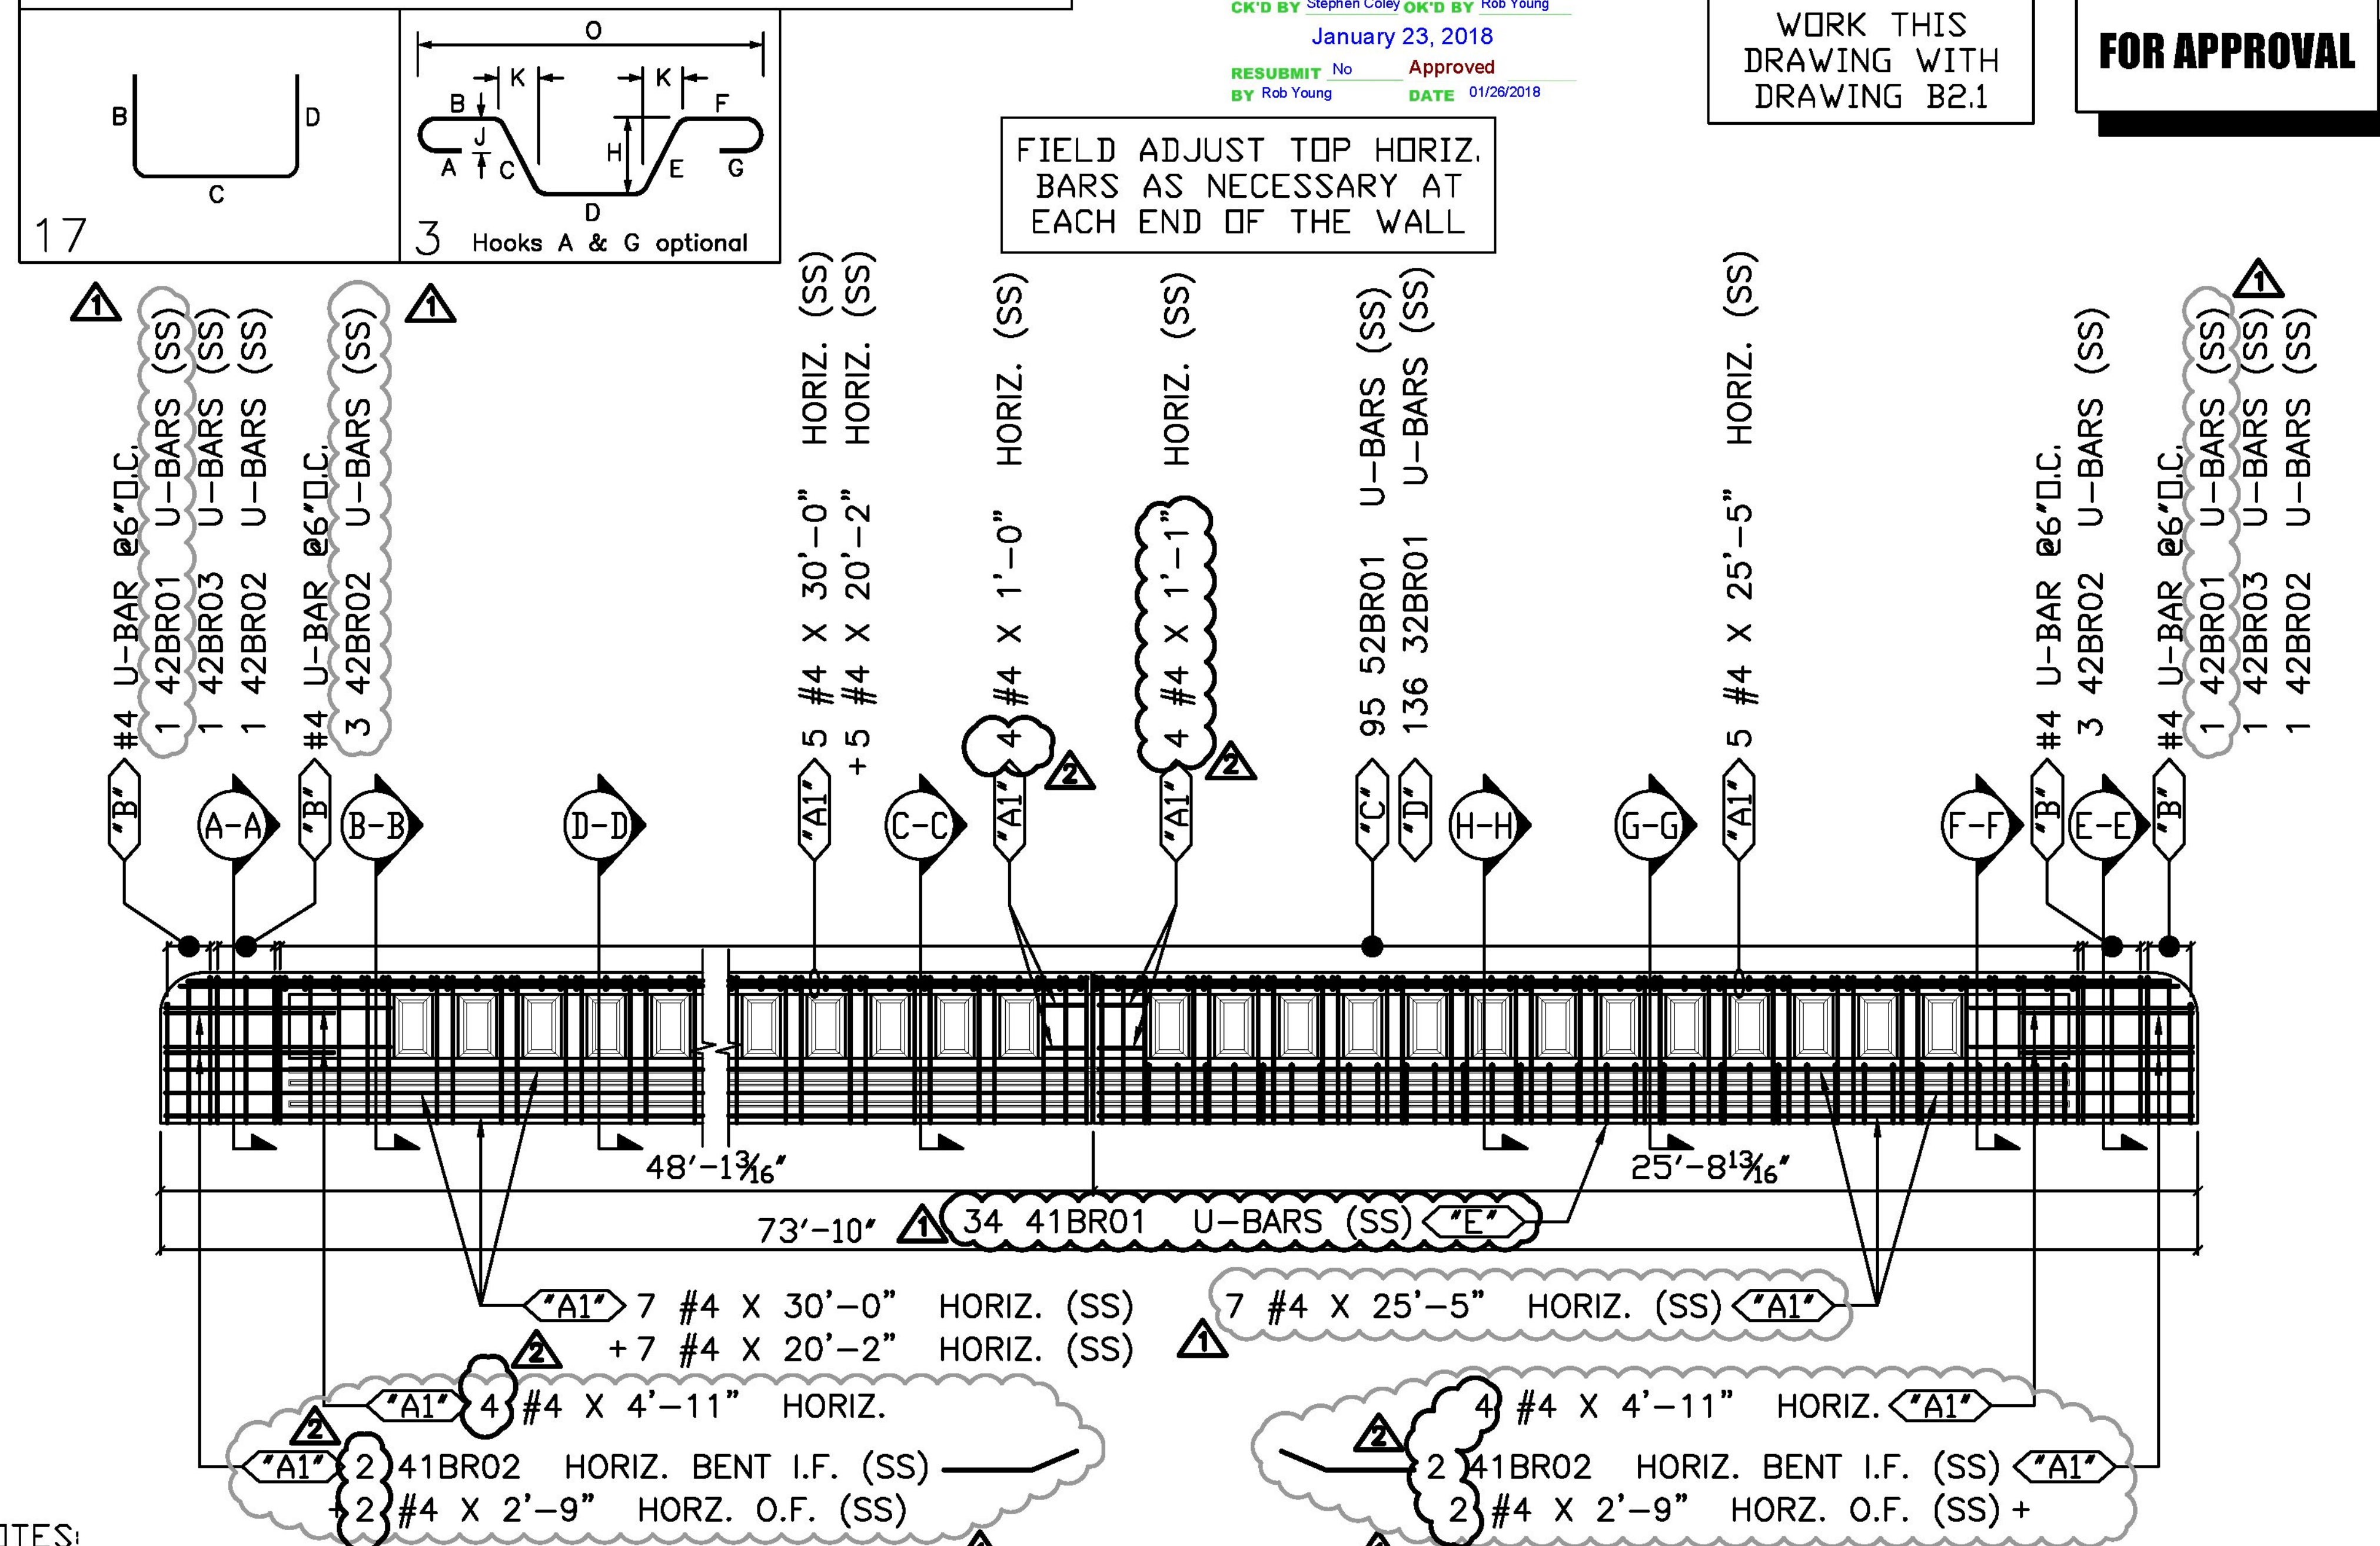

ELEVATIONS & DIMENSIONS SHOWN ON THIS DWG. ARE FOR REINF. DETAILING PURPOSES ONLY AND ARE NOT INTENDED FOR DIMENSIONAL CONSTRUCTION.

REINF. BARS ASTM A615 GRADE 60

VERIFICATION OF UNCLEAR INFORMATION MAY BE REQUESTED ON THIS DRAWING. SHOULD VERIFICATION BE LEFT UN-ADDRESSED IT WILL REMAIN AS SHOWN AND ASSUME TO BE CORRECT.

6			
5			
4			
3	1/22/18	2	REVISED AS NOTED/FOR APPROVAL
2	1/10/18	1	REVISED AS NOTED/FOR APPROVAL
1	12/6/17	-	FOR APPROVAL
	DATE	REV.#	SENT FOR
<b>DIMENSION</b> DIMENSION FABRICATORS INC. www.dimensionfabricators.com 2000 7TH STREET SCOTIA, N.Y. 12302 PH: (518) 374-1936 FAX (518) 374-4830			
STRUCTURE	VTAOT WOODSTOCK BF 020-2(43)		
LOCATION	US RTE 4 (CENTRAL AVE) OVER KEDRON BROOK WOODSTOCK, VT		
ARCHITECT	VHB		
ENGINEER	VHB		
CUSTOMER	COLD RIVER BRIDGES, LLC		
DRAWN BY	DATE	DPI #	
SDB	12/4/17	10551	
DRAWING COVERS		DRAWING #	
RIGHT BRIDGE RAILING ELEVATION		B2	

**NOTES:**

- 1 3/4" CLR. UNLESS NOTED OTHERWISE
- 2'-2" BAR LAP UNLESS NOTED OTHERWISE
- SEE CONTRACT DRAWING, SHEETS 17, 18, & 41 FOR BARS NOT LISTED ON THIS SHEET.

**RIGHT BRIDGE RAIL ELEVATION**  
 CONTRACT DWG. REF. 18 OF 53