


ALL REINF. STAINLESS STEEL


NOTES:

- 1 3/4" CLR. UNLESS NOTED OTHERWISE
- 2'-2" BAR LAP UNLESS NOTED OTHERWISE
- SEE CONTRACT DRAWING, SHEETS 17, 18, & 41 FOR BARS NOT LISTED ON THIS SHEET.

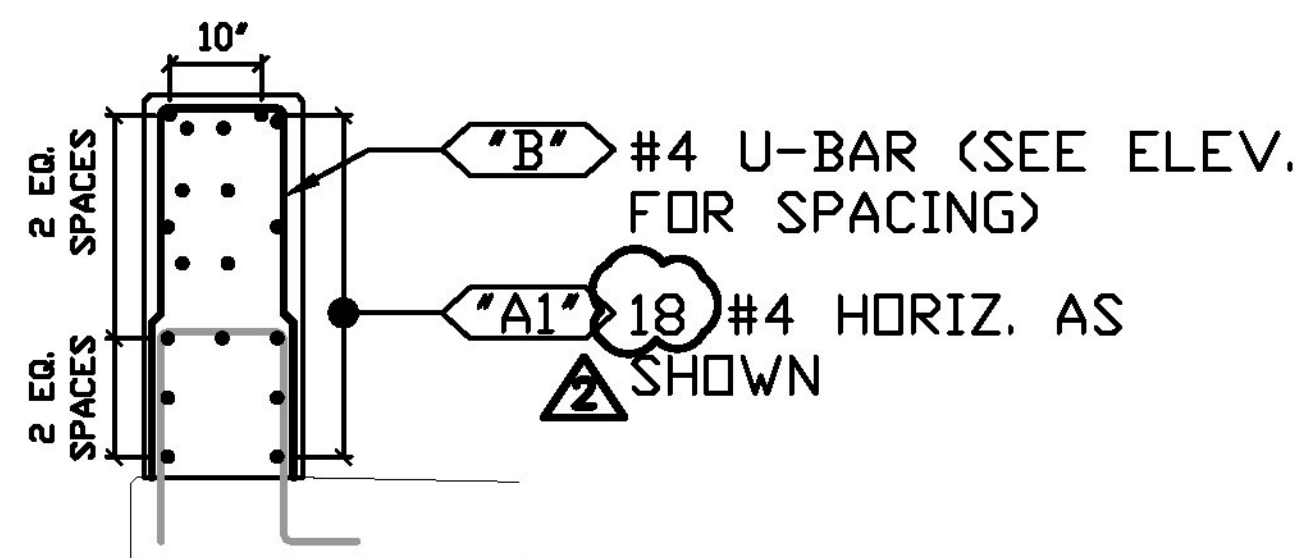


SECTION A-A

CONTRACT DWG. REF. 19 OF 53

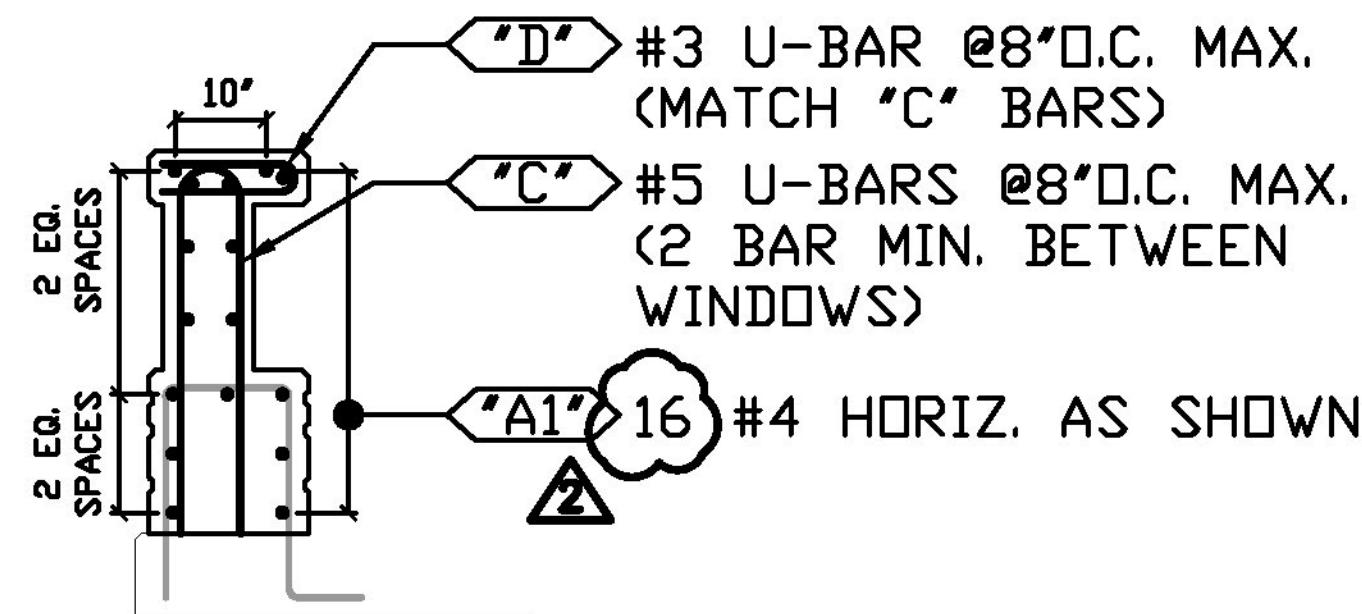


SECTION B-B

CONTRACT DWG. REF. 19 OF 53

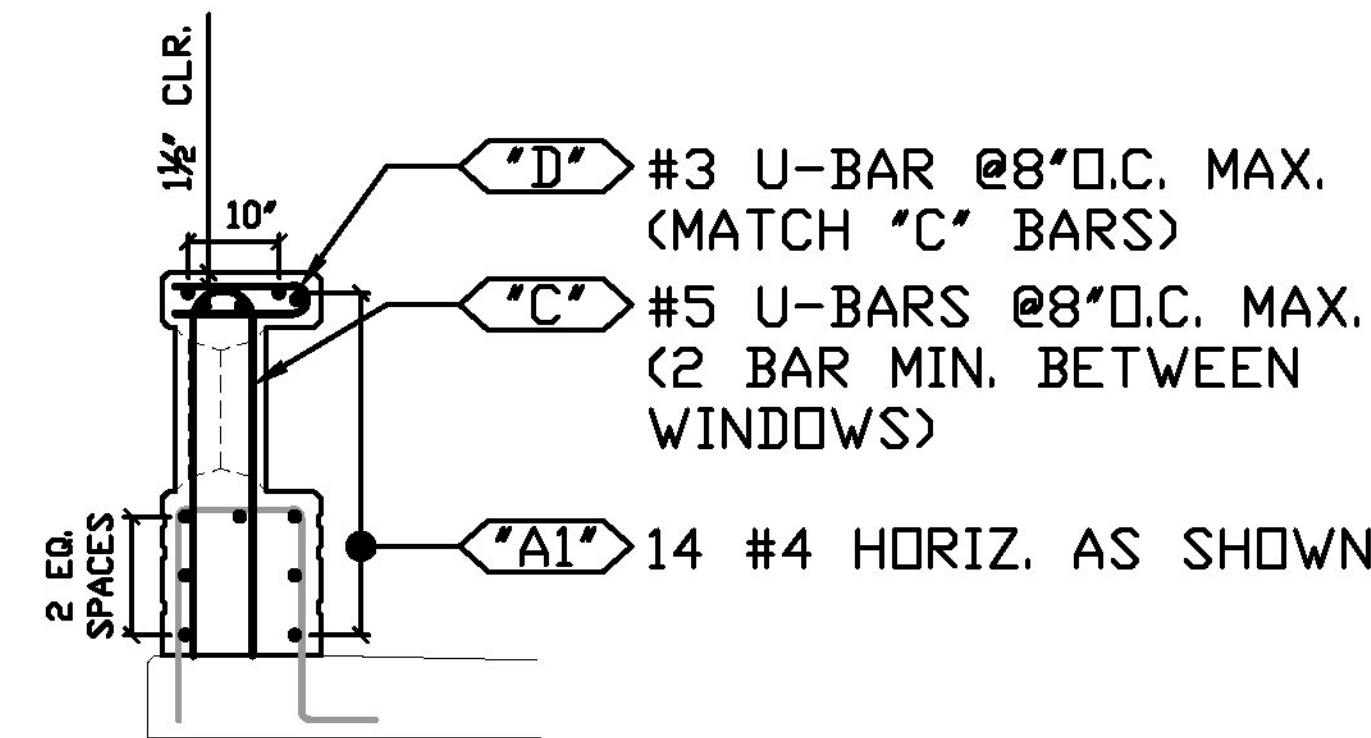


SECTION C-C

CONTRACT DWG. REF. 19 OF 53

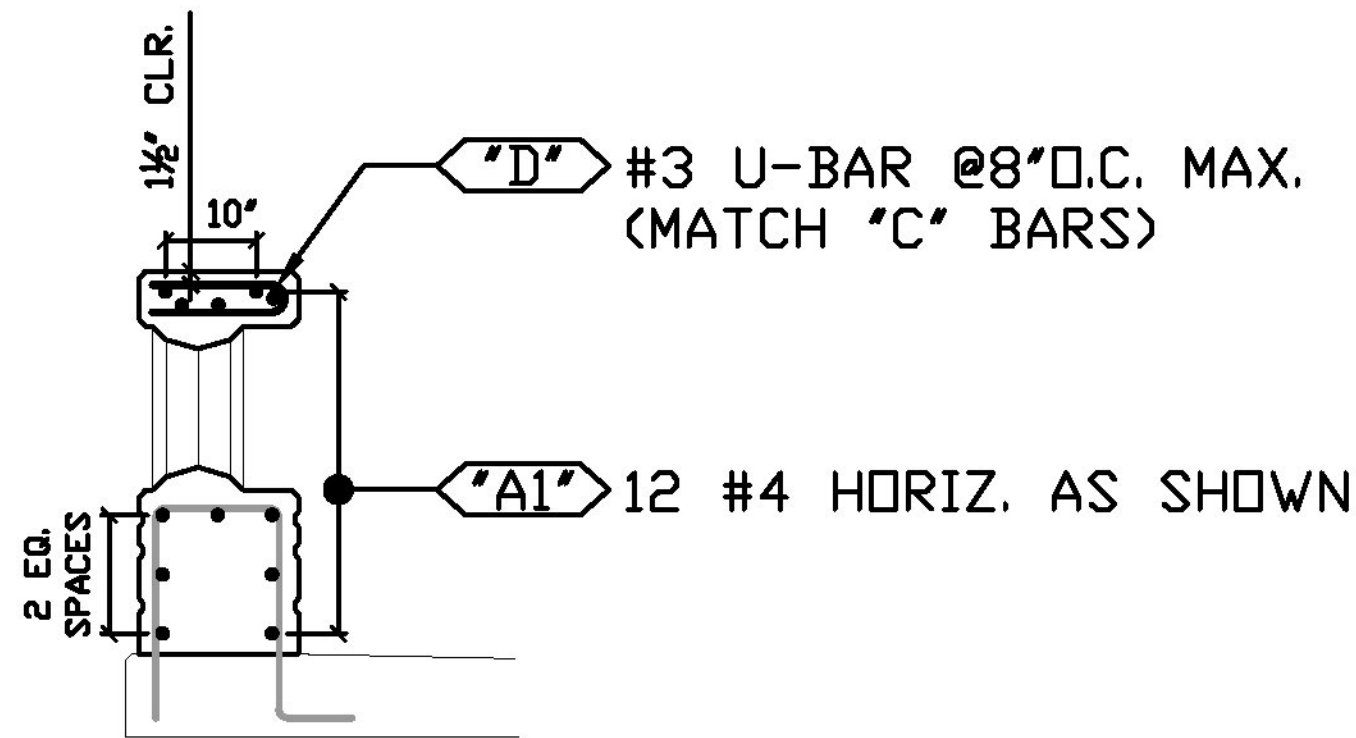


SECTION D-D

CONTRACT DWG. REF. 19 OF 53

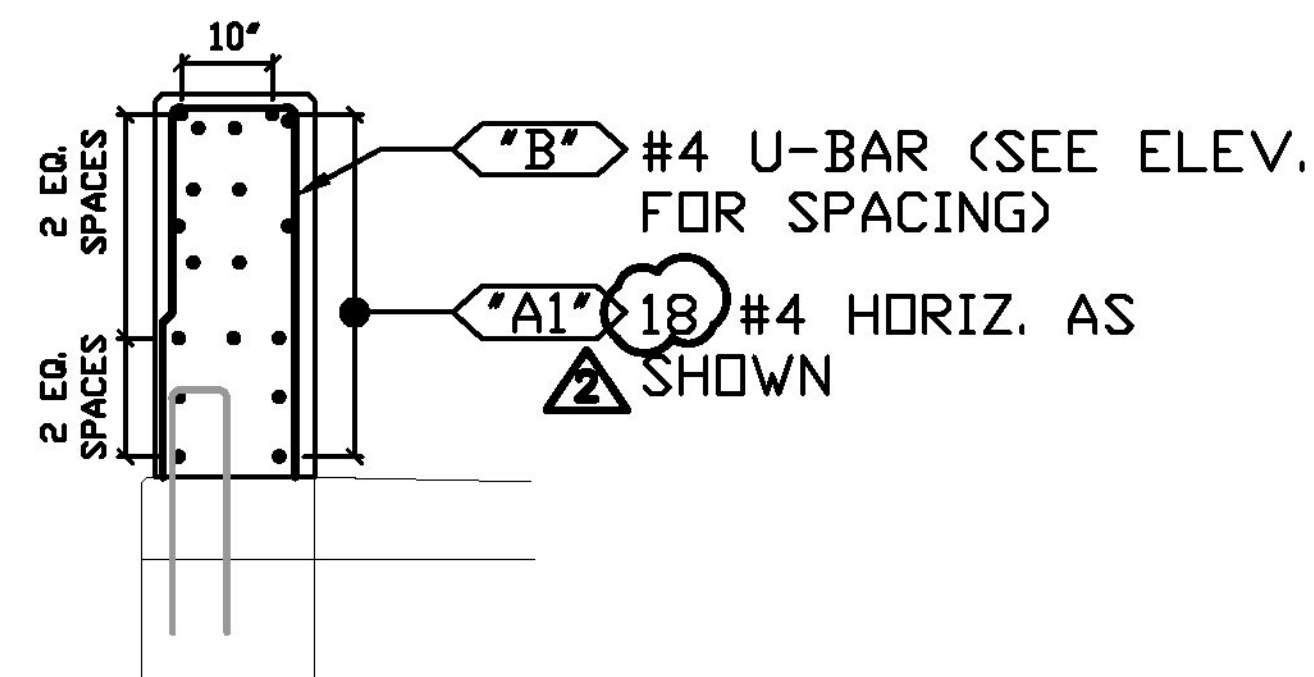


SECTION E-E

CONTRACT DWG. REF. 19 OF 53

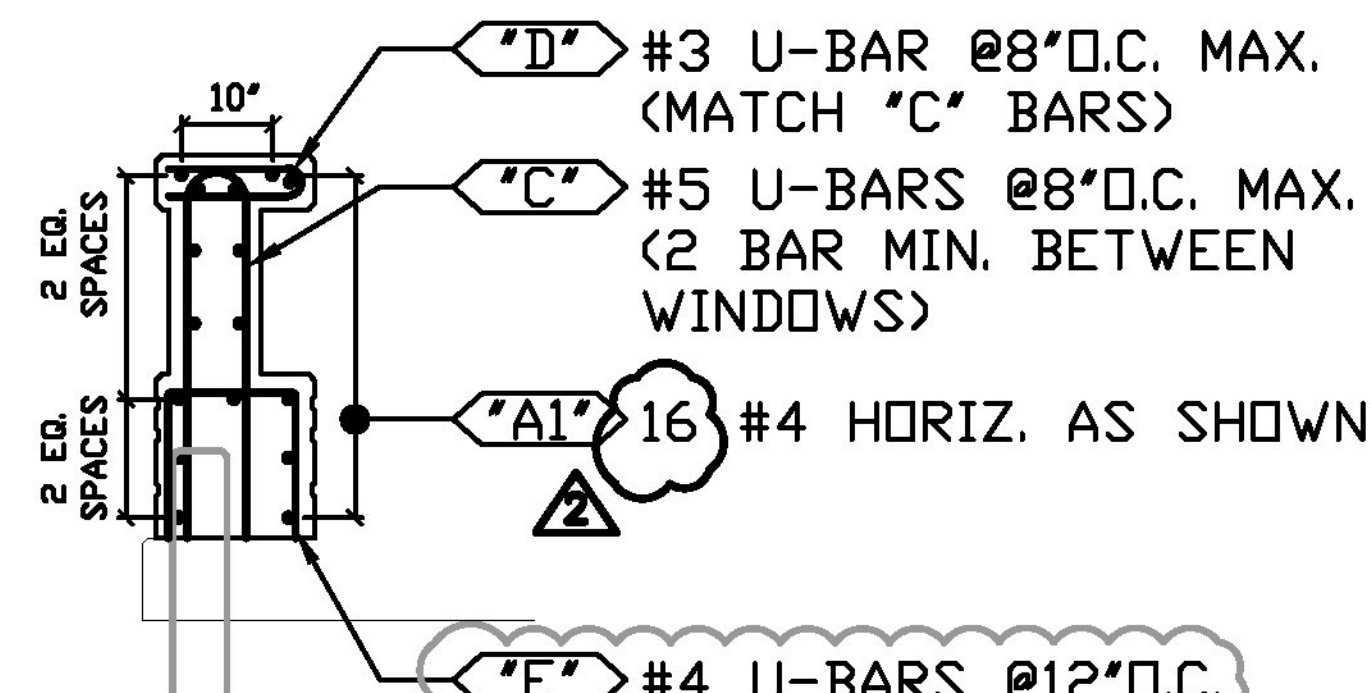


SECTION F-F

CONTRACT DWG. REF. 19 OF 53

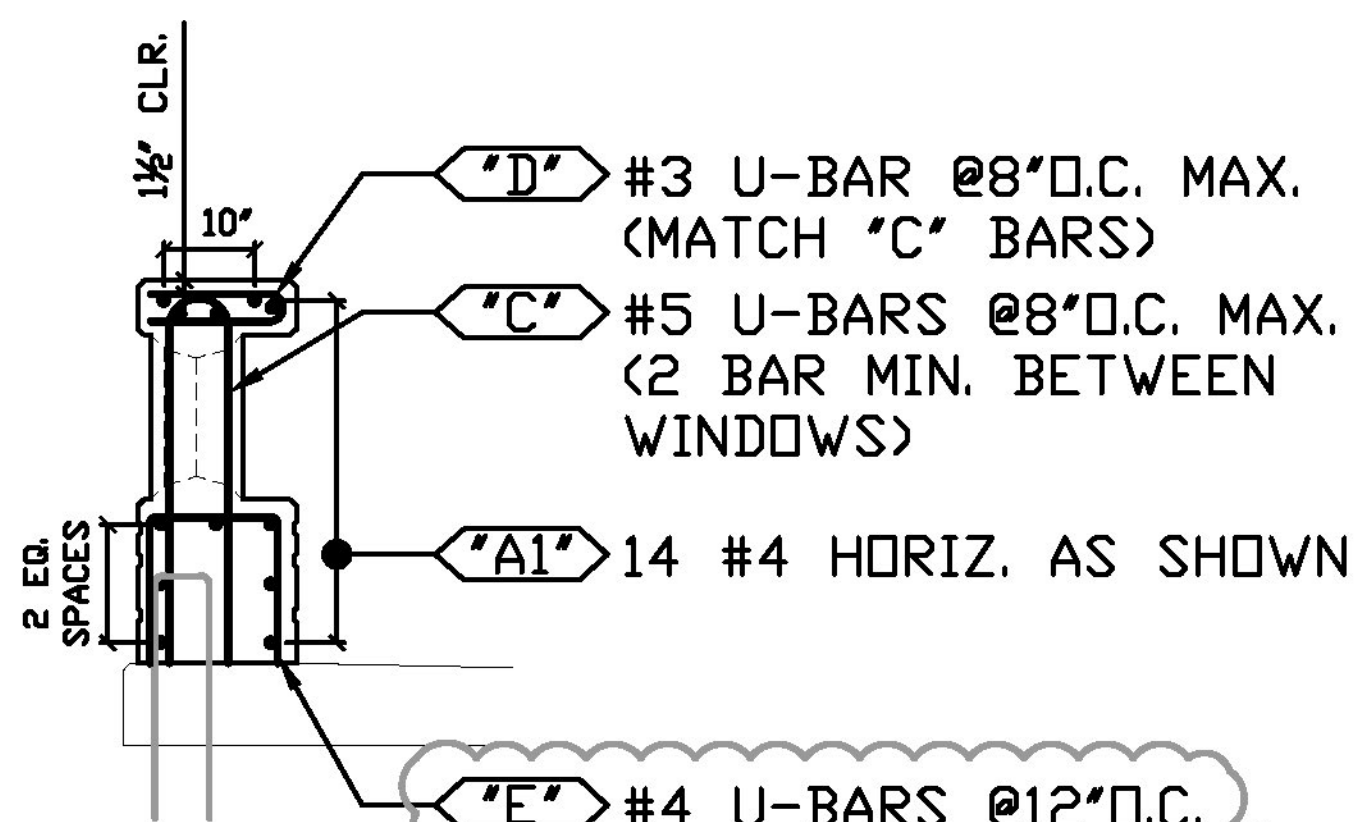

SECTION G-G

CONTRACT DWG. REF. 19 OF 53

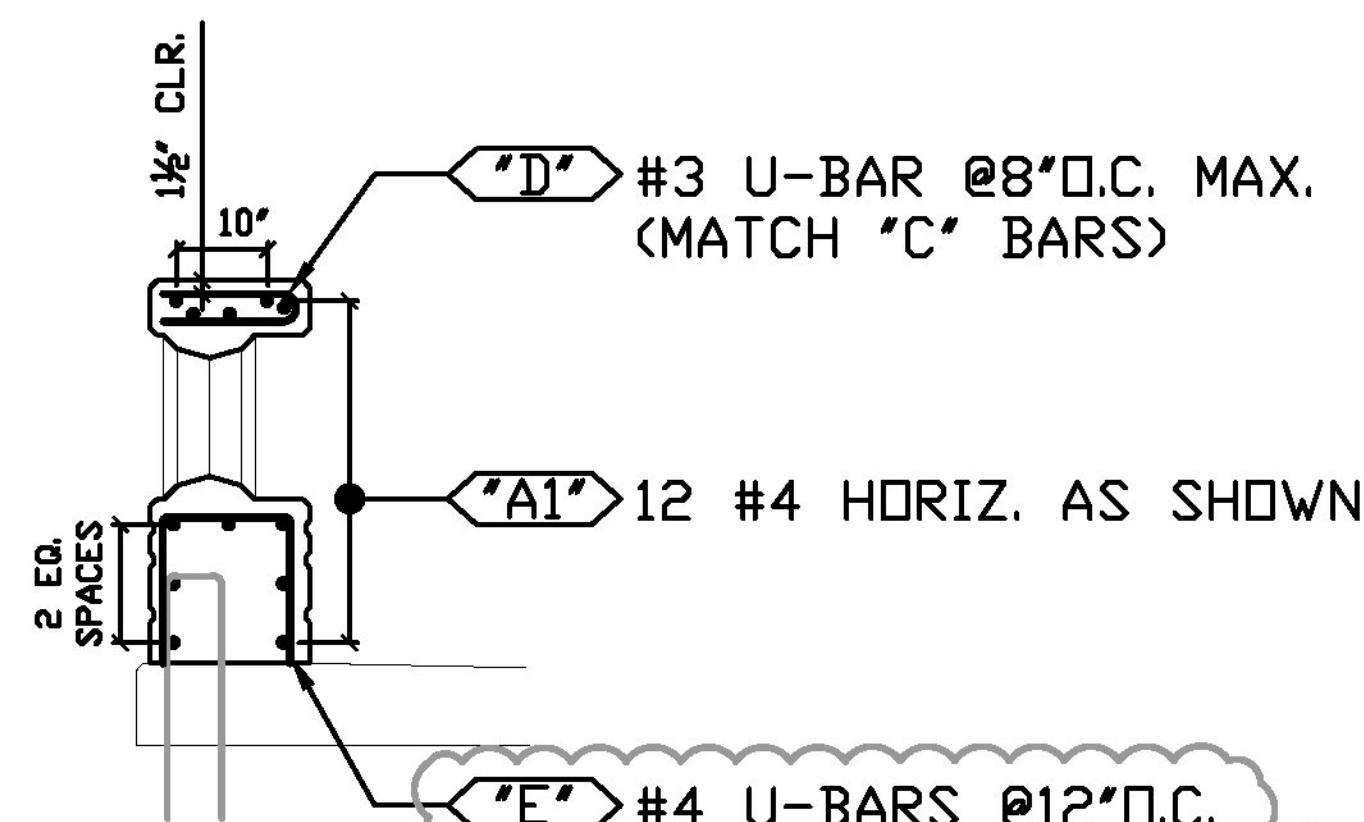

SECTION H-H

CONTRACT DWG. REF. 19 OF 53

WORK THIS DRAWING WITH DRAWING B2

FOR APPROVAL

LEGEND:

CONT.-CONTINUOUS	E.E.-EACH END
TRANS.-TRANSVERSE	E.F.-EACH FACE
DWLS.-DOWELS	F.F.-FRONT FACE
VERTS.-VERTICAL	R.F.-REAR FACE
HORIZ.-HORIZONTAL	E.W.-EACH WAY
T&B -TOP & BOTTOM	O.C.-ON CENTER
I.F.-INNER FACE	L.W.-LONG WAY
O.F.-OUTER FACE	S.W.-SHORT WAY

ELEVATIONS & DIMENSIONS SHOWN ON THIS DWG. ARE FOR REINF. DETAILING PURPOSES ONLY AND ARE NOT INTENDED FOR DIMENSIONAL CONSTRUCTION.

REINF. BARS ASTM A615 GRADE 60

VERIFICATION OF UNCLEAR INFORMATION MAY BE REQUESTED ON THIS DRAWING. SHOULD VERIFICATION BE LEFT UN-ADDRESSED IT WILL REMAIN AS SHOWN AND ASSUME TO BE CORRECT.

6			
5			
4			
3	1/22/18	2	REVISED AS NOTED/FOR APPROVAL
2	1/10/18	1	REVISED AS NOTED/FOR APPROVAL
1	12/6/17	-	FOR APPROVAL
	DATE	REV.#	SENT FOR



DIMENSION

DIMENSION FABRICATORS INC.

2000 7TH STREET
SCOTIA, N.Y. 12302
PH: (518) 374-1936
FAX (518) 374-4830
www.dimensionfabricators.com

STRUCTURE	VTAOT WOODSTOCK BF 020-2(43)		
LOCATION	US RTE 4 (CENTRAL AVE) OVER KEDRON BROOK WOODSTOCK, VT		
ARCHITECT			
ENGINEER	VHB		
CUSTOMER	COLD RIVER BRIDGES, LLC		

DRAWN BY	DATE	DPI #
SDB	12/4/17	10551
DRAWING COVERS		DRAWING #
RIGHT BRIDGE RAILING DETAILS		B2.1

Vermont Agency of Transportation
RECEIVED

CK'D BY Stephen Coley OK'D BY Rob Young

January 23, 2018

RESUBMIT No Approved

BY Rob Young DATE 01/26/2018