

Accepted AsNoted

BY: Robert Young

DATE: 03/30/2018



RESUBMIT: NO

RECEIVED: March 30, 2018

CKD BY: RSY

**STATE OF VERMONT
AGENCY OF TRANSPORTATION**

PEB RAIL rev fabricator 3 30 18.dwg

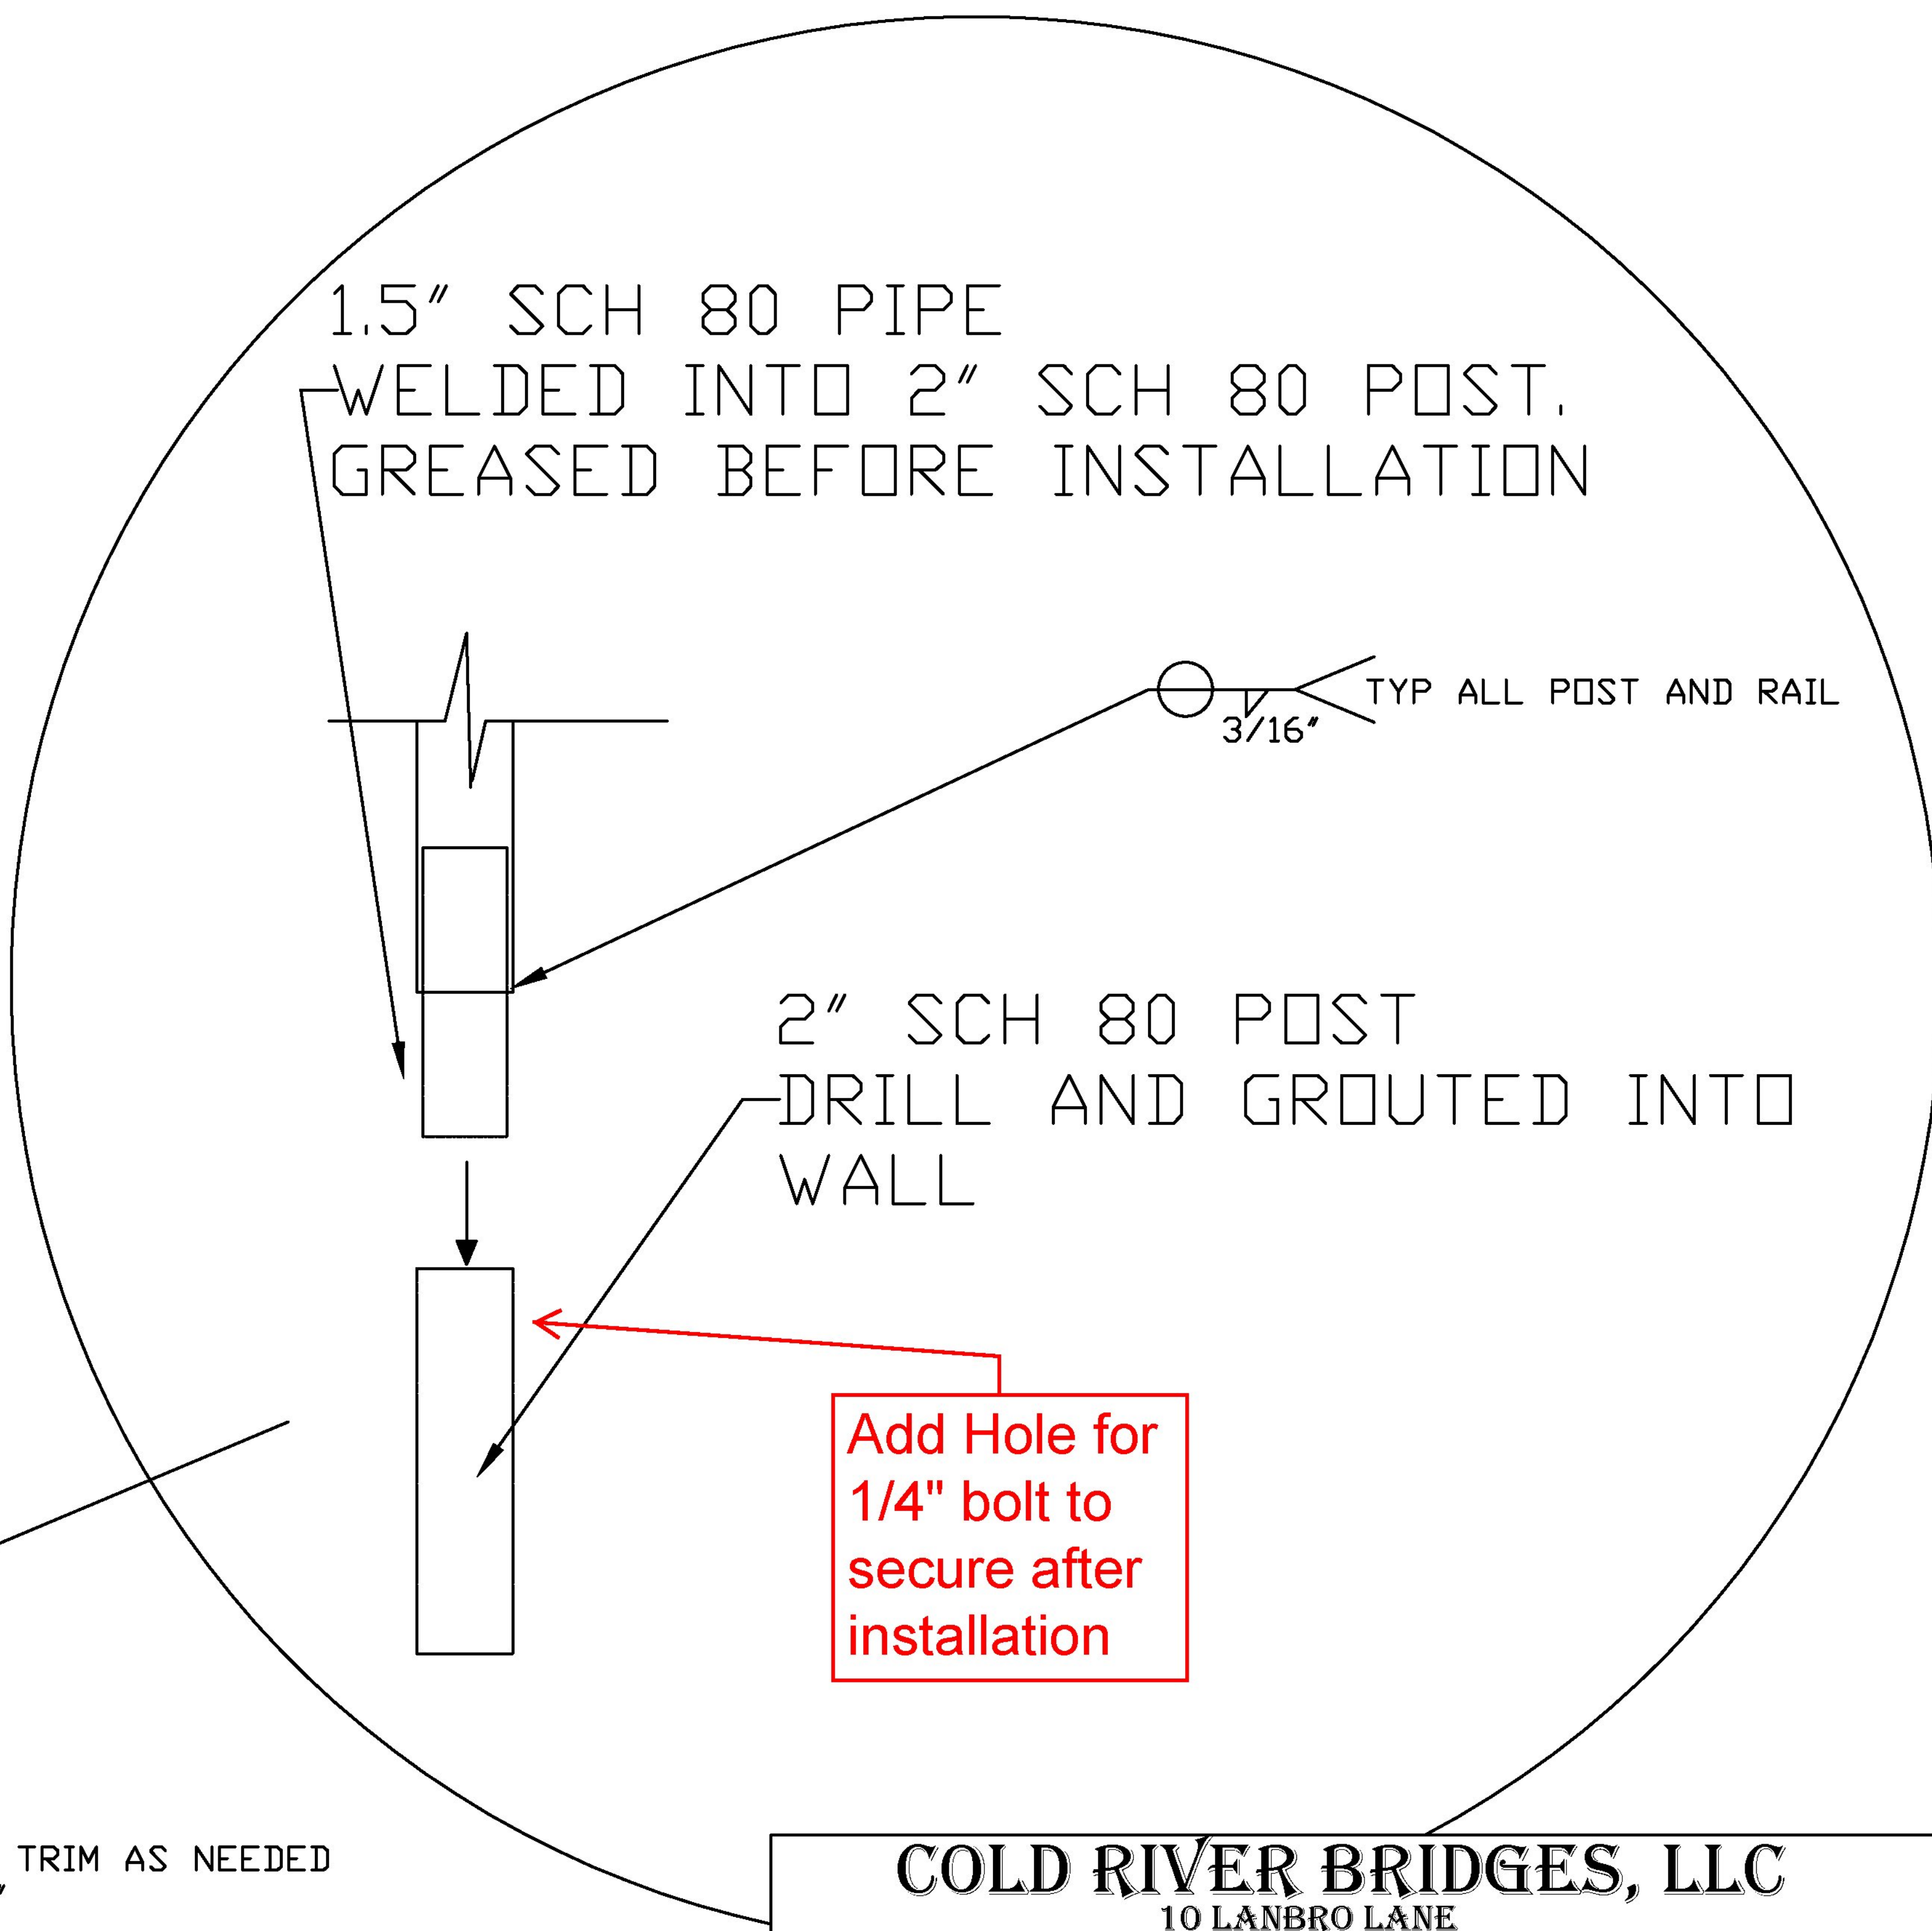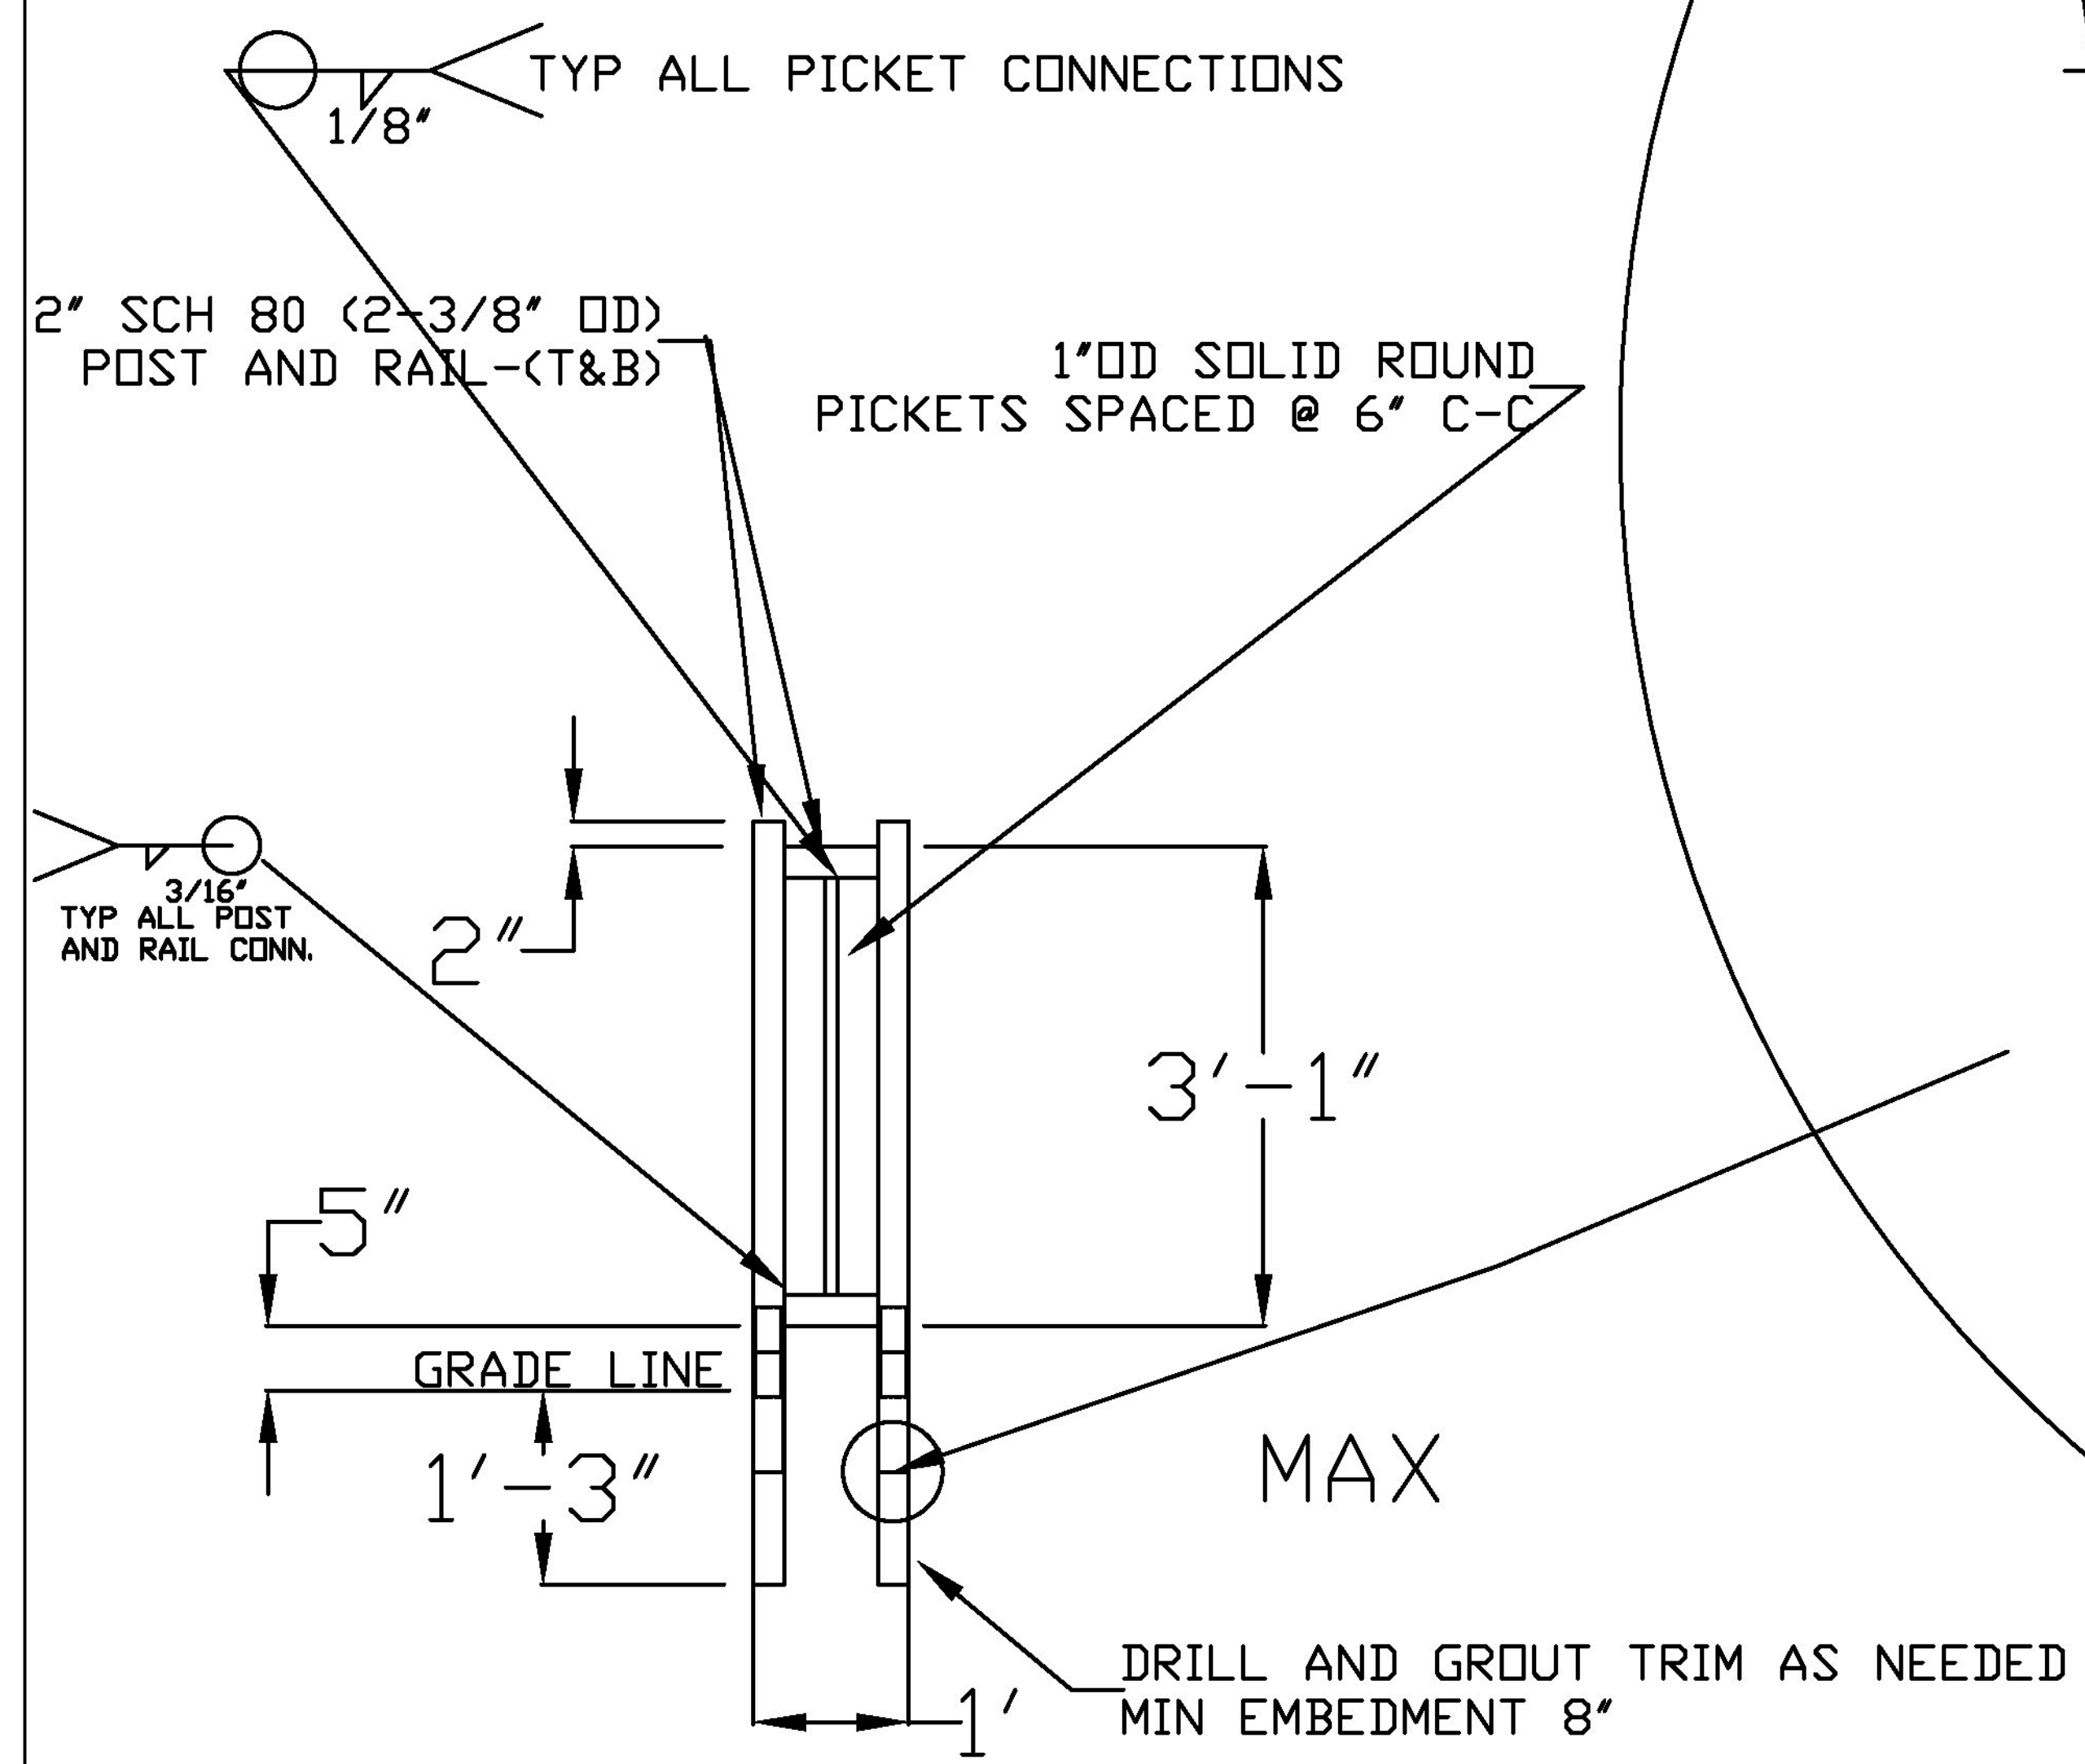

- GENERAL FABRICATION NOTES:
1. ALL RAILING MATERIALS INCLUDING WELDING ELECTRODES MUST MEET THE REQUIREMENTS OF BUY AMERICA
 2. POST & RAILS SHALL BE SCH 80 PIPE, PICKETS SHALL BE A36 SOLID ROUND BAR
 3. ALL MATERIAL TO BE HOT DIPPED GALVANIZED AFTER FABRICATION MEETING REQUIREMENTS OF VTRANS SECTION 726.08.
 4. RAILING SHALL BE POWDER COATED BLACK AFTER GALVANIZING.
 5. GALVANIZING AND POWDER COATING WILL BE PERFORMED BY Duncan Galvanizing in Everett, MA
 6. NOTIFY VTRANS (Ryan Foster) A MINIMUM OF 7 DAYS BEFORE FABRICATION BEGIN TO SCHEDULE SHOP INSPECTION
 7. NON SHRINK GROUT FROM THE APPROVED PRODUCT LIST USE WILL BE USED TO GROUT RAIL POSTS.
 8. RENAUD BROTHERS CONSTRUCTION FROM VERNON, VT IS THE FABRICATOR.

COLD RIVER BRIDGES, LLC	
10 LANBRO LANE WALPOLE, NH	
TEL 603-756-9300	FAX 603-756-9303
VTRANS PROJECT	
WOODSTOCK VILLAGE BF 020-2 (43)	
FABRICATOR: RENAUD BROTHERS CONST.	SHEET NUMBER
PEDESTRIAN RAIL	R3
REV#5	DATE: 1/5/18