


STATE OF VERMONT
AGENCY OF TRANSPORTATION

CKD BY: RSY
RECEIVED: March 30, 2018

RESUBMIT: No
DATE: 03/30/2018

BY: Rob Young

Accepted

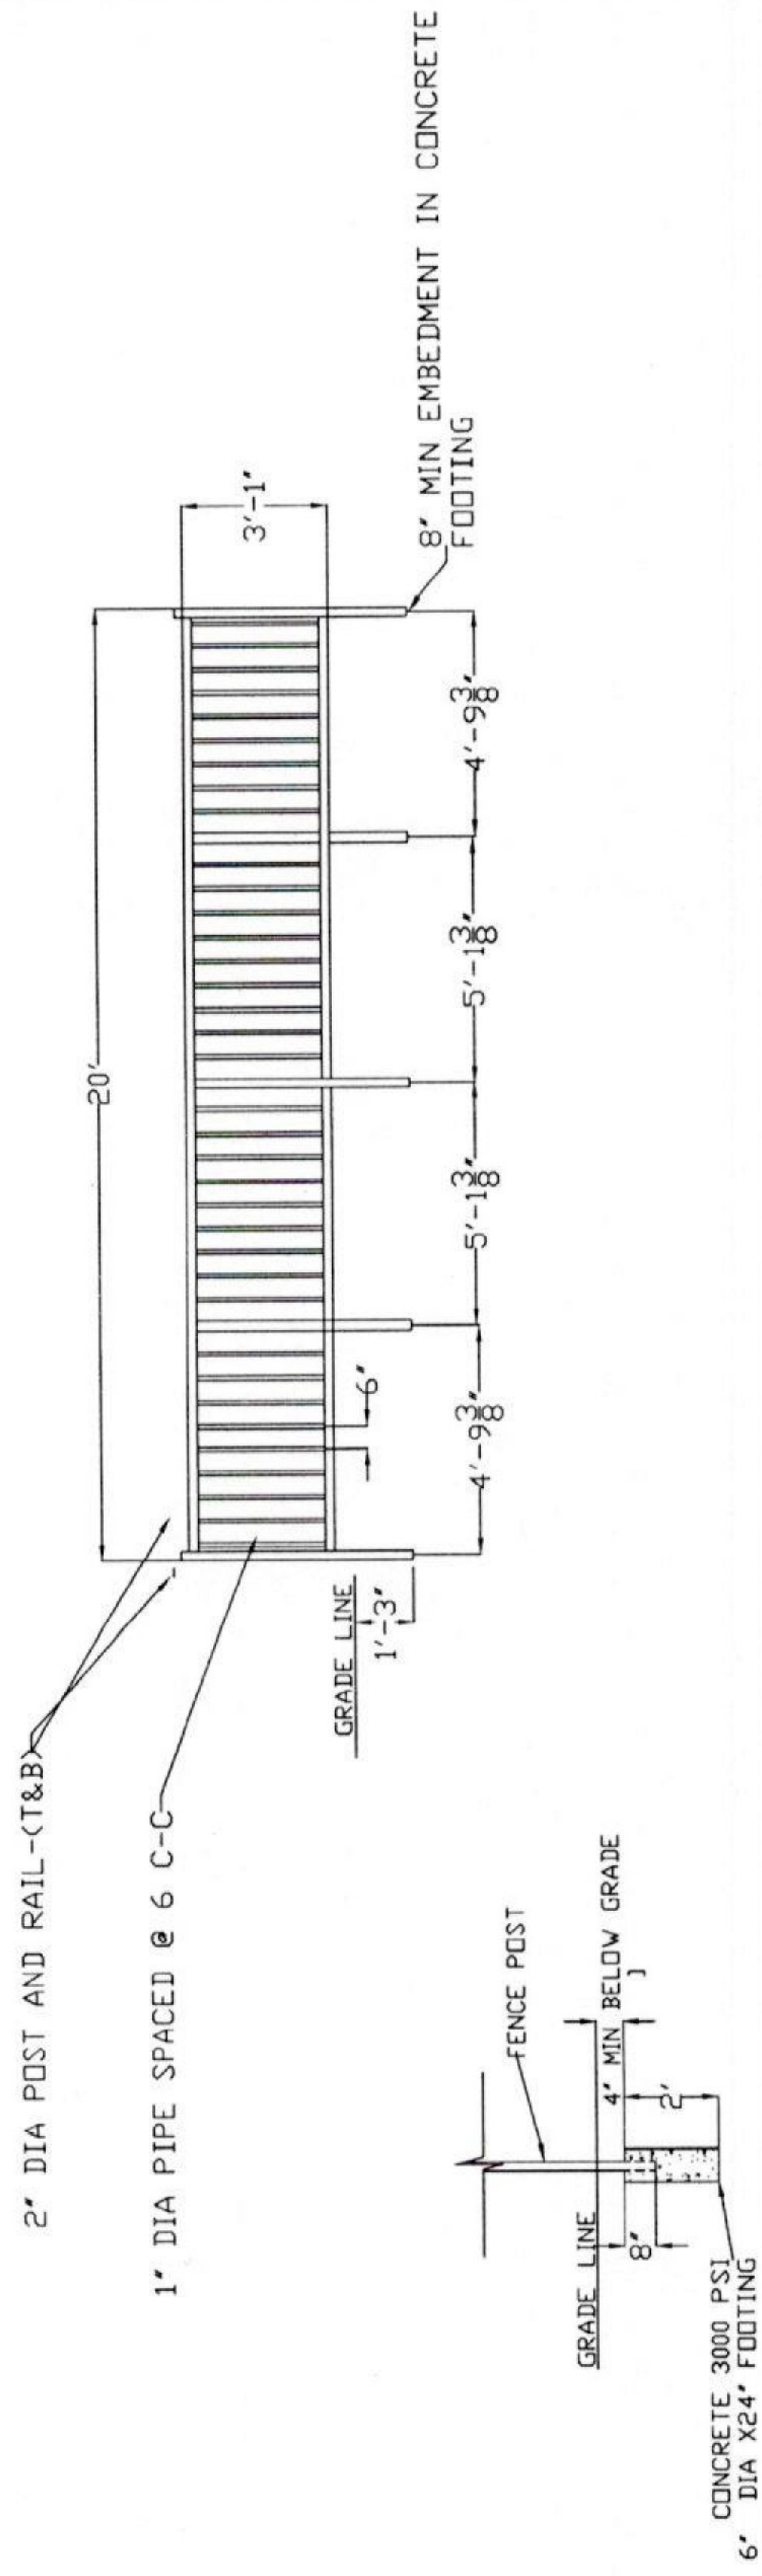

TYPICAL POST CONCRETE POST DETAIL

- GENERAL FABRICATION NOTES:
1. ALL MATERIAL DOMESTIC GRADE 36 SCHEDULE 40, POST GRADE 80 PIPE.
 2. ALL MATERIAL TO BE HOT DIPPED GALVANIZED AFTER FABRICATION MEETING REQUIREMENTS OF VTRANS SECTION 726.08.
 3. RAILING SHALL BE POWDER COATED BLACK AFTER GALVANIZING.
 4. NON SHRINK GROUT FROM THE APPROVED PRODUCT USE WILL BE USED TO GROUT RAIL POSTS.

COLD RIVER BRIDGES, LLC
10 LANDBRO LANE
WALPOLE, NH
TEL 603-756-9300 FAX 603-756-9303

WOODSTOCK VILLAGE BF 020-2 (43)

PEDESTRIAN RAIL

SHEET NUMBER

R1

DATE: 1/5/18