


Winooski River

PI 9+37.08
STONE CUTTERS WAY

GRAVEL DRIVE

NOTE:
ALL WORK DETAILED ON THIS SHEET
WILL BE PERFORMED BY OTHERS.

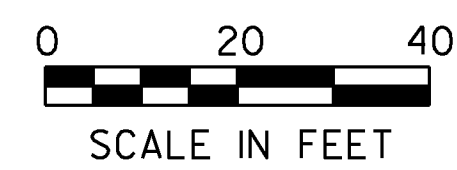

PROJECT NAME:	MONTPELIER	PLOT DATE:	5/12/2014
PROJECT NUMBER:	BF BPNT (17)	DRAWN BY:	T. MANAHAN
FILE NAME:	z13j290bdr_util.dgn	DESIGNED BY:	FAIRPOINT
PROJECT LEADER:	T. KNIGHT	CHECKED BY:	T. KNIGHT
UTILITY PLAN - UTL 1		SHEET	6 OF 16

