




SECTION C-C
SCALE 1" = 1'-0"

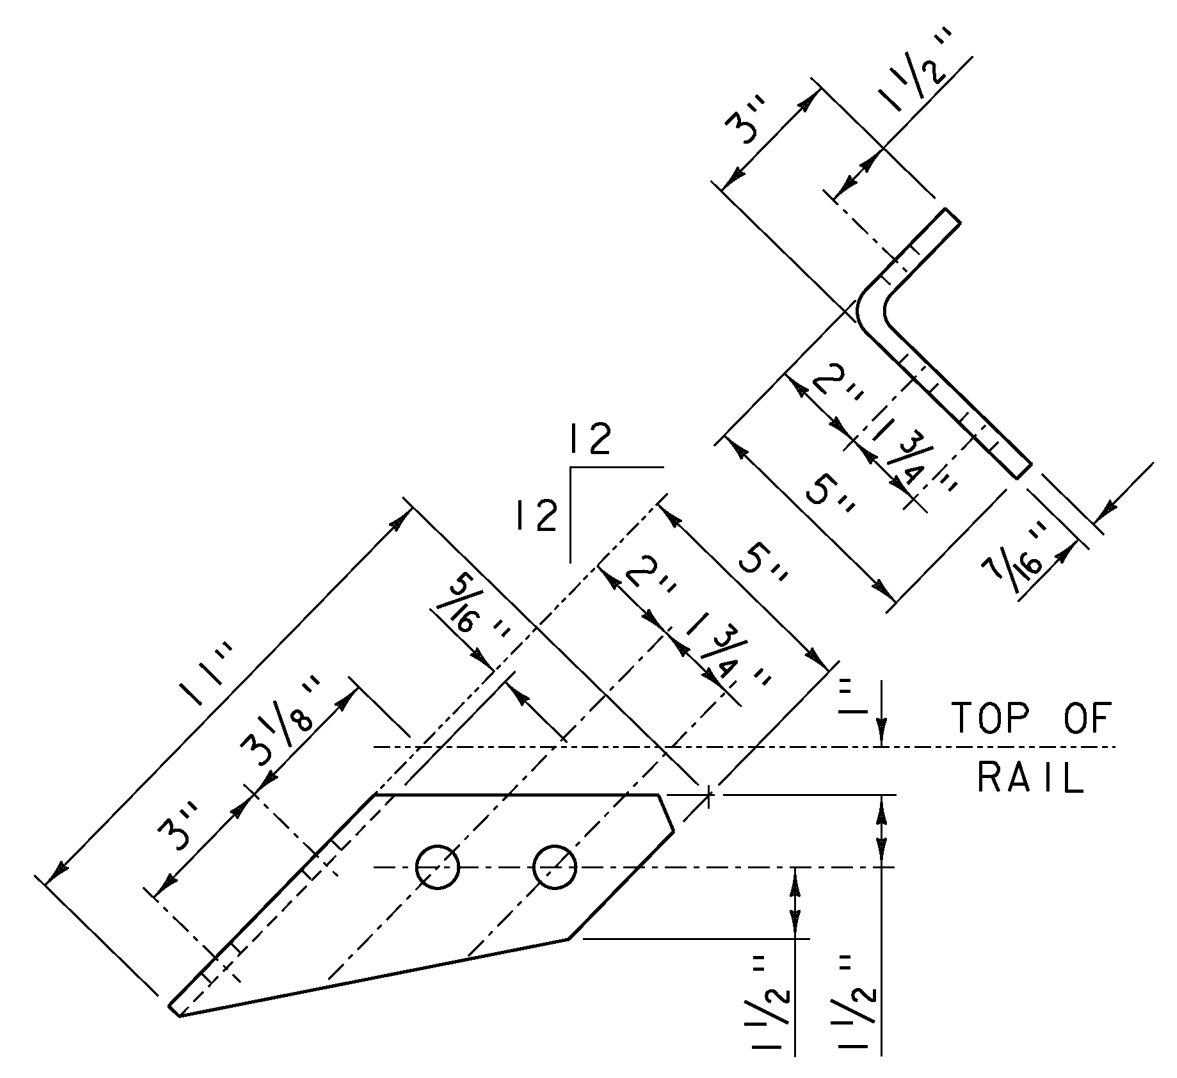

CONNECTOR PLATE 2CC
L 5x3x7/16 - 0'-11" LONG
SCALE 3" = 1'-0"

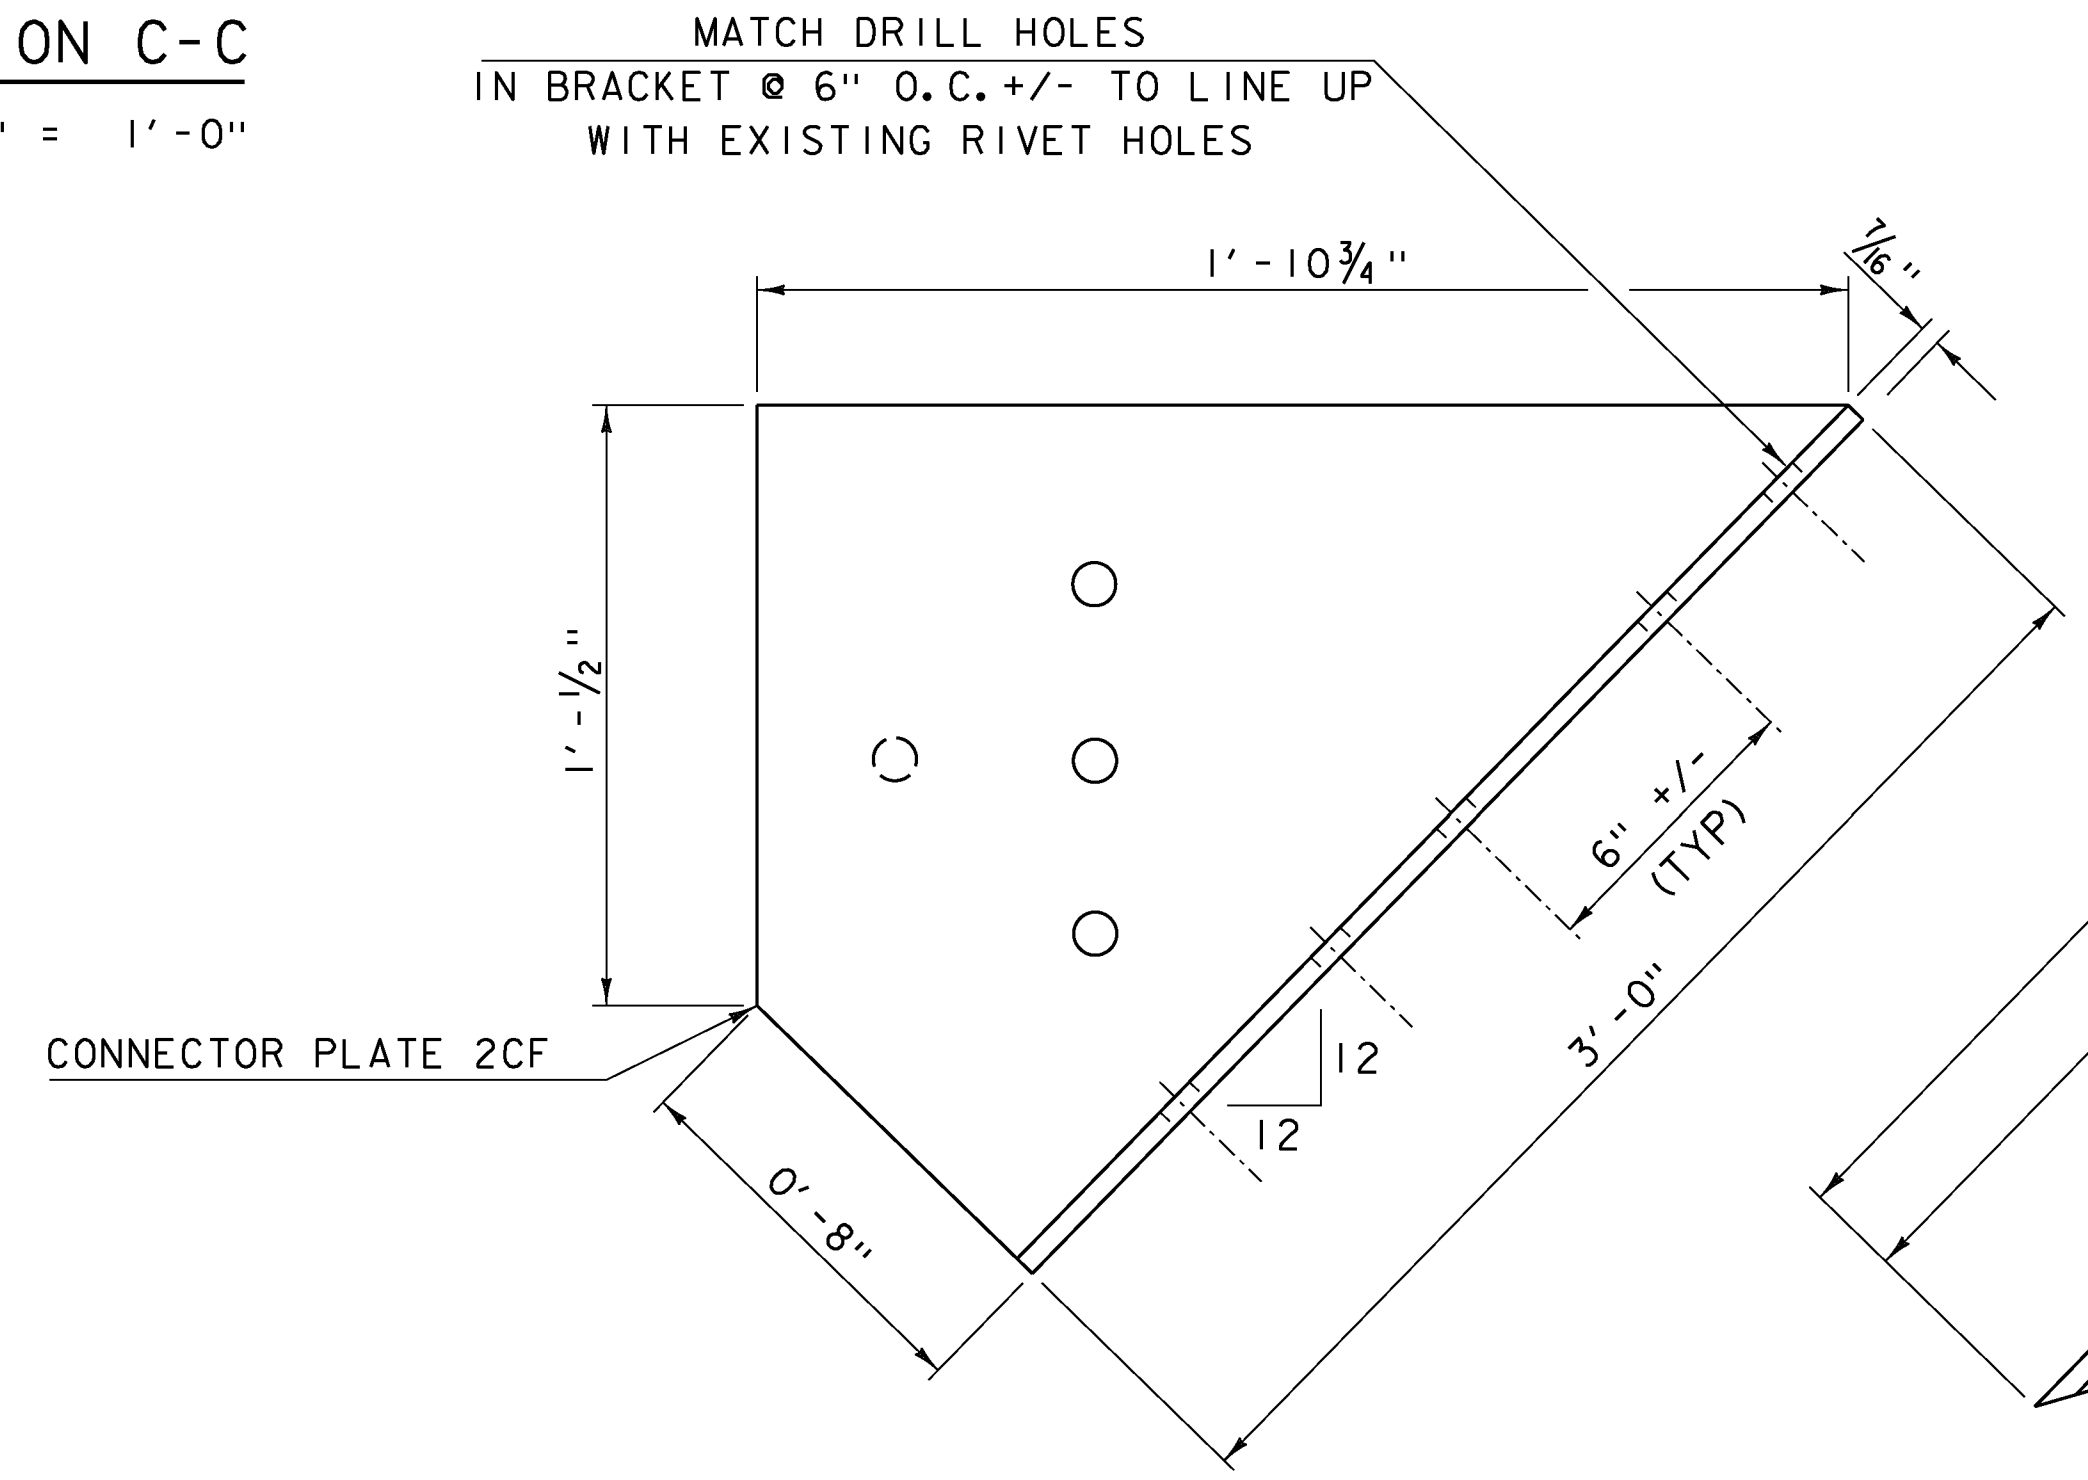

CONNECTOR PLATE 2CF
L 8x4 1/2 x 7/16 - 1'-10 1/2" LONG
SCALE 3" = 1'-0"

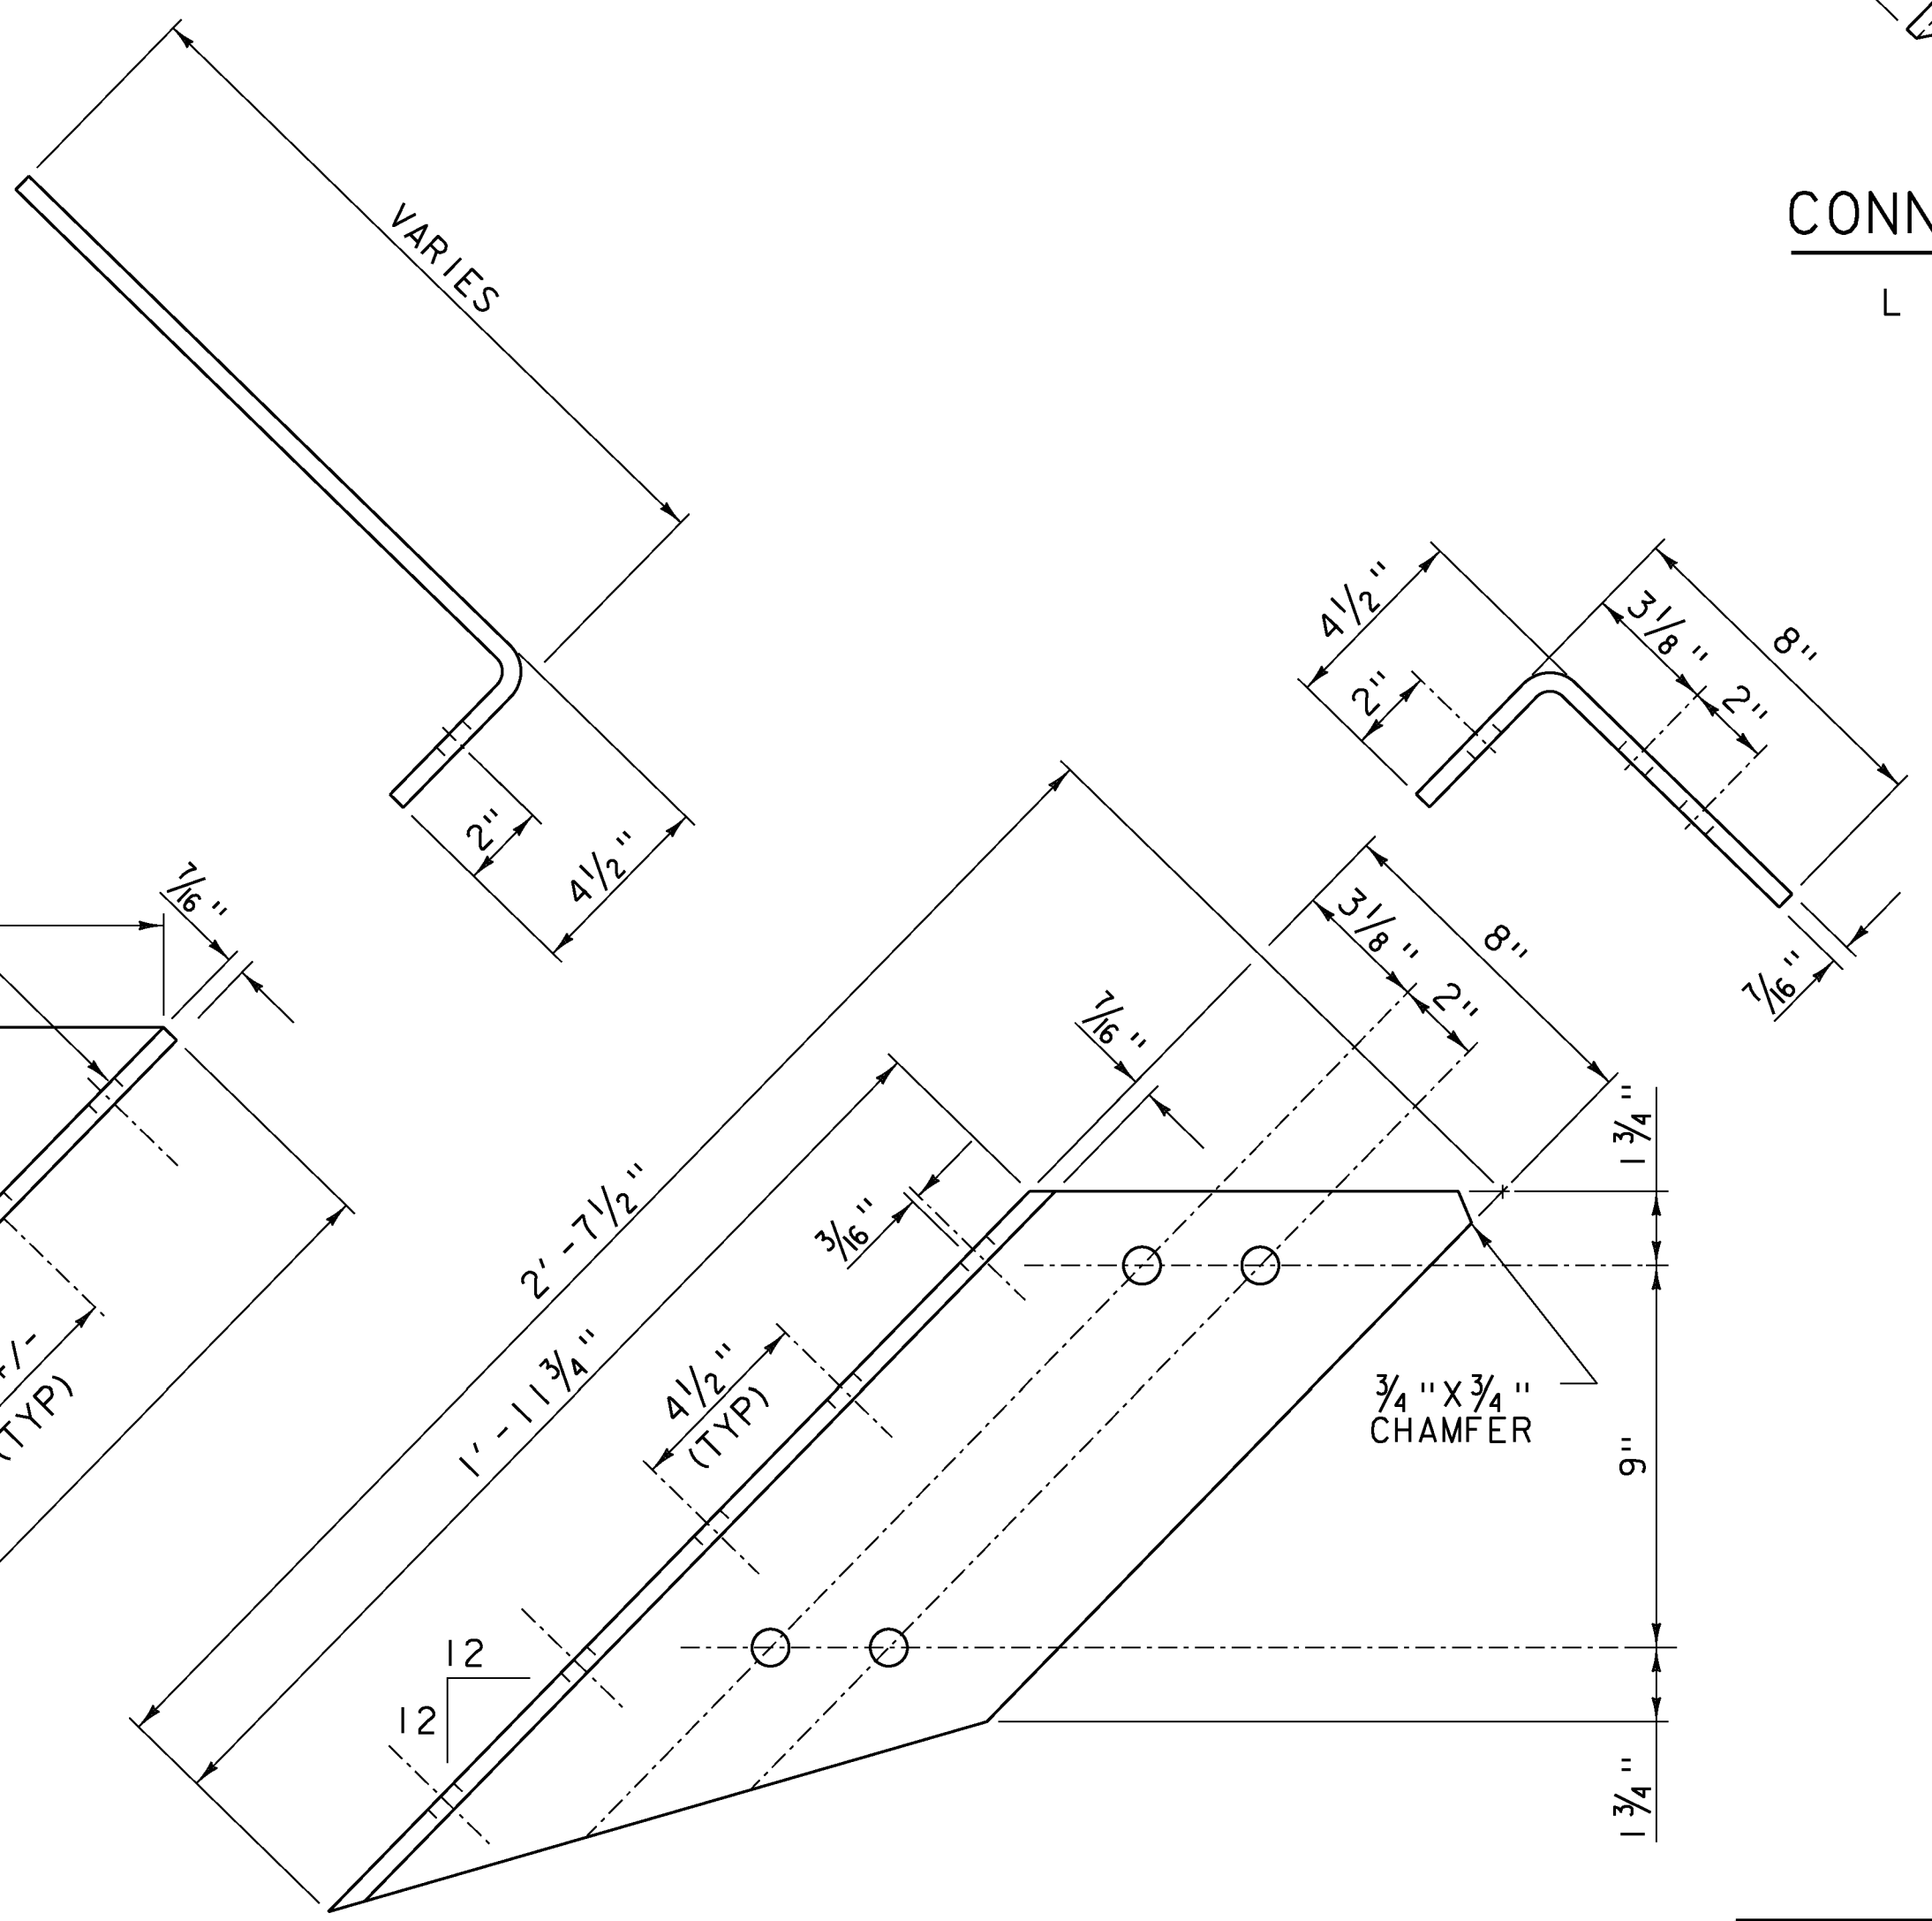

CONNECTOR PLATE 2CD
L 8x4 1/2 x 7/16 - 2'-7 1/2" LONG
SCALE 3" = 1'-0"

PROJECT NAME:	MONTPELIER	PLOT DATE:	5/12/2014
PROJECT NUMBER:	BF BPNT (17)	DRAWN BY:	L. BUXTON
FILE NAME:	z13j290framing.dgn	DESIGNED BY:	T. KNIGHT
PROJECT LEADER:	T. KNIGHT	CHECKED BY:	T. KNIGHT
RAILING DETAILS 3		SHEET	9 OF 16

