
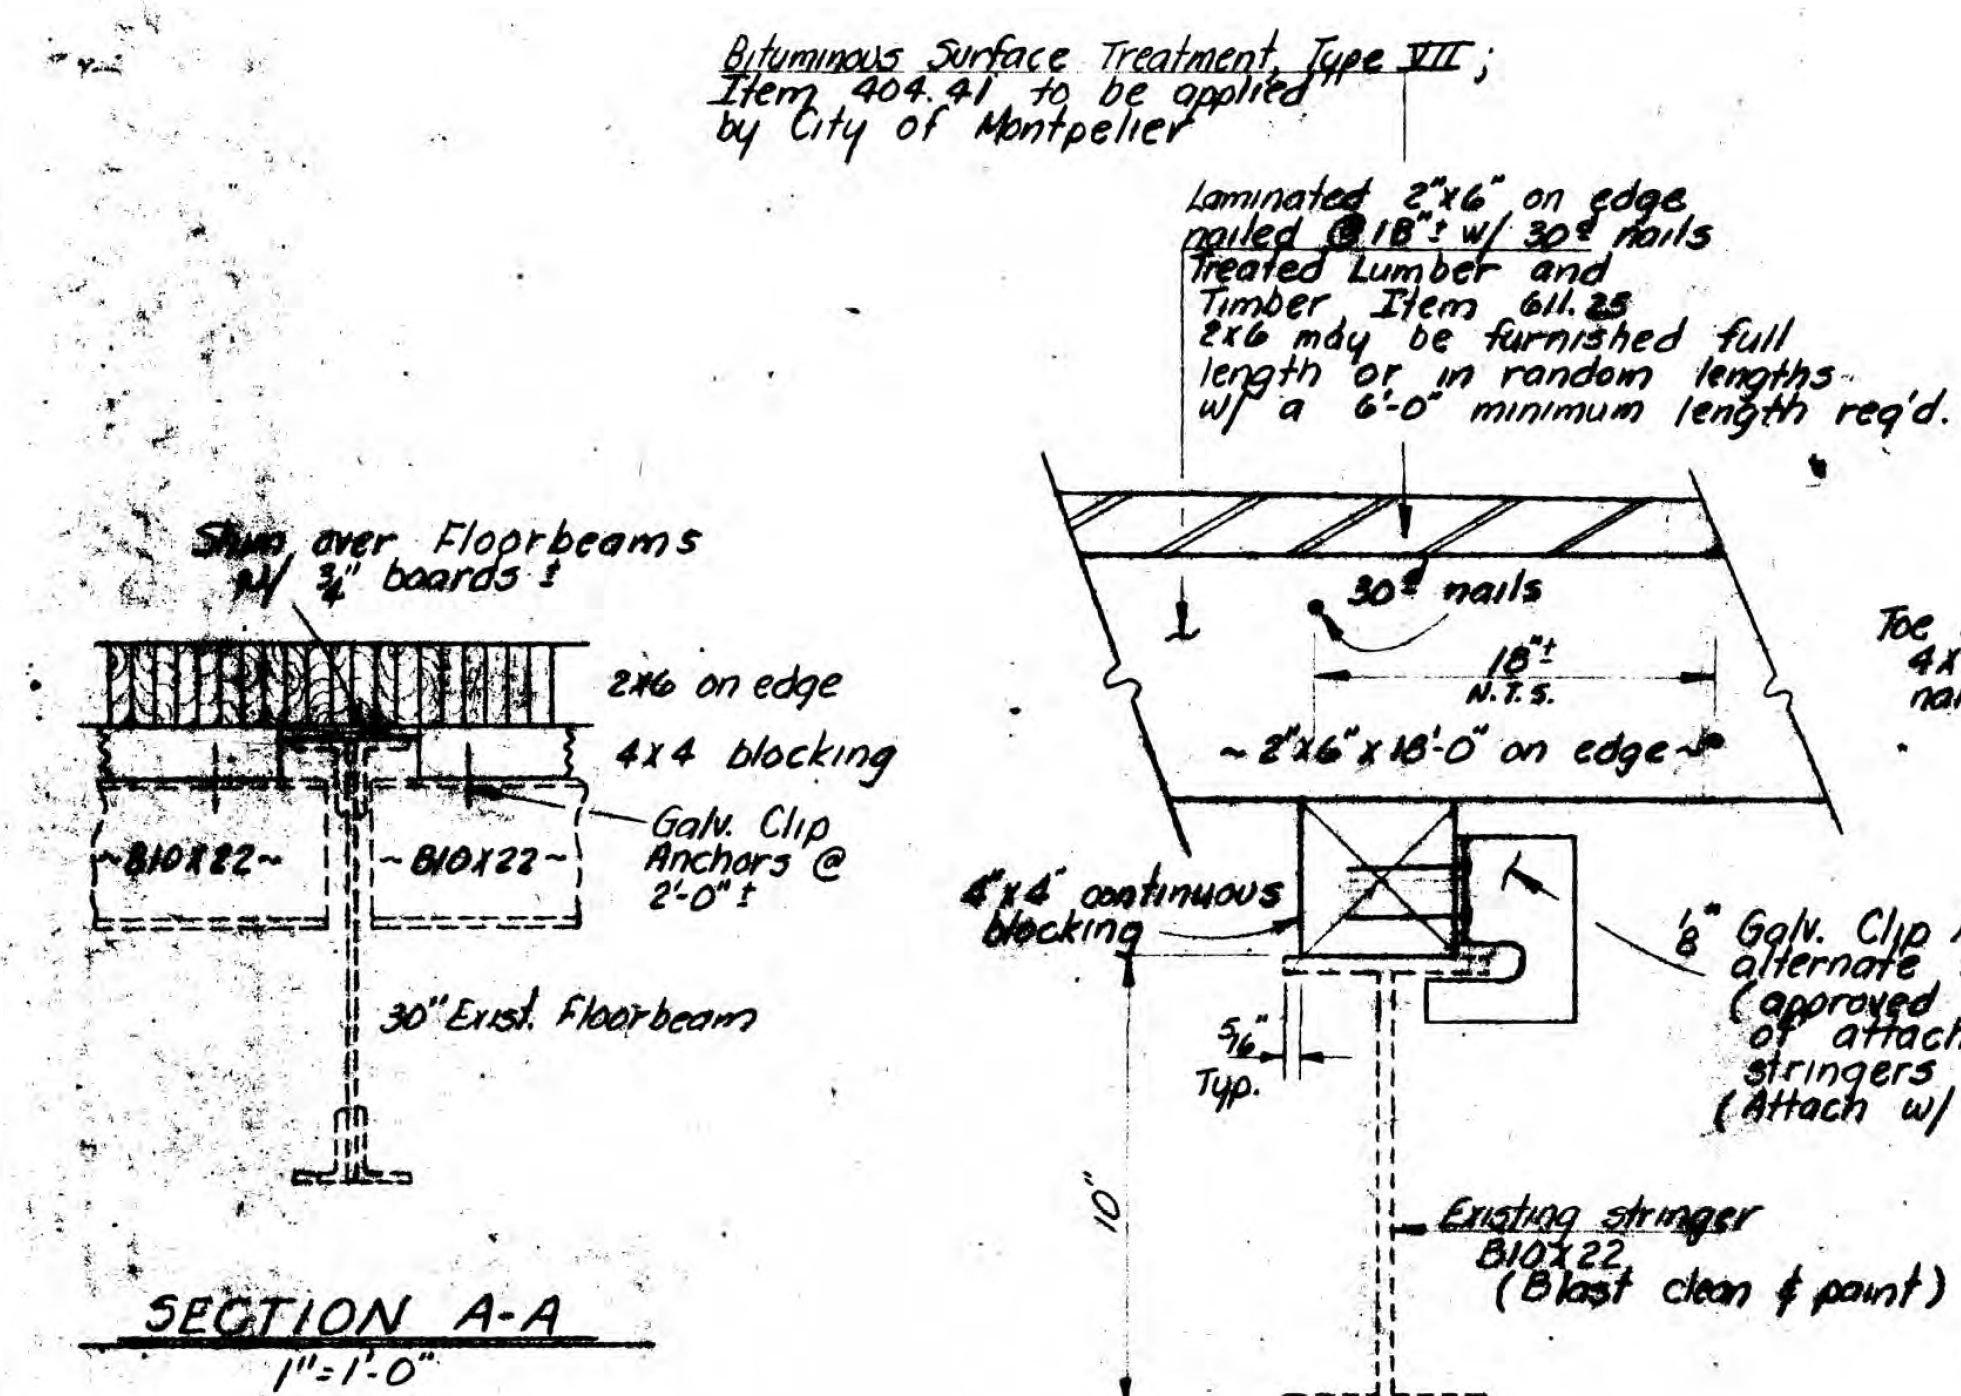


TYPICAL SECTION
3/8" = 1'-0"

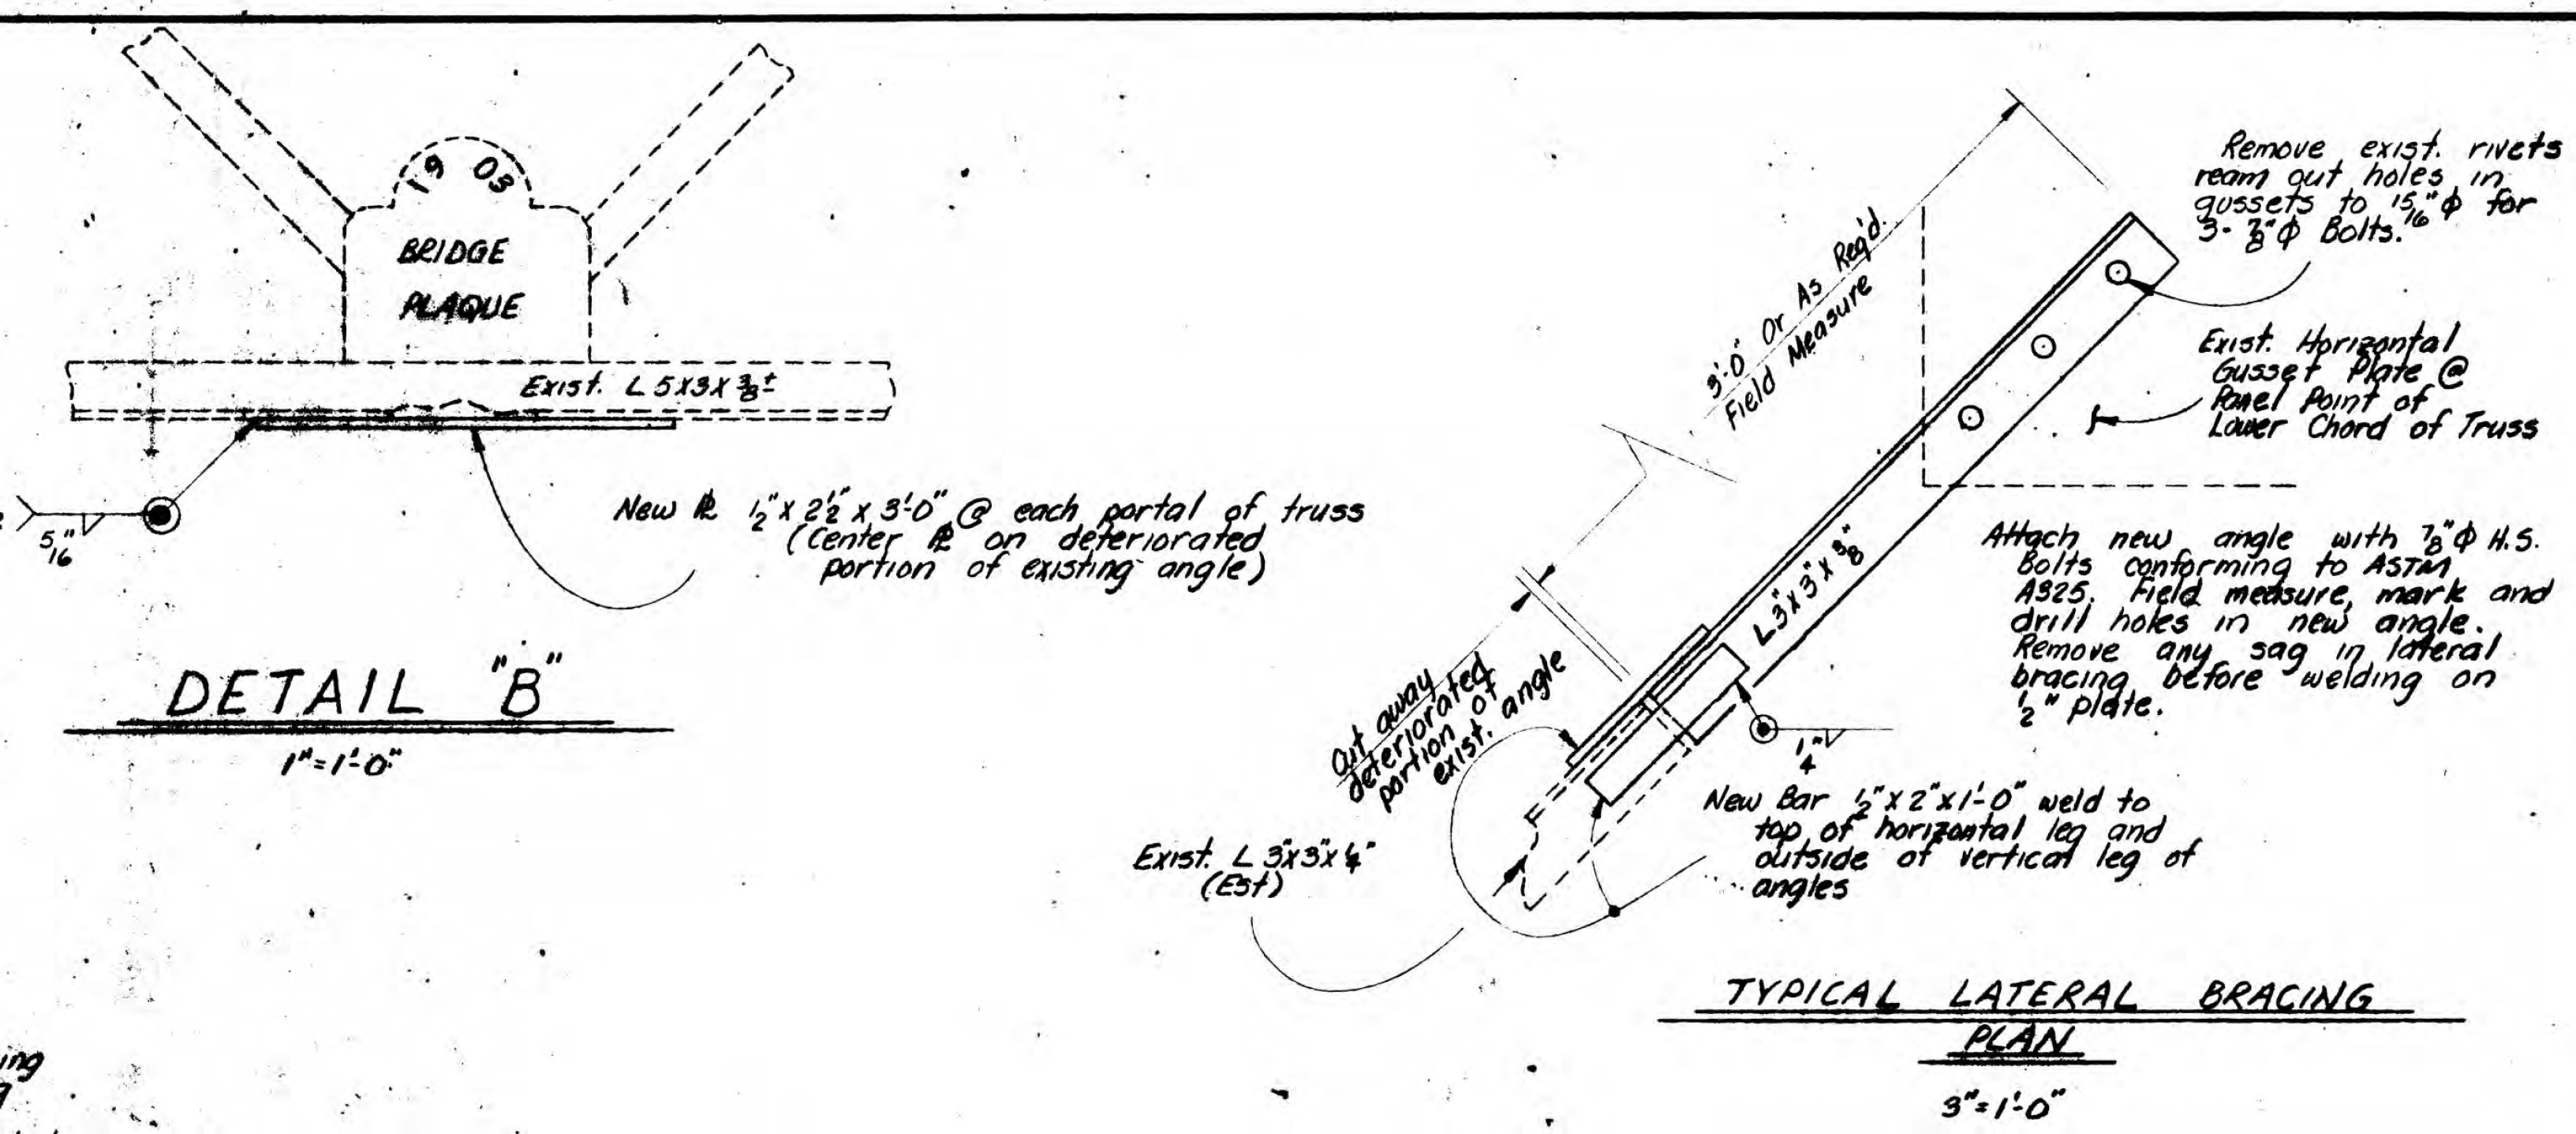

DETAIL A
1/5" = 1'-0"

**MONTPELIER
BF BPNT(17)
SHEET 15 OF 16
FOR REFERENCE ONLY**

STATE OF VERMONT DEPARTMENT OF HIGHWAYS	
TOWN OF MONTPELIER CITY	Bridge No. 17
HIGHWAY NO. GRANITE ST.	Log Sta. —
GRANITE STREET OVER WINDOSKI RIVER	Surv. Sta. —
SUPERSTRUCTURE DETAILS	
Designed by JARWOODSON	Drawn by JARWOODSON
Checked by J. Grenier date 6.74	Bridge Design Supervisor R.S. MAINT date 6/74
PROJECT MONTPELIER CITY	PROJECT NO. TH 3501
Bridge Sheet No. 3	Sheet 3 of 5