

STATE OF VERMONT AGENCY OF TRANSPORTATION




PROPOSED IMPROVEMENT STATEWIDE

COUNTIES OF ADDISON, BENNINGTON, CHITTENDEN, ESSEX,
LAMOILLE, ORANGE, WASHINGTON, WINDHAM, AND WINDSOR

LOCATIONS STATEWIDE ON VERMONT ROUTES 9, 11, 12, 100, 102, 108, 232,
244, U.S. ROUTES 2, 5, 7, INTERSTATE 89, AND NEWBURY STATE HIGHWAY.

WORK TO BE PERFORMED UNDER THIS PROJECT INCLUDES THE REMOVAL OF
EXISTING WEATHERED GUARDRAIL, THE INSTALLATION OF NEW GALVANIZED
GUARDRAIL, AND OTHER HIGHWAY RELATED ITEMS. WORK ALSO INCLUDES THE
INSTALLATION OF FIVE EXPERIMENTAL MTS END TERMINALS.

ROUTE	TOWN	LF	MILES
NEWBURY ST. HIGHWAY	NEWBURY	475	0.090
US 5	BRATTLEBORO	337.5	0.064
VT 9	WOODFORD	600	0.114
VT 11	PERU	9325	1.766
VT 11	WINHALL	11336	2.147
VT 12	BARNARD	17512.5	3.317
VT 12	BETHEL	2975	0.563
VT 12	POMFRET	3505.5	0.664
VT 12	WOODSTOCK	7425	1.406
VT 100	GRANVILLE	2237.5	0.424
VT 100	MORRISVILLE VILLAGE	800	0.152
VT 102	LEMINGTON	137.5	0.026
VT 108	STOWE	162.5	0.031
VT 232	MARSHFIELD	675	0.128
VT 244	THETFORD	766	0.145
PROJECT TOTAL		58270.0	11.036

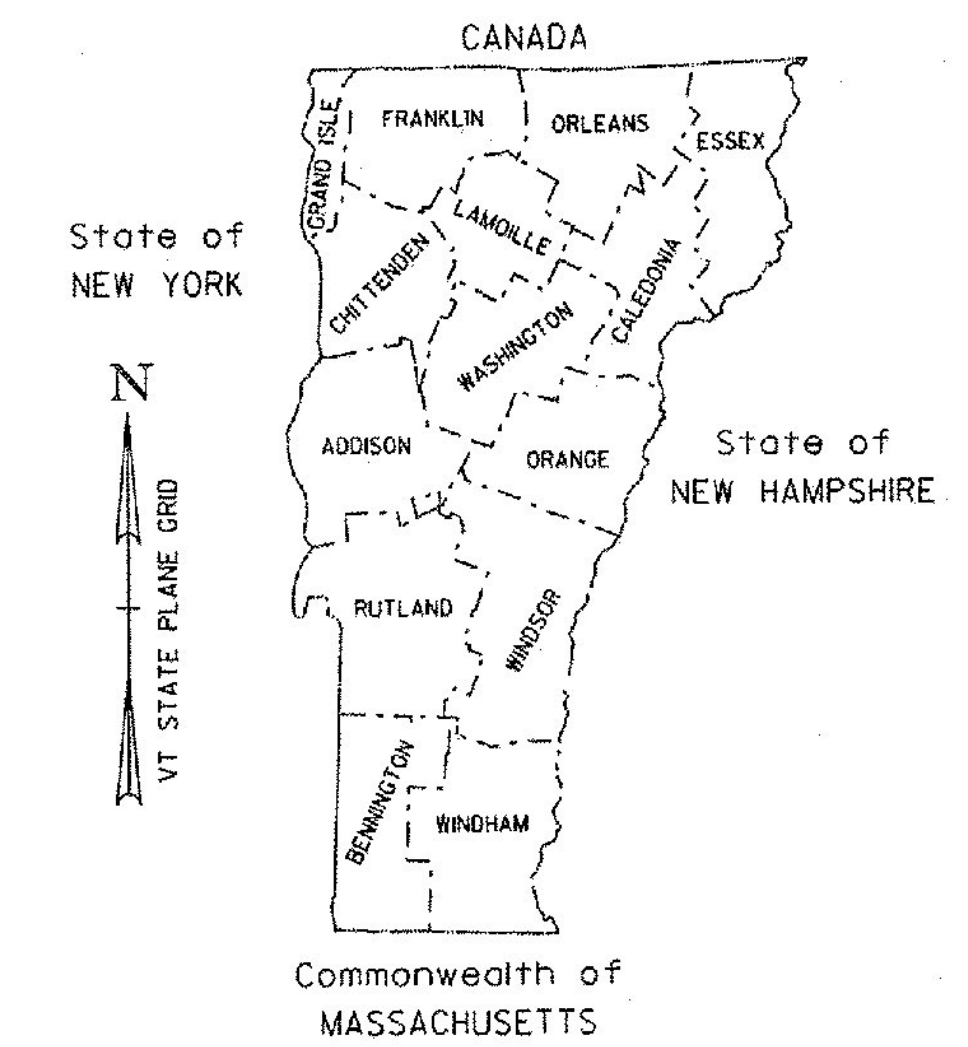

RECORD PLANS	
CONTRACTOR:	F. R. LAFAYETTE, INC. - ESSEX JUNCTION, VT
RESIDENT ENGINEER:	TIM POCKETT
CONSTRUCTION BEGAN:	OCTOBER 13, 2015
CONSTRUCTION COMPLETE:	NOVEMBER 14, 2016
RECORD PLANS BY:	TIM POCKETT & JESSE IVES
I HEREBY CERTIFY THAT ALL THE CONSTRUCTION REQUIRED BY THIS SET OF DRAWINGS HAS BEEN ACCOMPLISHED AS INDICATED HEREIN.	
BY	RESIDENT ENGINEER
DATE	04/06/17
NOTE: Any further information concerning final quantities, amounts or other details relative to this project may be found by contacting Vtrans Records Management.	

CONSTRUCTION IS TO BE CARRIED ON IN ACCORDANCE WITH THESE PLANS AND THE STANDARD SPECIFICATIONS FOR CONSTRUCTION DATED 2011, AS APPROVED BY THE FEDERAL HIGHWAY ADMINISTRATION ON JULY 20, 2011 FOR USE ON THIS PROJECT, INCLUDING ALL SUBSEQUENT REVISIONS AND SUCH REVISED SPECIFICATIONS AND SPECIAL PROVISIONS AS ARE INCORPORATED IN THESE PLANS.

QUALITY ASSURANCE PROGRAM : LEVEL I	
SURVEYED BY :	N/A
SURVEYED DATE :	N/A
DATUM	
VERTICAL	N/A
HORIZONTAL	N/A

DIRECTOR OF PROJECT DELIVERY	
APPROVED	DATE 3/20/2015
PROJECT MANAGER : BRUCE MARTIN, P.E.	
PROJECT NAME : STATEWIDE	
PROJECT NUMBER : HES GARD (2)	
SHEET 1 OF 21 SHEETS	