



# GRANVILLE

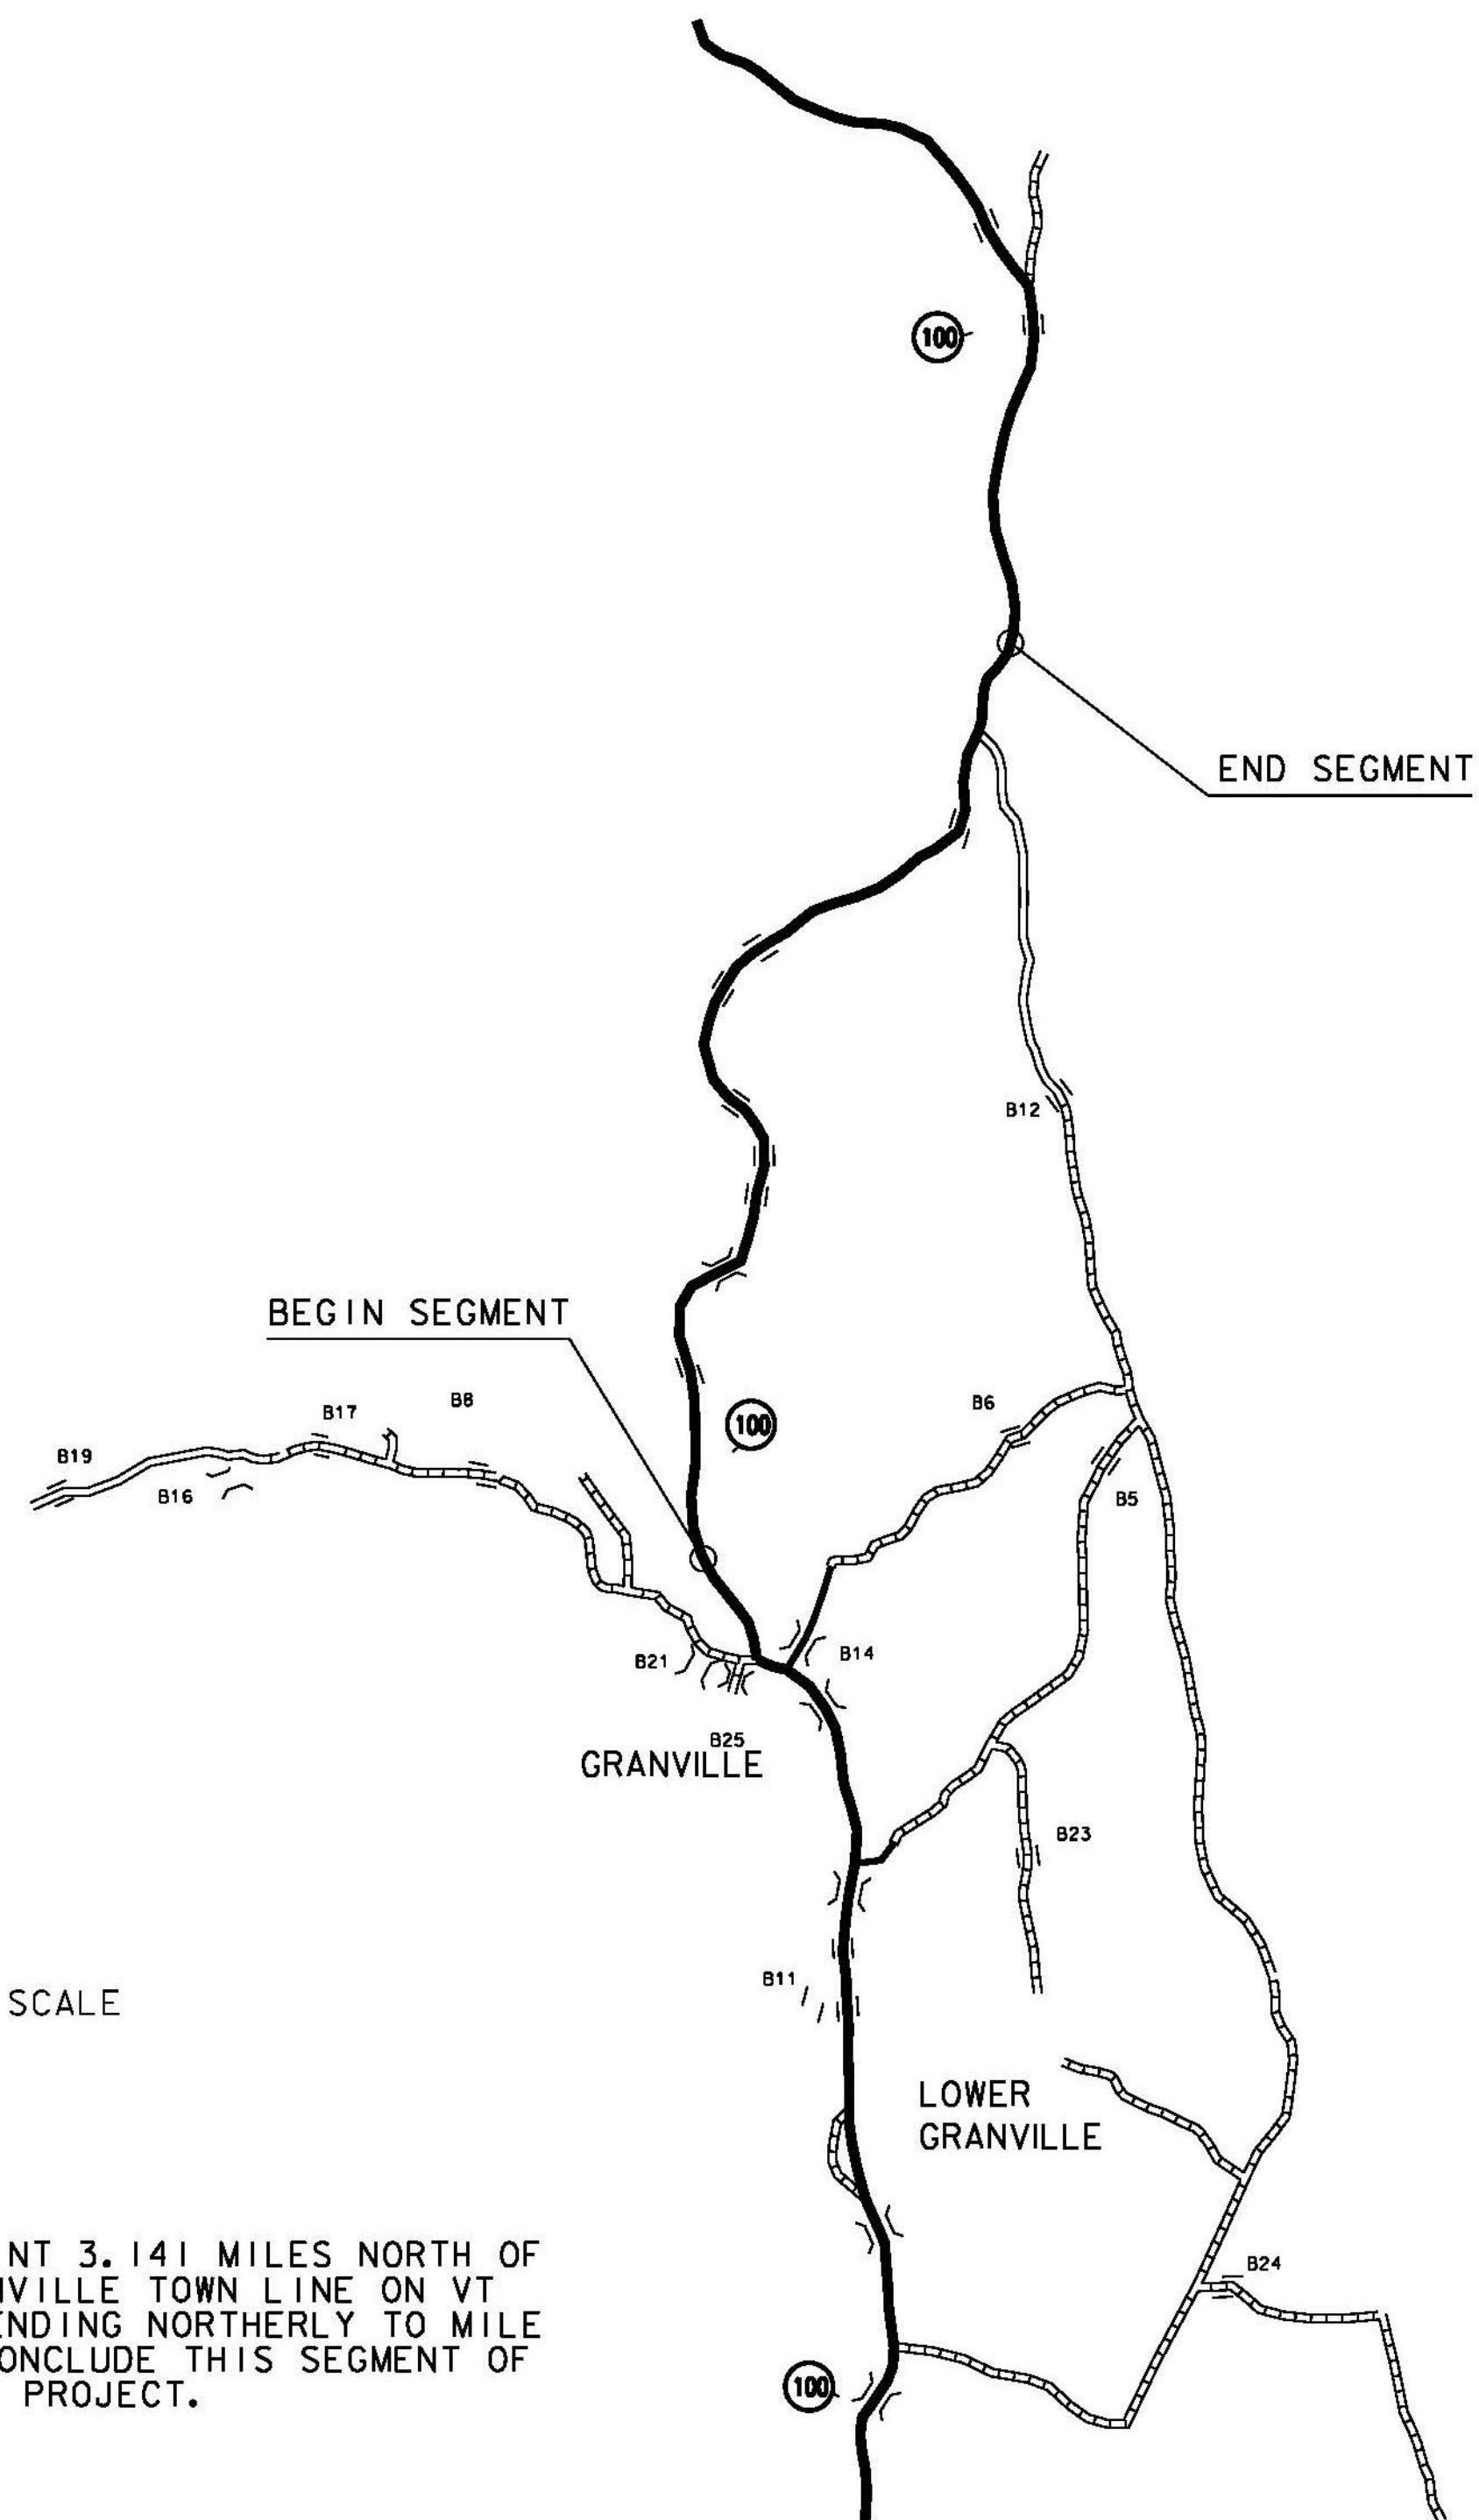

NOT TO SCALE

BEGINNING AT A POINT 3.141 MILES NORTH OF THE HANCOCK GRANVILLE TOWN LINE ON VT ROUTE 100 AND EXTENDING NORTHERLY TO MILE MARKER 8.517 TO CONCLUDE THIS SEGMENT OF THE PROJECT.

# MORRISVILLE VILLAGE

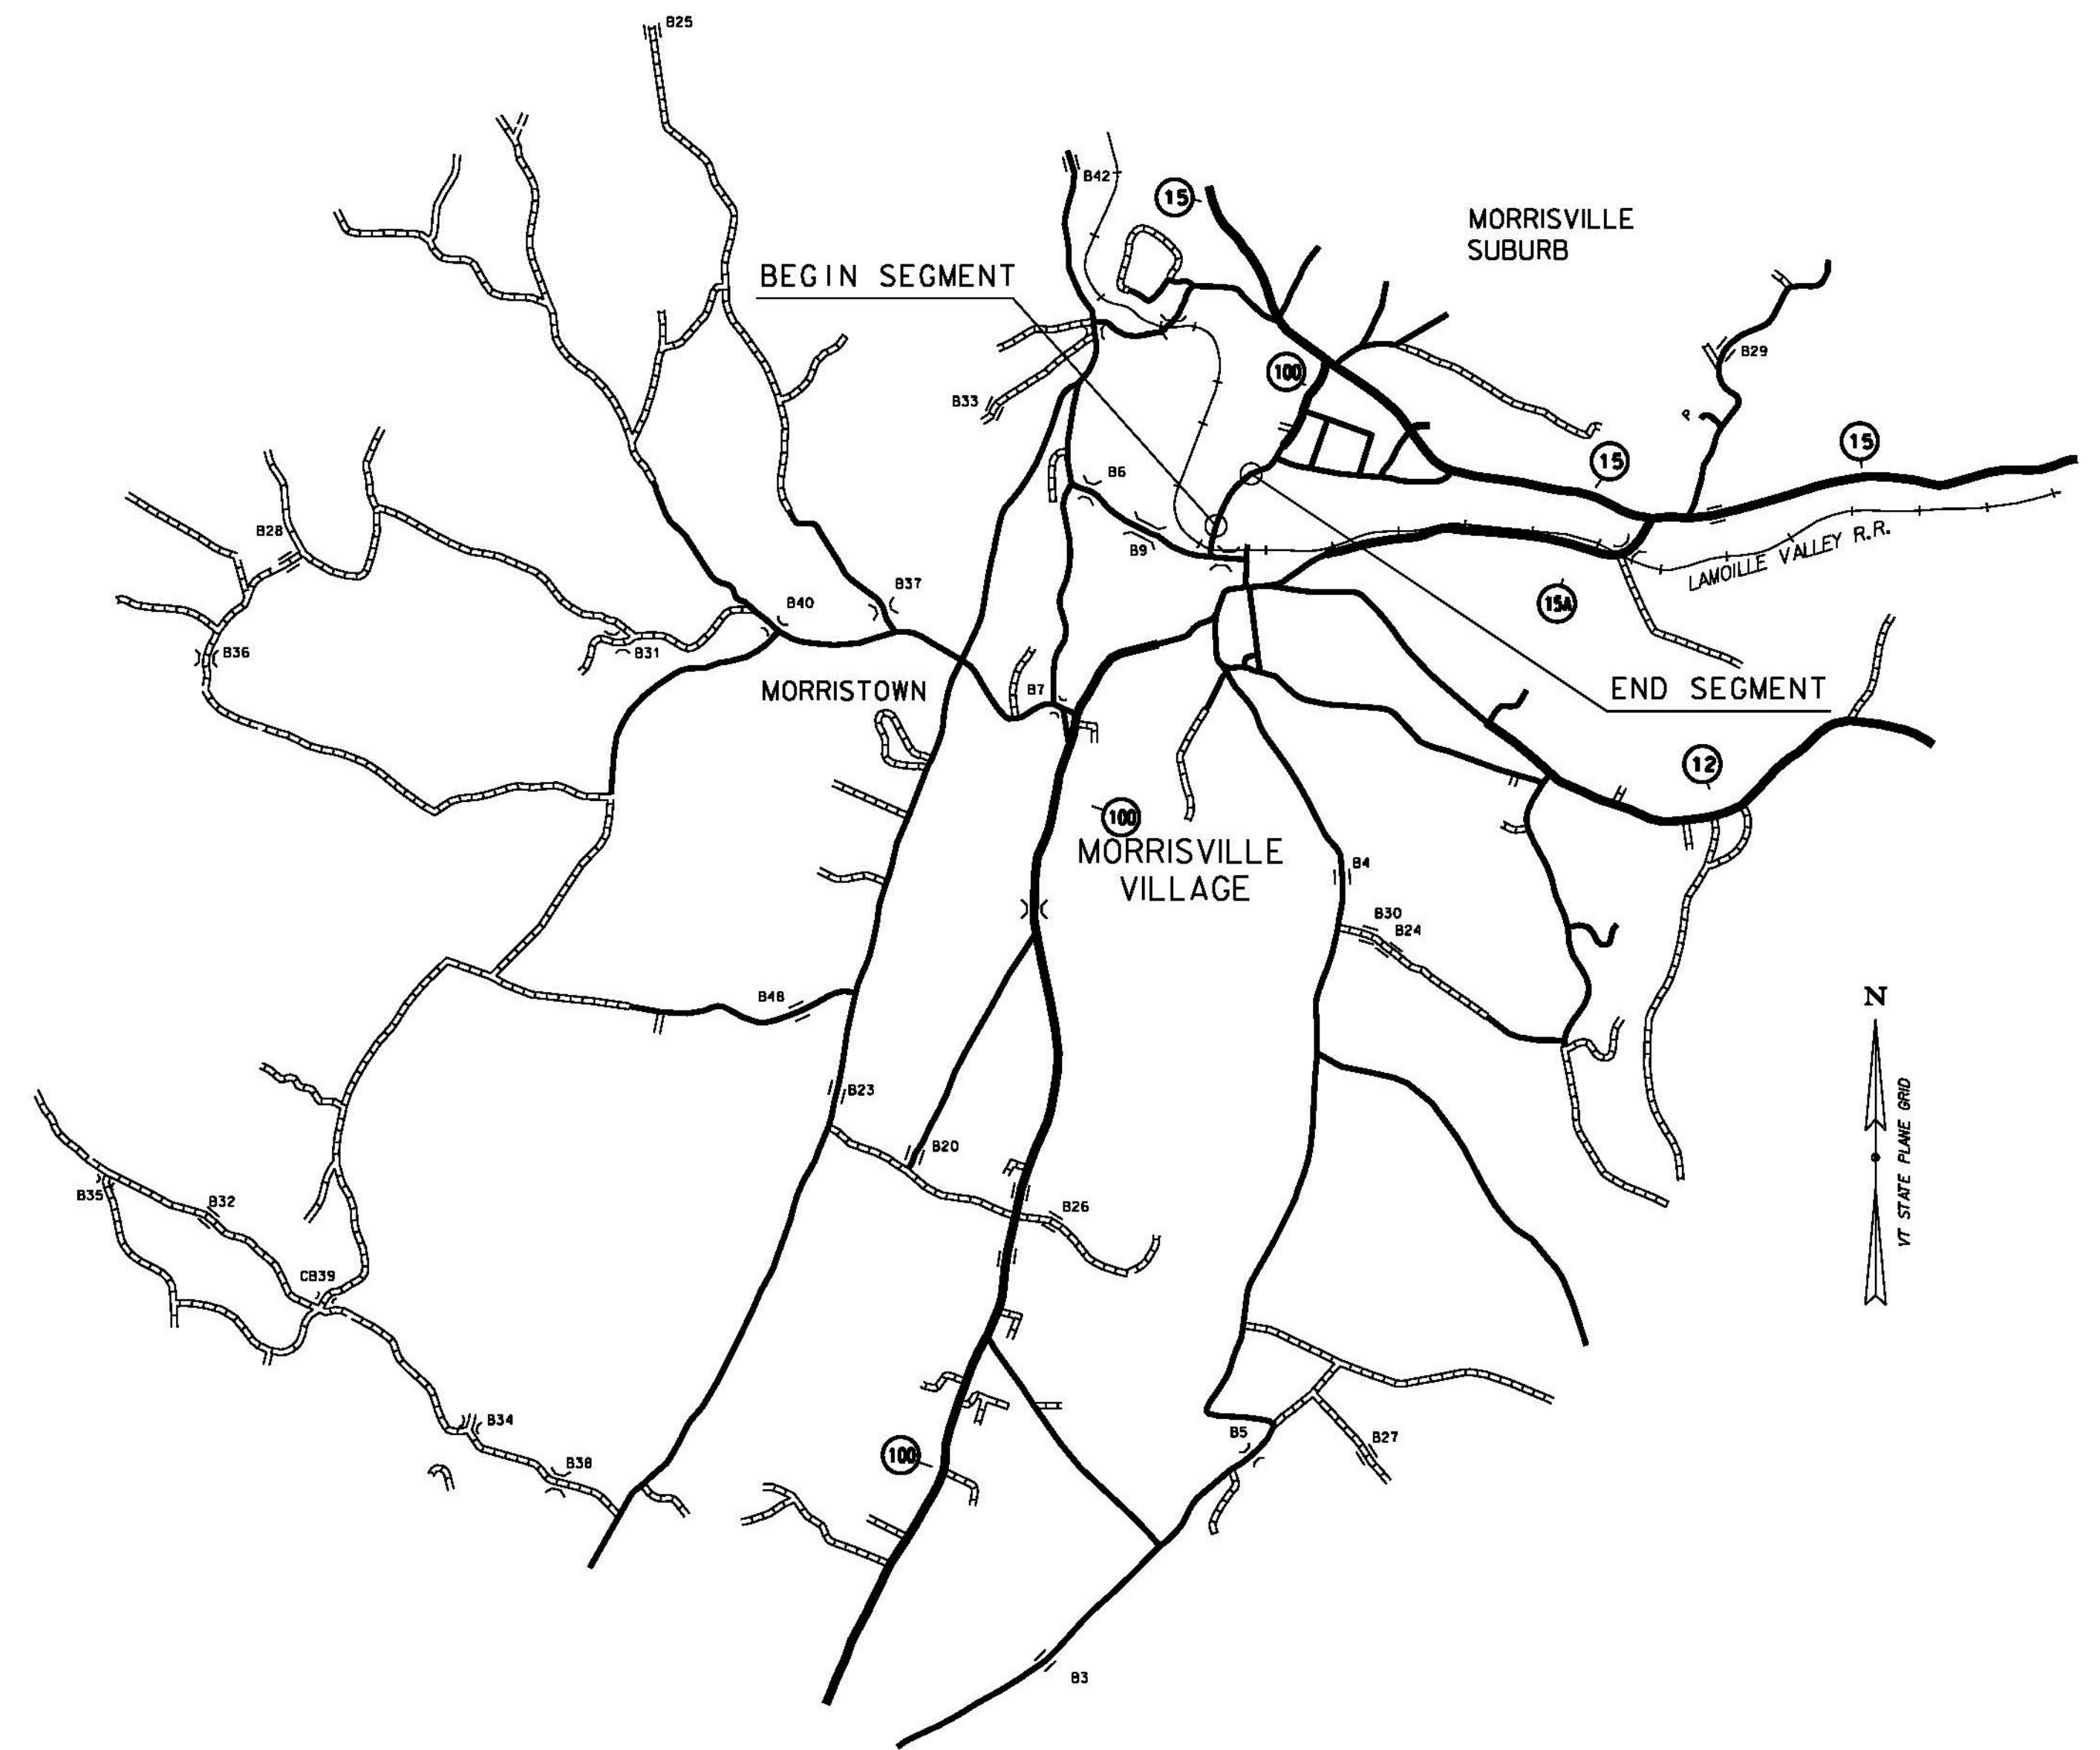

NOT TO SCALE

BEGINNING AT A POINT 5.848 MILES NORTH OF THE STOWE MORRISTOWN TOWN LINE ON VT ROUTE 100 AND EXTENDING NORTHERLY IN MORRISVILLE VILLAGE TO MILE MARKER 5.999 TO CONCLUDE THIS SEGMENT OF THE PROJECT.

PROJECT NAME:	STATEWIDE
PROJECT NUMBER:	HES GARD(2)
FILE NAME:	I3k342maps.dgn
PROJECT LEADER:	B. MARTIN
DESIGNED BY:	M. GAMELIN
LOCATION MAP SHEET	6
PLOT DATE:	27-MAR-2015
DRAWN BY:	M. GAMELIN
CHECKED BY:	A. KEMPTON
SHEET	18 OF 21