

**BEGIN R.O.W. PROJECT
STP WKZN (9) C/2
STA. 3+11.68 38.93' RT**

**1
OPUS MINOR, LLC**

**2
TOP NOTCH PROPERTIES, LLC**

**END R.O.W. PROJECT
STP WKZN (9) C/2
STA. 4+89.22 30.95' LT**

REMOVE EXISTING PAVEMENT
AND PLACE TOPSOIL, FERTILIZER,
SEED AND MULCH


SAWCUTTING JOINT TO BE PAID
INCIDENTAL TO EXCAVATION OF
SURFACES AND PAVEMENTS

EXCAVATION OF SURFACES AND PAVEMENTS
STA 3+22.7 RT - STA 3+60.1 RT

CONSTRUCT NEW 24'
COMMERCIAL DRIVE
STA. 63+66.00

ALL DRIVES AS INDICATED ON PLANS
ARE SUBJECT TO PERMITS PURSUANT
TO TITLE 19 V.S.A. § 1111.

LINES SHOWN ON THIS PLAN AS EXISTING
PROPERTY LINES P/L ARE BELIEVED TO
BE ACCURATE BUT SHOULD NOT BE RELIED
UPON FOR PURPOSES UNRELATED TO THE
STATE OF VERMONT'S ACQUISITION OF LAND
AND RIGHTS FOR THIS PROJECT.

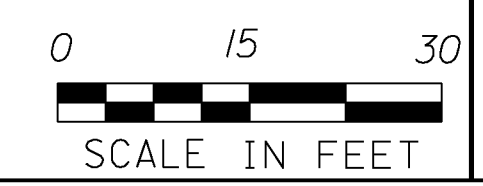

PROJECT NAME:	WATERBURY AREA	PLOT DATE:	10/21/2014
PROJECT NUMBER:	STP WKZN (9) C/2	DRAWN BY:	J. BLANCHARD
FILE NAME:	I3k670lay.dgn	DESIGNED BY:	B. NYQUIST
PROJECT LEADER:	P. COBURN	R.O.W. LAYOUT SHEET	CHECKED BY: R. CLOUTIER
			SHEET 5 OF 13

