

RECORD PLANS

Robert Suckert

Prime Contractor: Dirt Tech Company, LLC

Project Start Date: 5/26/16

Project Completion Date: 9/22/16




STATE OF VERMONT AGENCY OF TRANSPORTATION




PROPOSED ROUNDABOUT IMPROVEMENTS TOWN OF HYDE PARK COUNTY OF LAMOILLE VT 15 & VT 100 - MINOR ARTERIALS

BEGINNING AT A POINT ON VT ROUTE 15, IN THE TOWN OF HYDE PARK, APPROXIMATELY 157.03 FEET (MM 1.796) WEST OF THE INTERSECTION OF VT ROUTE 15, VT ROUTE 100 AND TOWN HIGHWAY #5, AND EXTENDING EAST APPROXIMATELY 300.00 FEET (MM 1.852). ALSO BEGINNING AT A POINT 159.48 FEET SOUTH OF THE INTERSECTION ON T.H. 5 AND EXTENDING TO A POINT 150.53 FEET NORTH OF THE INTERSECTION ON VT ROUTE 100.

WORK TO BE PERFORMED UNDER THIS PROJECT INCLUDES RECONSTRUCTION OF A ROUNDABOUT TRUCK APRON, TEMPORARY ROAD WIDENING AND OTHER HIGHWAY RELATED ITEMS.

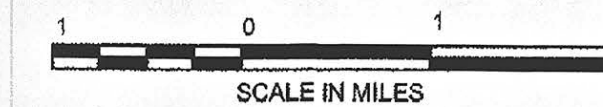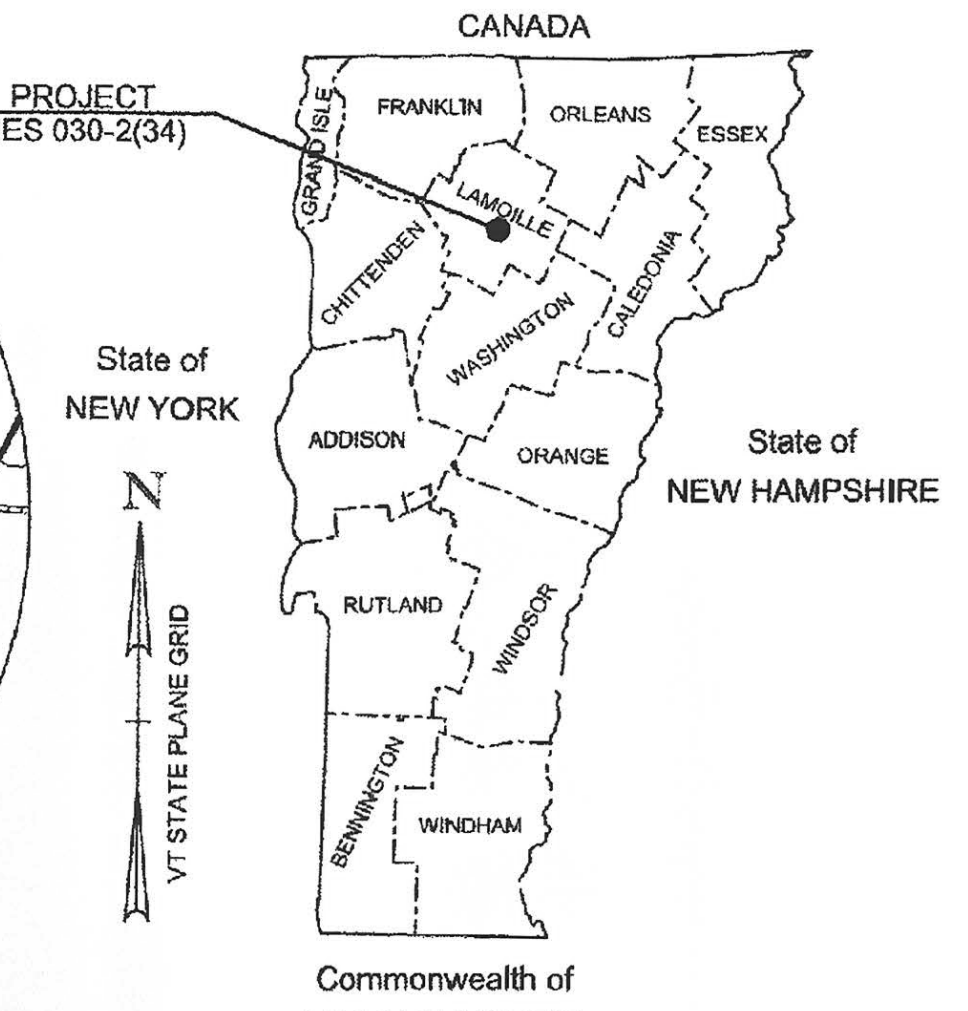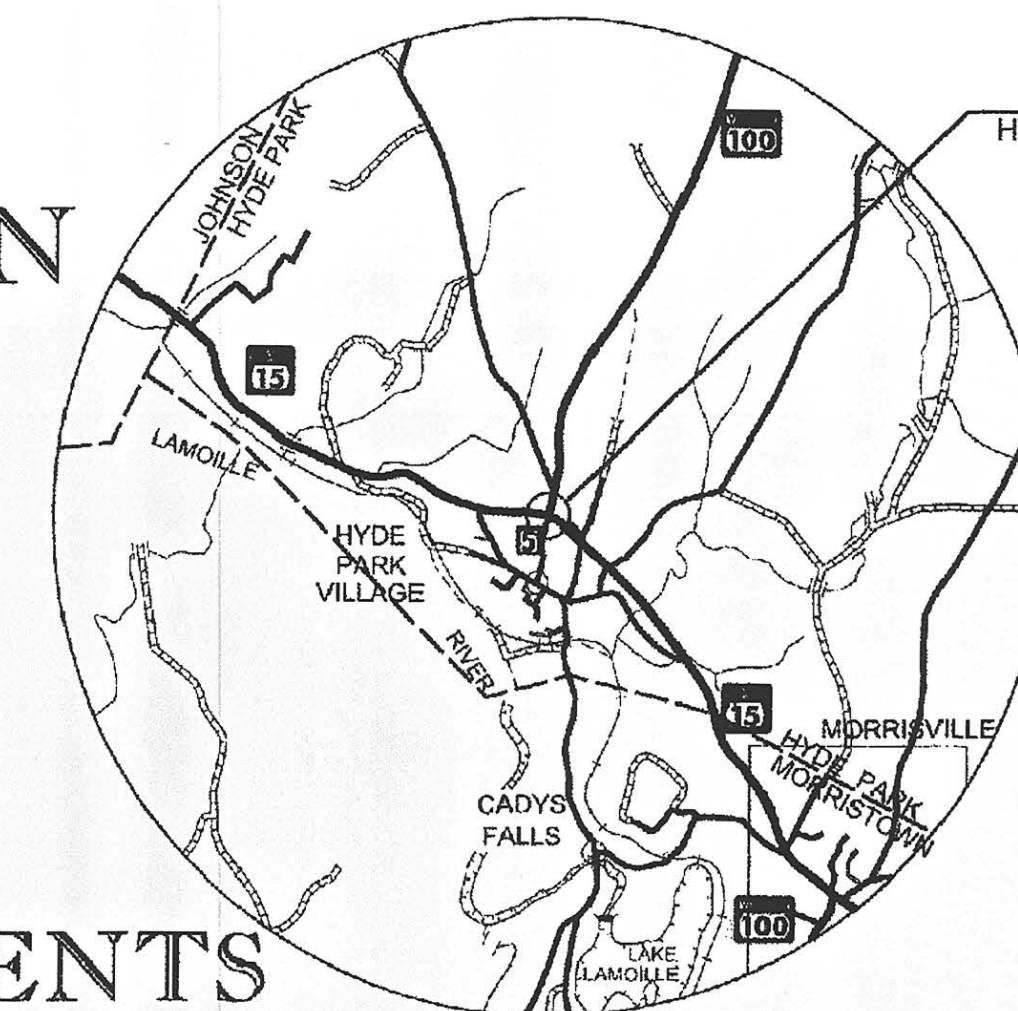

LENGTH OF PROJECT:
VT ROUTE 15 = 300.00 FT = 0.057 MILES
VT ROUTE 100 = 150.53 FT = 0.029 MILES
T.H. 5 = 159.48 FT = 0.030 MILES
TOTAL LENGTH OF PROJECT = 610.01 FT = 0.116 MILES

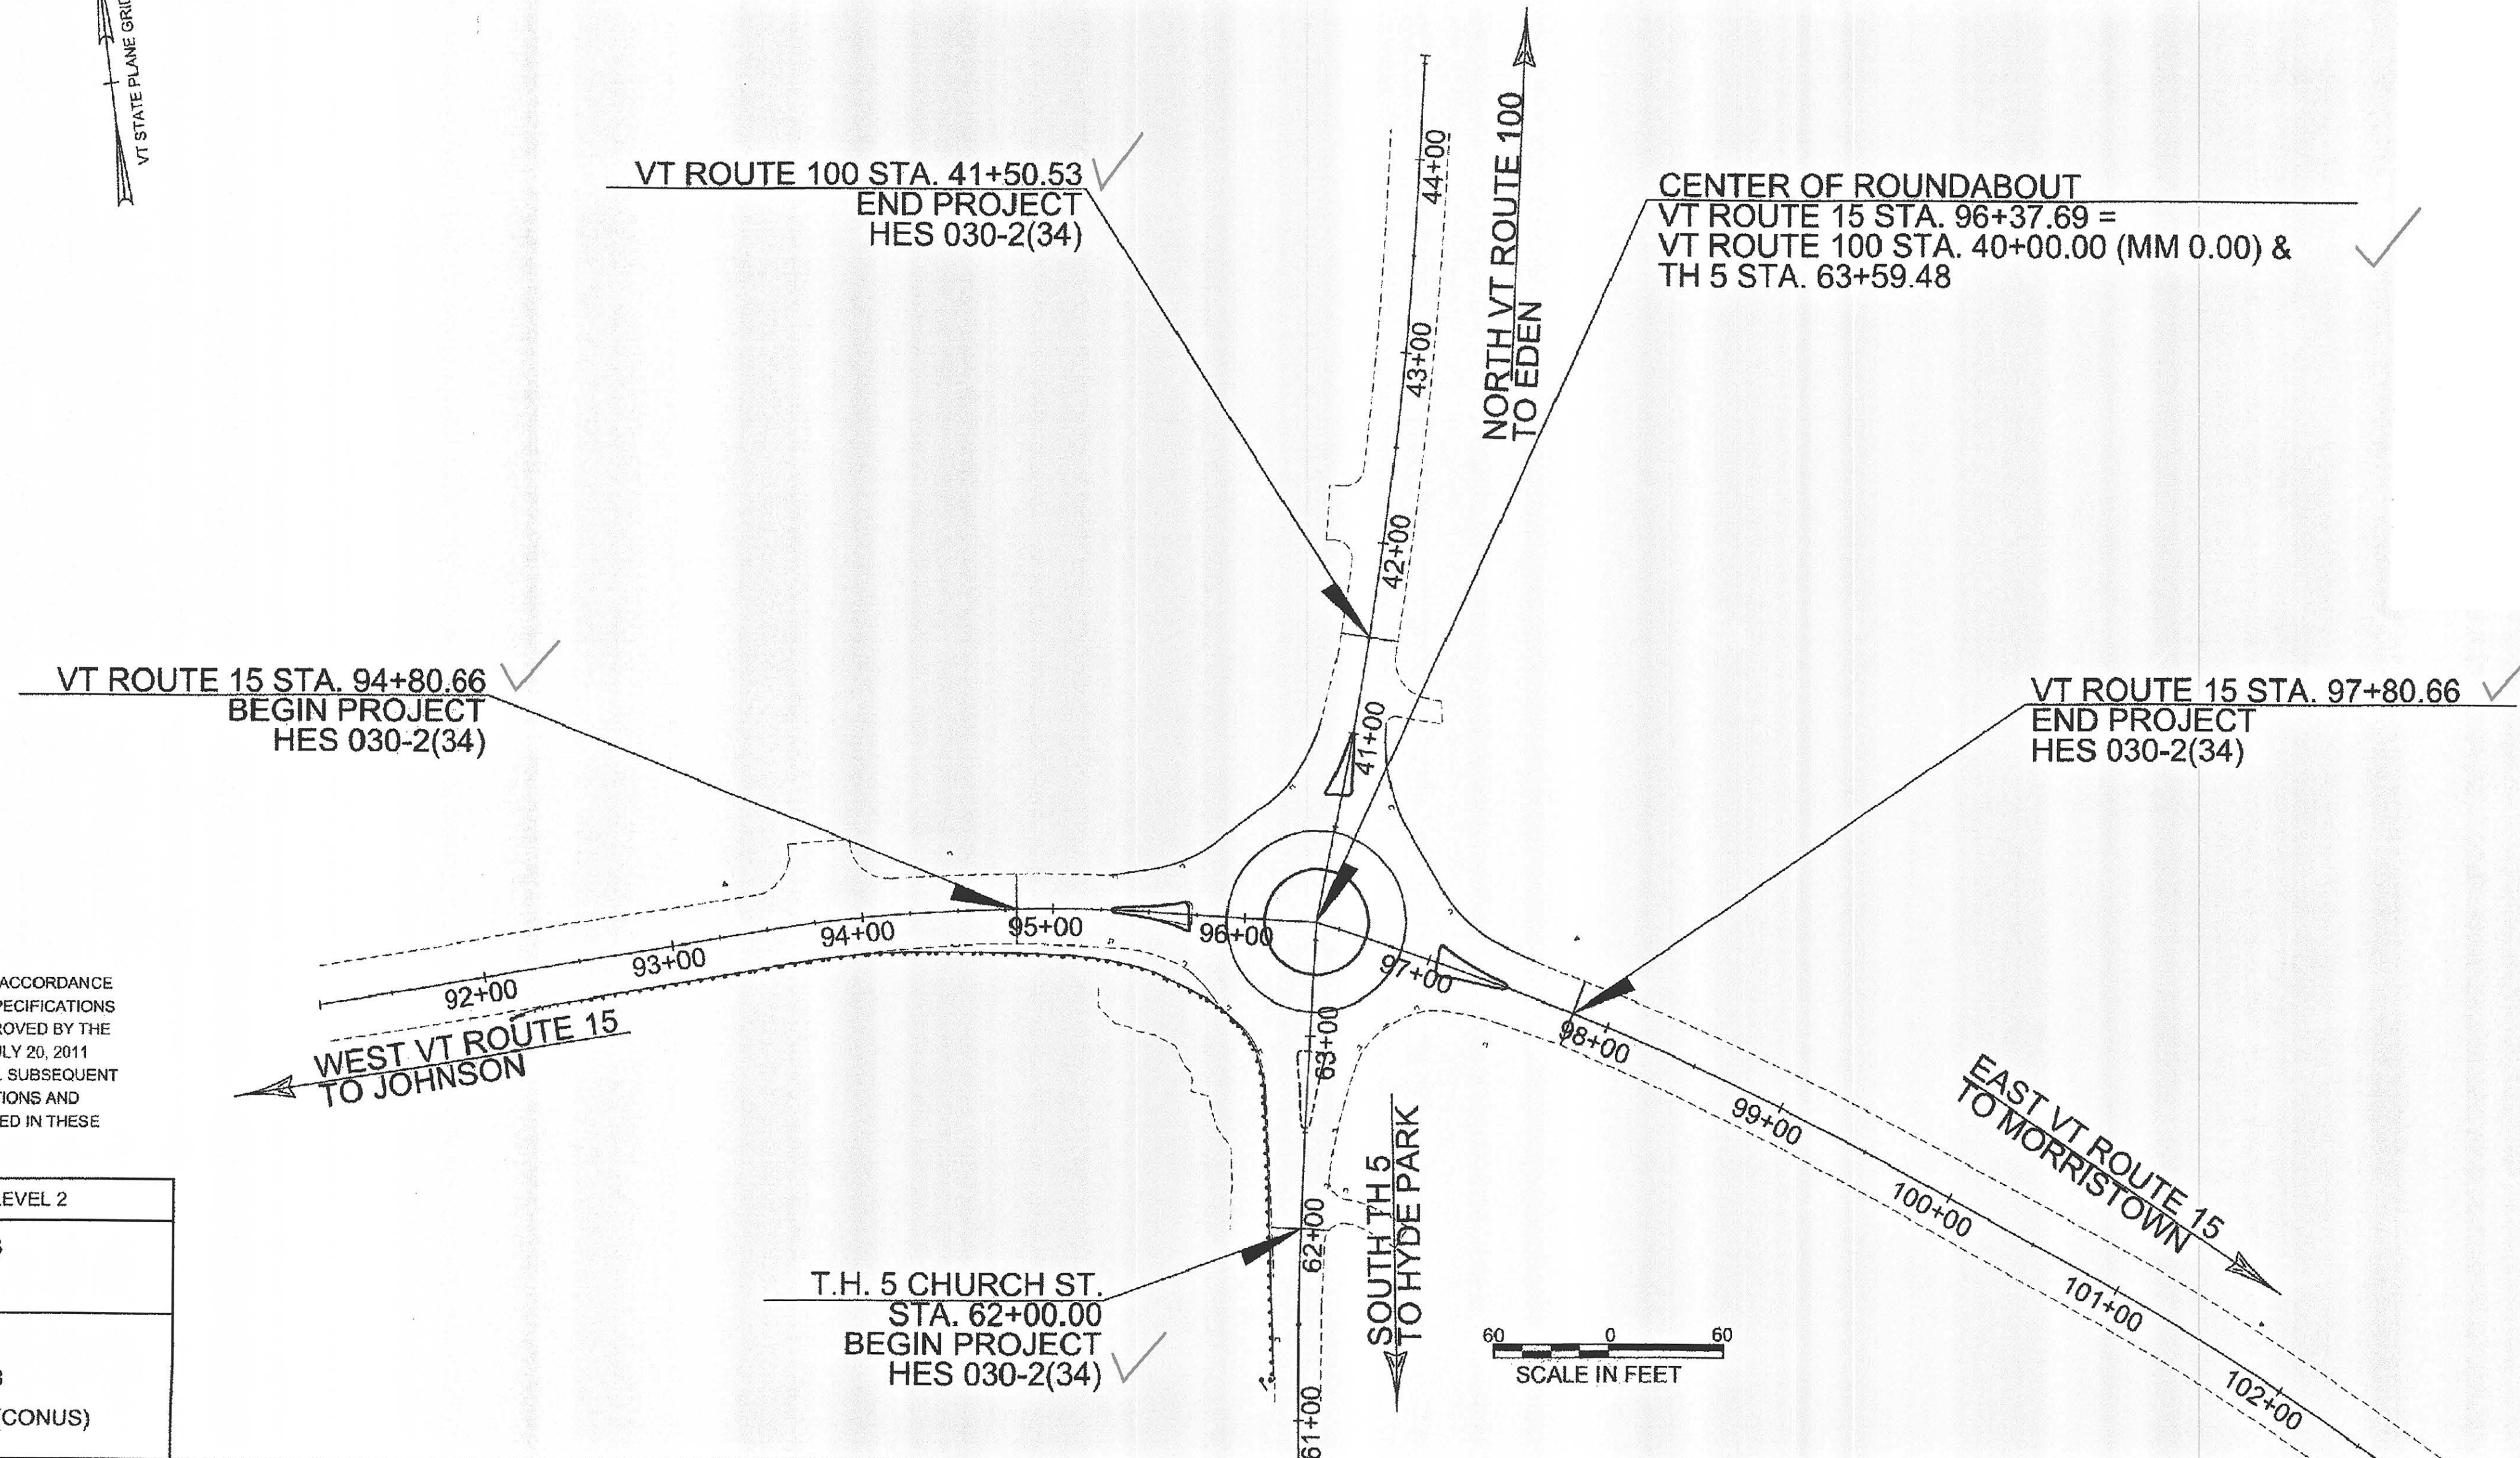

CONSTRUCTION IS TO BE CARRIED ON IN ACCORDANCE WITH THESE PLANS AND THE STANDARD SPECIFICATIONS FOR CONSTRUCTION DATED 2011, AS APPROVED BY THE FEDERAL HIGHWAY ADMINISTRATION ON JULY 20, 2011 FOR USE ON THIS PROJECT, INCLUDING ALL SUBSEQUENT REVISIONS AND SUCH REVISED SPECIFICATIONS AND SPECIAL PROVISIONS AS ARE INCORPORATED IN THESE PLANS.

QUALITY ASSURANCE PROGRAM : LEVEL 2	
SURVEYED BY :	VTRANS
SURVEYED DATE :	1/2013
DATUM	
VERTICAL	NAVD 88
HORIZONTAL	NAD 83 (CONUS)

RECORD PLANS	
CONTRACTOR:	DIRT TECH COMPANY, LLC - JERICO, VT
RESIDENT ENGINEER:	ROBERT SUCKERT
CONSTRUCTION BEGAN:	JUNE 13, 2016
CONSTRUCTION COMPLETE:	OCTOBER 14, 2016
RECORD PLANS BY:	ROBERT SUCKERT & JESSE IVES
I HEREBY CERTIFY THAT ALL THE CONSTRUCTION REQUIRED BY THIS SET OF DRAWINGS HAS BEEN ACCOMPLISHED AS INDICATED HEREIN.	
BY:	<i>Robert Suckert</i> RESIDENT ENGINEER
DATE:	6-20-17
NOTE: Any further information concerning final quantities, amounts or other details relative to this project may be found at Central Files in the electronic archives.	

DIRECTOR OF PROJECT DELIVERY	
APPROVED:	<i>Patti Coburn</i> DATE 11/12/2015
PROJECT MANAGER:	PATTI COBURN, P.E.
PROJECT NAME:	HYDE PARK
PROJECT NUMBER:	HES 030-2(34) RE-ADVERTISED
SHEET 1 OF 26 SHEETS	