

MATERIAL TOLERANCES

MATERIAL ITEM	THICKNESS TOLERANCE (TOTAL DEPTH FOR EACH MATERIAL)
PAVEMENT	± ¼"
SUBBASE	± 1"
SAND BORROW	± 1"

TYPICAL SECTIONS

SEEDING FORMULA

SEE EPSC DETAILS SHEET 1 AND 2 FOR THE SEEDING FORMULA.

GENERAL NOTES


- ALL WORK SHALL BE PERFORMED WITHIN THE LIMITS OF THE EXISTING STATE OF VERMONT AND TOWN OF HYDE PARK RIGHT-OF-WAYS.
- TACK COAT: EMULSIFIED ASPHALT IS TO BE APPLIED AT THE RATE OF 0.080 GAL/SY ON COLD PLANED AND OVERLAYED SURFACES AND AT A RATE OF 0.025 TO 0.040 GAL/SY BETWEEN SUCCESSIVE COURSES OF PAVEMENT AS DIRECTED BY THE ENGINEER.

COLD PLANE PAVEMENT REQUIREMENTS**

- 1½" SUPERPAVE BITUMINOUS CONCRETE PAVEMENT (TYPE IIIS, WEARING)
- ½" SUPERPAVE BITUMINOUS CONCRETE PAVEMENT (TYPE IIS, LEVELING)

FULL DEPTH PAVEMENT REQUIREMENTS*


- 1¾" SUPERPAVE BITUMINOUS CONCRETE PAVEMENT (TYPE IIIS)
- 3¾" SUPERPAVE BITUMINOUS CONCRETE PAVEMENT (TYPE IIS)
- 3¾" SUPERPAVE BITUMINOUS CONCRETE PAVEMENT (TYPE IIS)

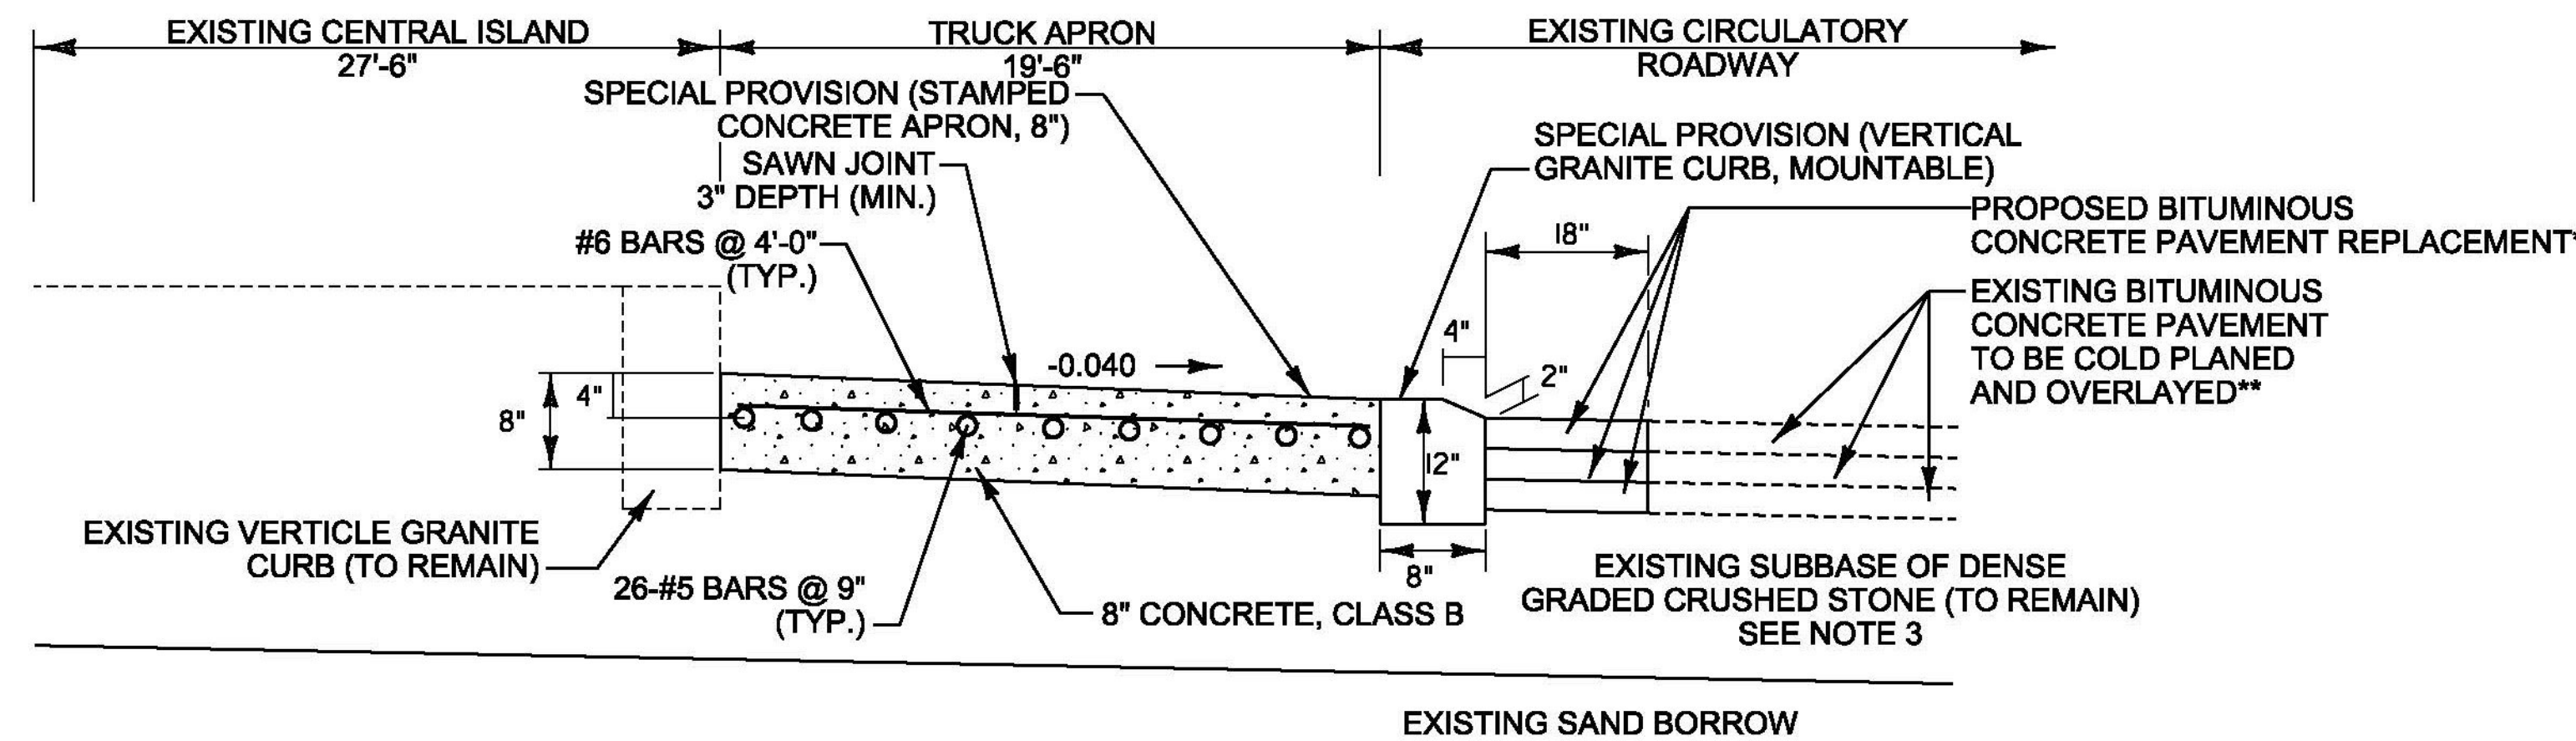

NOTE:

- ALL REINFORCING STEEL SHALL BE LEVEL II DUAL COATED AND PAID FOR UNDER CONTRACT ITEM 507.12.
- THE COLOR OF THE CONCRETE AGGREGATE SHALL MATCH THAT OF THE COLORED CONCRETE.
- THE SURFACE OF THE DENSE GRADED CRUSHED STONE SHALL BE ROUGHENED AND PREPARED TO CONSTRUCT THE CONCRETE TRUCK APRON.

TRUCK APRON DETAIL
NOT TO SCALE

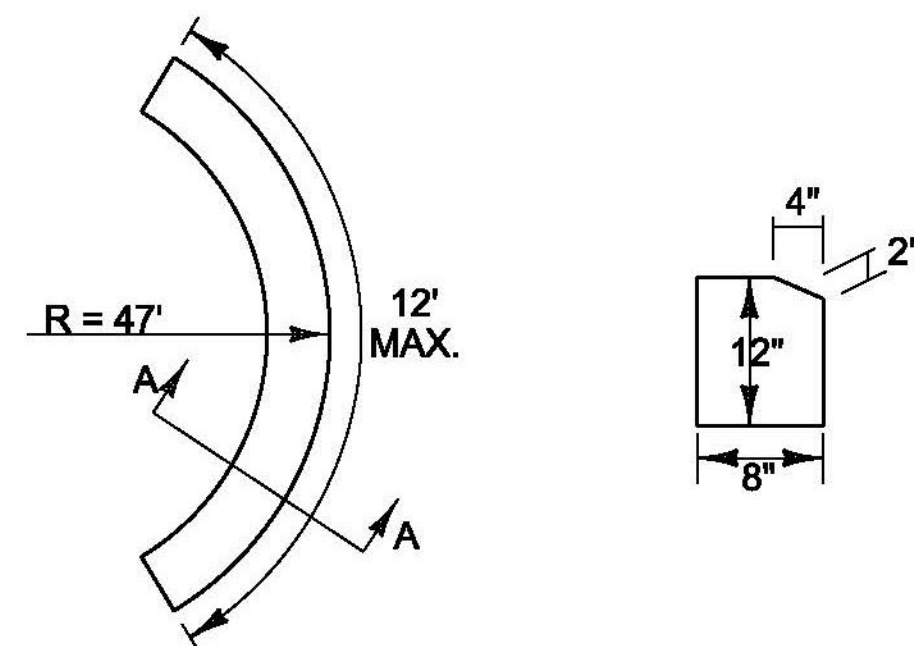


PLAN

SECTION A-A


NOTE:

- MOUNTABLE CURBING WILL BE PAID FOR UNDER CONTRACT ITEM 900.640 - SPECIAL PROVISION (VERTICAL GRANITE CURB, MOUNTABLE).

VERTICAL GRANITE CURB, MOUNTABLE, DETAIL
NOT TO SCALE

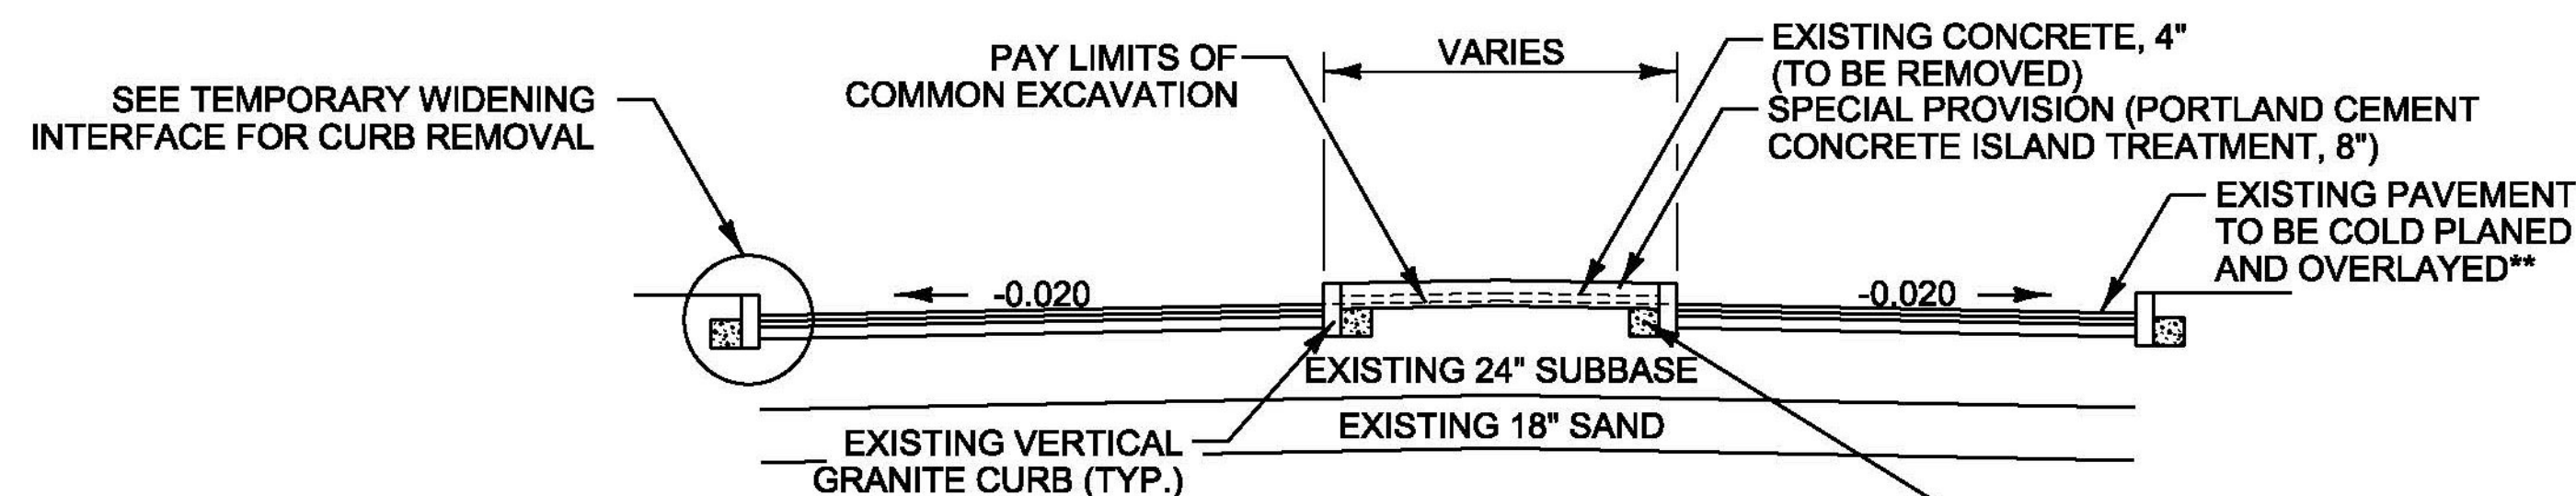


SPLITTER ISLAND DETAIL
NOT TO SCALE

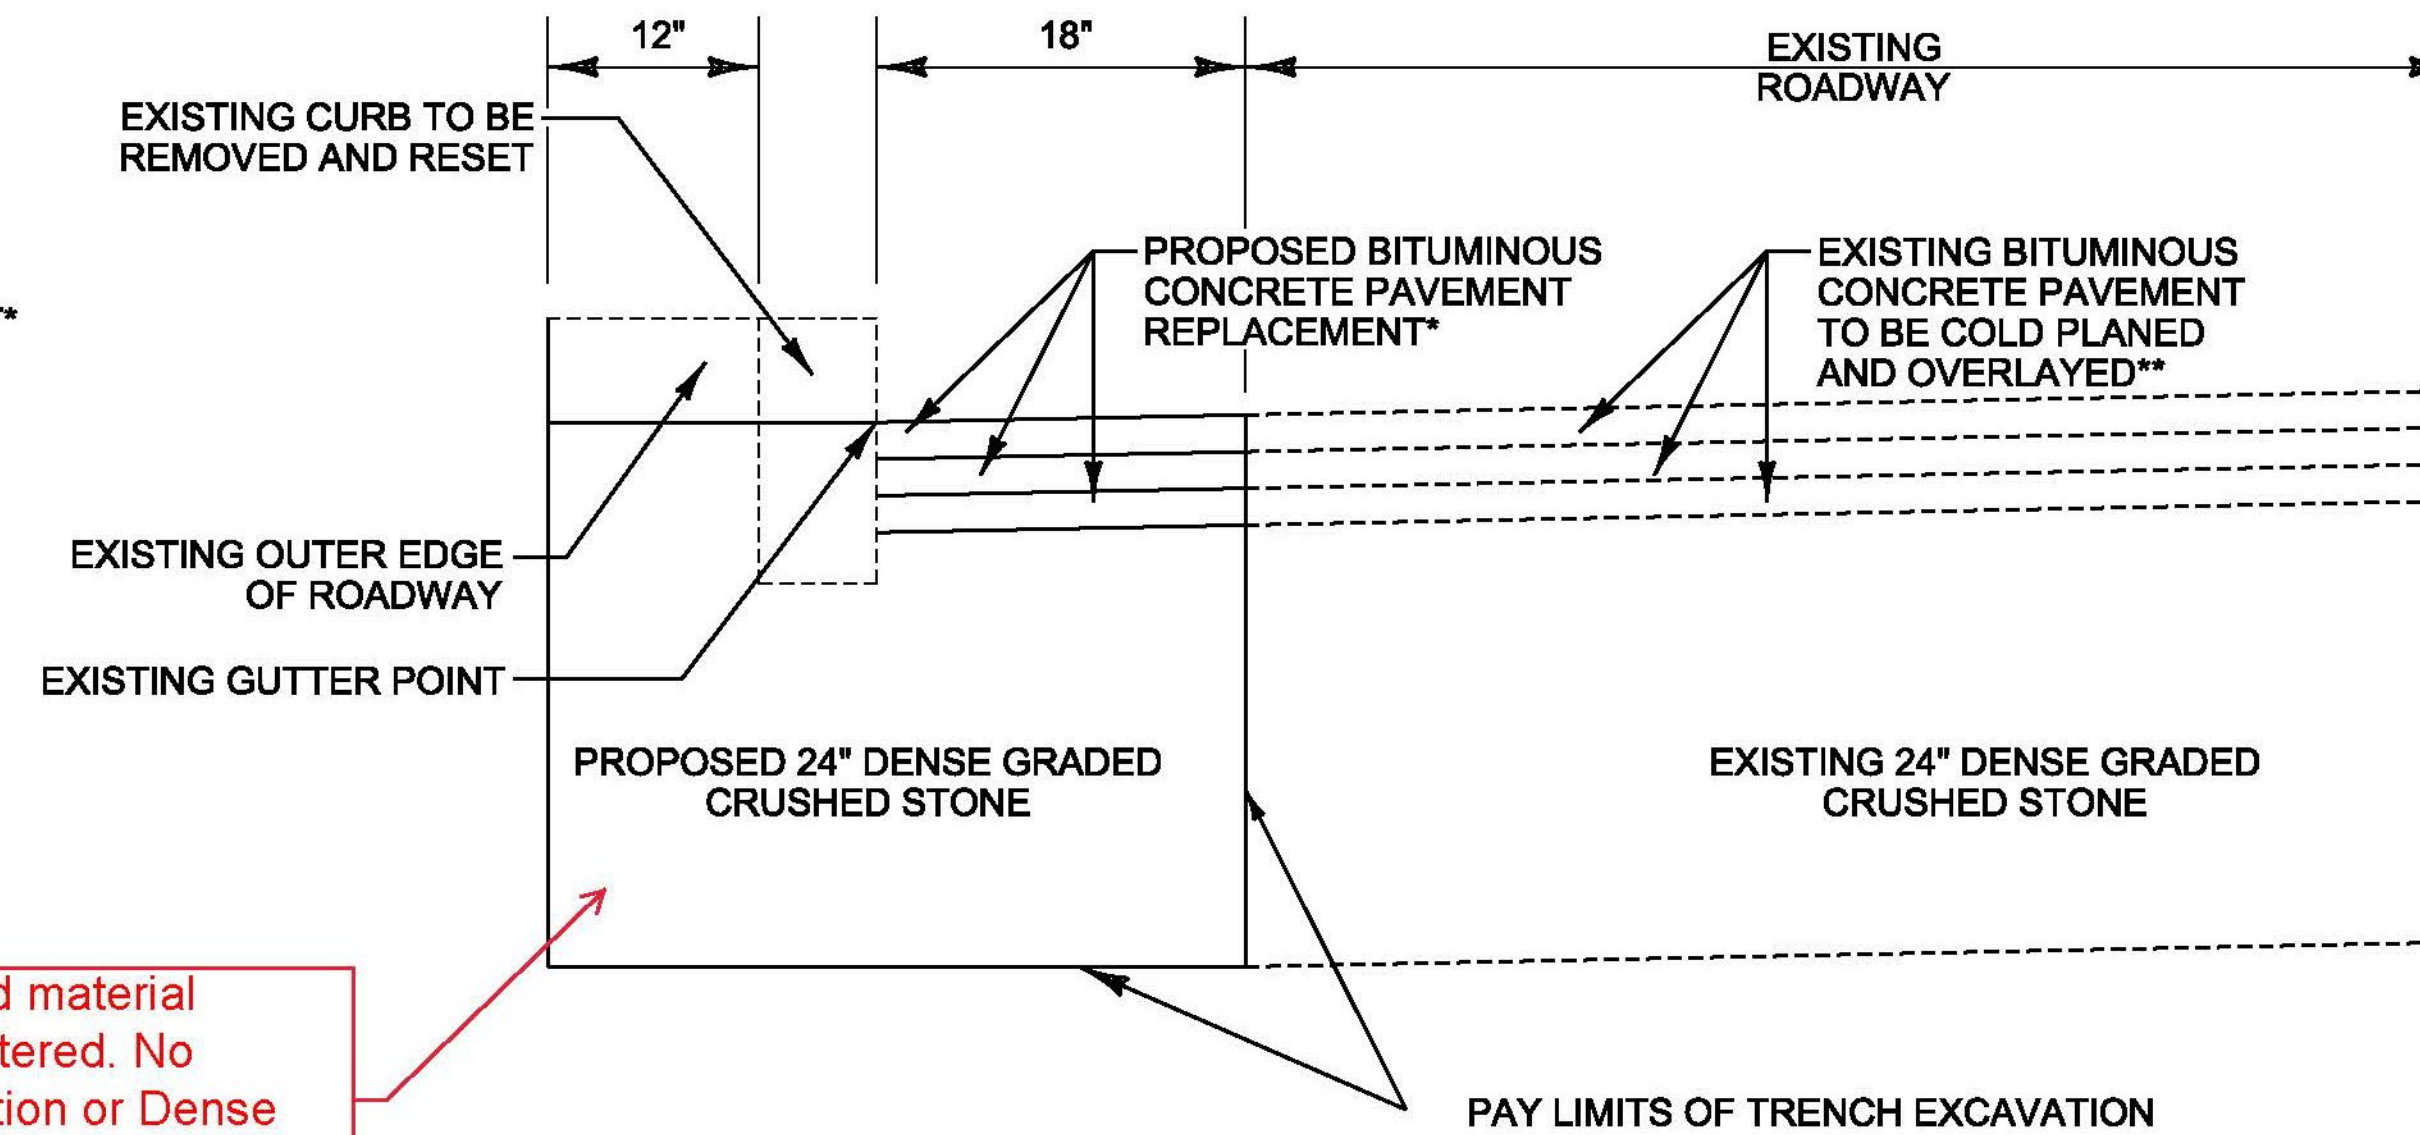


All good material encountered. No excavation or Dense Graded required.

TEMPORARY WIDENING INTERFACE
NOT TO SCALE

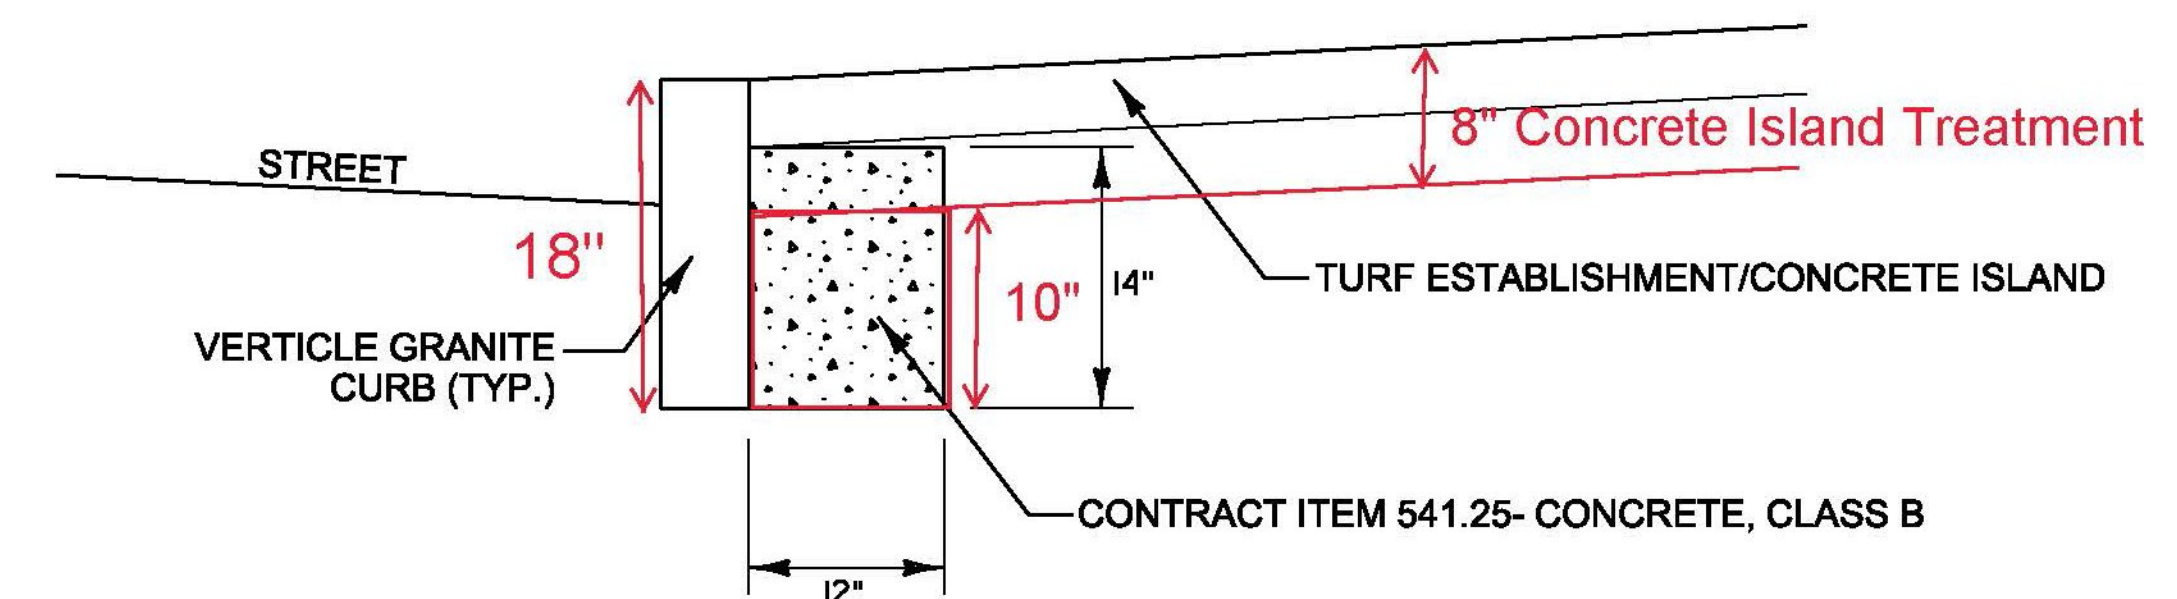

CONCRETE BEHIND CURB DETAIL
NOT TO SCALE

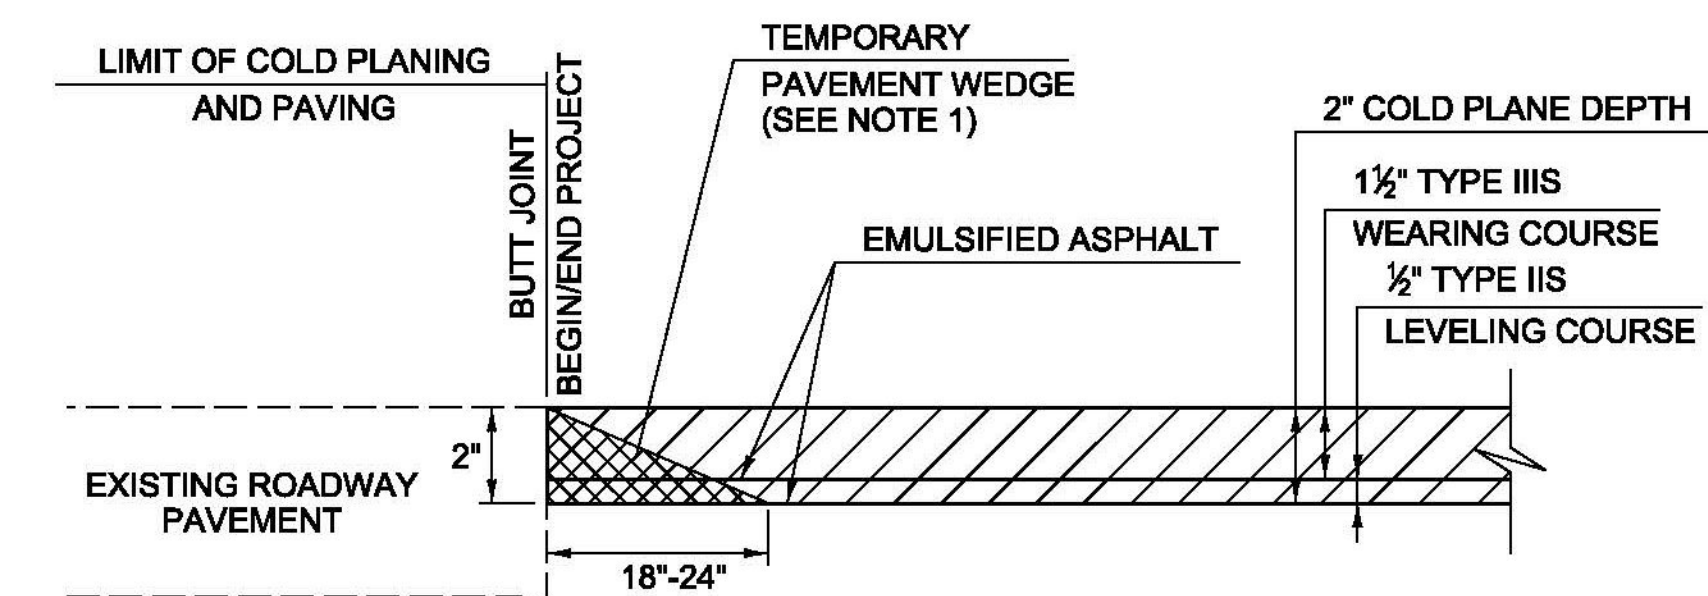

COLD PLANE AREA DETAIL
NOT TO SCALE

NOTE:

- TEMPORARY PAVEMENT WEDGE SHALL BE REMOVED PRIOR TO PAVING. COST TO BE CONSIDERED INCIDENTAL TO SPECIAL PROVISION (BITUMINOUS CONCRETE PAVEMENT, SMALL QUANTITY).

PROJECT NAME: HYDE PARK
PROJECT NUMBER: HES 030-2(34)

FILE NAME: t14b104frm.dgn
PROJECT LEADER: P. COBURN
DESIGNED BY: M. BOGACZYK
TYPICAL SECTIONS SHEET

PLOT DATE: 11/12/2015
DRAWN BY: M. BOGACZYK
CHECKED BY: M. LACROIX
SHEET 4 OF 26