


LEGEND

REVEGETATED AREAS
(SEED, MULCH, LIME, FERTILIZER)

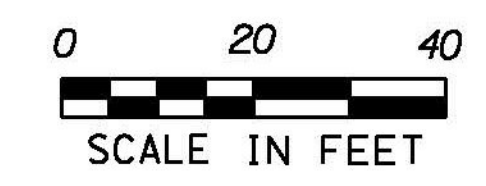

PROJECT NAME:	HYDE PARK	PLOT DATE:	11/12/2015	
PROJECT NUMBER:	HES 030-2(34)	DRAWN BY:	M. BOGACZYK	
FILE NAME:	t14b104ero.dgn	DESIGNED BY:	M. BOGACZYK	
PROJECT LEADER:	P. COBURN	EPSC - POST CONSTRUCTION PLAN	CHECKED BY:	M. LaCROIX
			SHEET	14 OF 26