

SPECIAL PROVISION (VERTICAL GRANITE CURB, MOUNTABLE)
 STA. 80+00.00, -18.00' LT - 84+08.32, -18.00' LT (TRUCK APRON)

Item not needed.

CLEANING DROP INLETS (SEE NOTE 3)

- STA. 40+65.06, 26.00' RT
- STA. 40+65.69, 25.27' LT
- STA. 62+22.58, 11.58' RT
- STA. 62+51.37, 14.58' RT
- STA. 62+90.86, 24.99' LT
- STA. 62+95.54, 24.95' RT
- STA. 95+31.18, 15.53' RT
- STA. 95+31.93, 15.68' LT
- STA. 95+66.13, 23.35' LT
- STA. 95+70.69, 24.74' RT
- STA. 95+95.08, 46.40' RT
- STA. 97+01.38, 26.47' LT
- STA. 97+01.44, 25.23' RT

VT ROUTE 15 STA. 94+80.66
 BEGIN PROJECT
 HES 030-2(34)

VT ROUTE 100 STA. 41+50.53
 END PROJECT
 HES 030-2(34)

CENTER OF ROUNDABOUT
 VT ROUTE 15 STA. 96+37.69 =
 VT ROUTE 100 STA. 40+00.00 (MM 0.00) =
 TH 5 STA. 63+59.48

VT ROUTE 15 STA. 97+80.66
 END PROJECT
 HES 030-2(34)

NOTES

1. ALL EXISTING LUMINAIRES SPECIFIED FOR SALVAGE TO REMAIN THE PROPERTY OF THE STATE OF VERMONT. SEE SPECIAL PROVISIONS FOR ADDITIONAL INFORMATION AND REQUIREMENTS.
2. REMOVAL OF WEST, NORTH AND EAST SPLITTER ISLANDS TO BE PAID FOR UNDER CONTRACT ITEM 203.16 - SOLID ROCK EXCAVATION.
3. EXISTING DROP INLETS SHALL BE CLEANED PRIOR TO ACCEPTANCE OF THE PROJECT IN ACCORDANCE WITH SUBSECTION 104.07. PAYMENT WILL BE CONSIDERED INCIDENTAL TO THE CONTRACT.

T.H. 5 STA. 62+00.00
 BEGIN PROJECT
 HES 030-2(34)

SALVAGE EXISTING HPS LUMINAIRES

- STA. 95+37.41, 22.88' RT
- STA. 95+88.35, 47.69' RT
- STA. 95+93.07, 52.14' LT
- STA. 96+84.80, 49.61' LT
- STA. 96+92.38, 41.67' RT
- STA. 97+41.03, 20.73' RT

REMOVING AND RESETTING LIGHT POLE

- STA. 95+93.07, 52.14' LT
- STA. 96+84.80, 49.61' LT

SPECIAL PROVISION (LUMINAIRE, LED RETROFIT)

- STA. 95+37.41, 22.88' RT
- STA. 95+88.35, 47.69' RT
- STA. 95+93.07, 52.14' LT
- STA. 96+84.80, 49.61' LT
- STA. 96+92.38, 41.67' RT
- STA. 97+41.03, 20.73' RT

SPECIAL PROVISION (STAMPED CONCRETE APRON, 8 INCH)


TRUCK APRON - 95+90.72 TO 96+84.31

SPECIAL PROVISION (PORTLAND CEMENT CONCRETE ISLAND TREATMENT, 8 INCH)

- WEST ISLAND - STA. 95+31.16 TO STA. 95+71.34
- NORTH ISLAND - STA. 40+66.43 TO STA. 41+00.03
- EAST ISLAND - STA. 97+03.69 TO STA. 97+42.39

REMOVING AND RESETTING CURB

- STA. 95+30.66 TO STA. 41+02.36
- STA. 41+06.44 TO STA. 97+53.25
- WEST ISLAND - STA. 95+31.16 TO STA. 95+71.34
- NORTH ISLAND - STA. 40+66.43 TO STA. 41+00.03
- EAST ISLAND - STA. 97+03.69 TO STA. 97+42.39

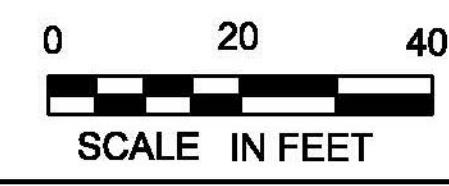

PROJECT NAME:	HYDE PARK	PLOT DATE:	11/12/2015
PROJECT NUMBER:	HES 030-2(34)	DRAWN BY:	M. BOGACZYK
FILE NAME:	t14b104nui.dgn	DESIGNED BY:	M. BOGACZYK
PROJECT LEADER:	P. COBURN	CHECKED BY:	M. LACROIX
GENERAL PLAN		SHEET	15 OF 26

