

VT ROUTE 100 STA. 41+50.53
END PROJECT
HES 030-2(34)
BEGIN APPROACH

CENTER OF ROUNDABOUT
VT ROUTE 15 STA. 96+37.69 =
VT ROUTE 100 STA. 40+00.00 (MM 0.00) =
TH 5 STA. 63+59.48


VT ROUTE 15 STA. 94+80.66
BEGIN PROJECT
HES 030-2(34)
END APPROACH

VT ROUTE 15 STA. 97+80.66
END PROJECT
HES 030-2(34)
BEGIN APPROACH

POINT NUMBER	STATION	OFFSET	LOCATION	ELEVATION
A1	95+90.48	0.00	CL	708.46
A2	40+47.23	0.00	CL	709.96
A3	96+84.69	0.00	CL	709.88
A4	63+12.48	0.00	CL	708.40
B1	96+10.19	0.00	CL	709.65
B2	40+27.50	0.00	CL	710.45
B3	96+65.19	0.00	CL	710.42
B4	63+31.98	0.00	CL	709.15
C1	95+30.66	0.00	CL	705.60
C2	95+71.44	8.97	RT	707.98
C3	95+61.18	6.02	LT	707.86
C4	95+28.88	17.46	LT	705.11
C5	95+93.81	48.08	LT	709.59
C6	41+02.36	17.75	LT	710.56
C7	41+00.53	0.00	CL	711.47
C8	40+66.33	8.68	LT	709.71
C9	40+68.62	4.86	RT	709.74
C10	41+06.44	16.50	RT	710.81
C11	96+82.24	47.77	LT	710.83
C12	97+53.25	18.29	LT	710.74
C13	97+03.73	9.00	LT	710.17
C14	97+06.00	5.86	RT	709.64
C15	97+42.89	0.00	CL	710.70

NOTE: STATIONS, OFFSETS AND ELEVATIONS OF CURB POINTS ARE AT THE GUTTER POINT.

T.H. 5 STA. 62+00.00
END APPROACH
BEGIN PROJECT
HES 030-2(34)

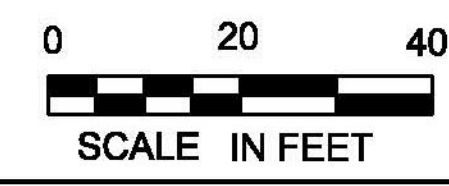

PROJECT NAME:	HYDE PARK	PLOT DATE:	11/12/2015
PROJECT NUMBER:	HES 030-2(34)	DRAWN BY:	M. BOGACZYK
FILE NAME:	t14b104nui.dgn	DESIGNED BY:	M. BOGACZYK
GRADING PLAN		CHECKED BY:	M. LaCROIX
			SHEET 16 OF 26